

23. 5. 95
24. 5. 95
23. 3. 96 (No. 396)
6. 5. 96 (No. 397)
14. 5. 96 do.
24. 9. 96 (No. 401)
13. 10. 96 (No. 404)
27. 10. 96 (No. 408)

No. 381. "Venus."

LONGITUDINAL + DECK PLANS

S. S. n° 381

SCALE $\frac{1}{8}$ INCH = ONE FOOT

* hrs: 396 397 * ho: 401 * ho: 404 * ho: 408


appo. 23/3/96 appo. 24/9/96 appo. 13/10/96 appo. 27/10/96




FORE & MAIN MASTS 2 PLATES IN THE ROOF

BUTTS LAPPED 3" ABOVE DECK 2" BELOW

SEAMS LAPPED & S.R.


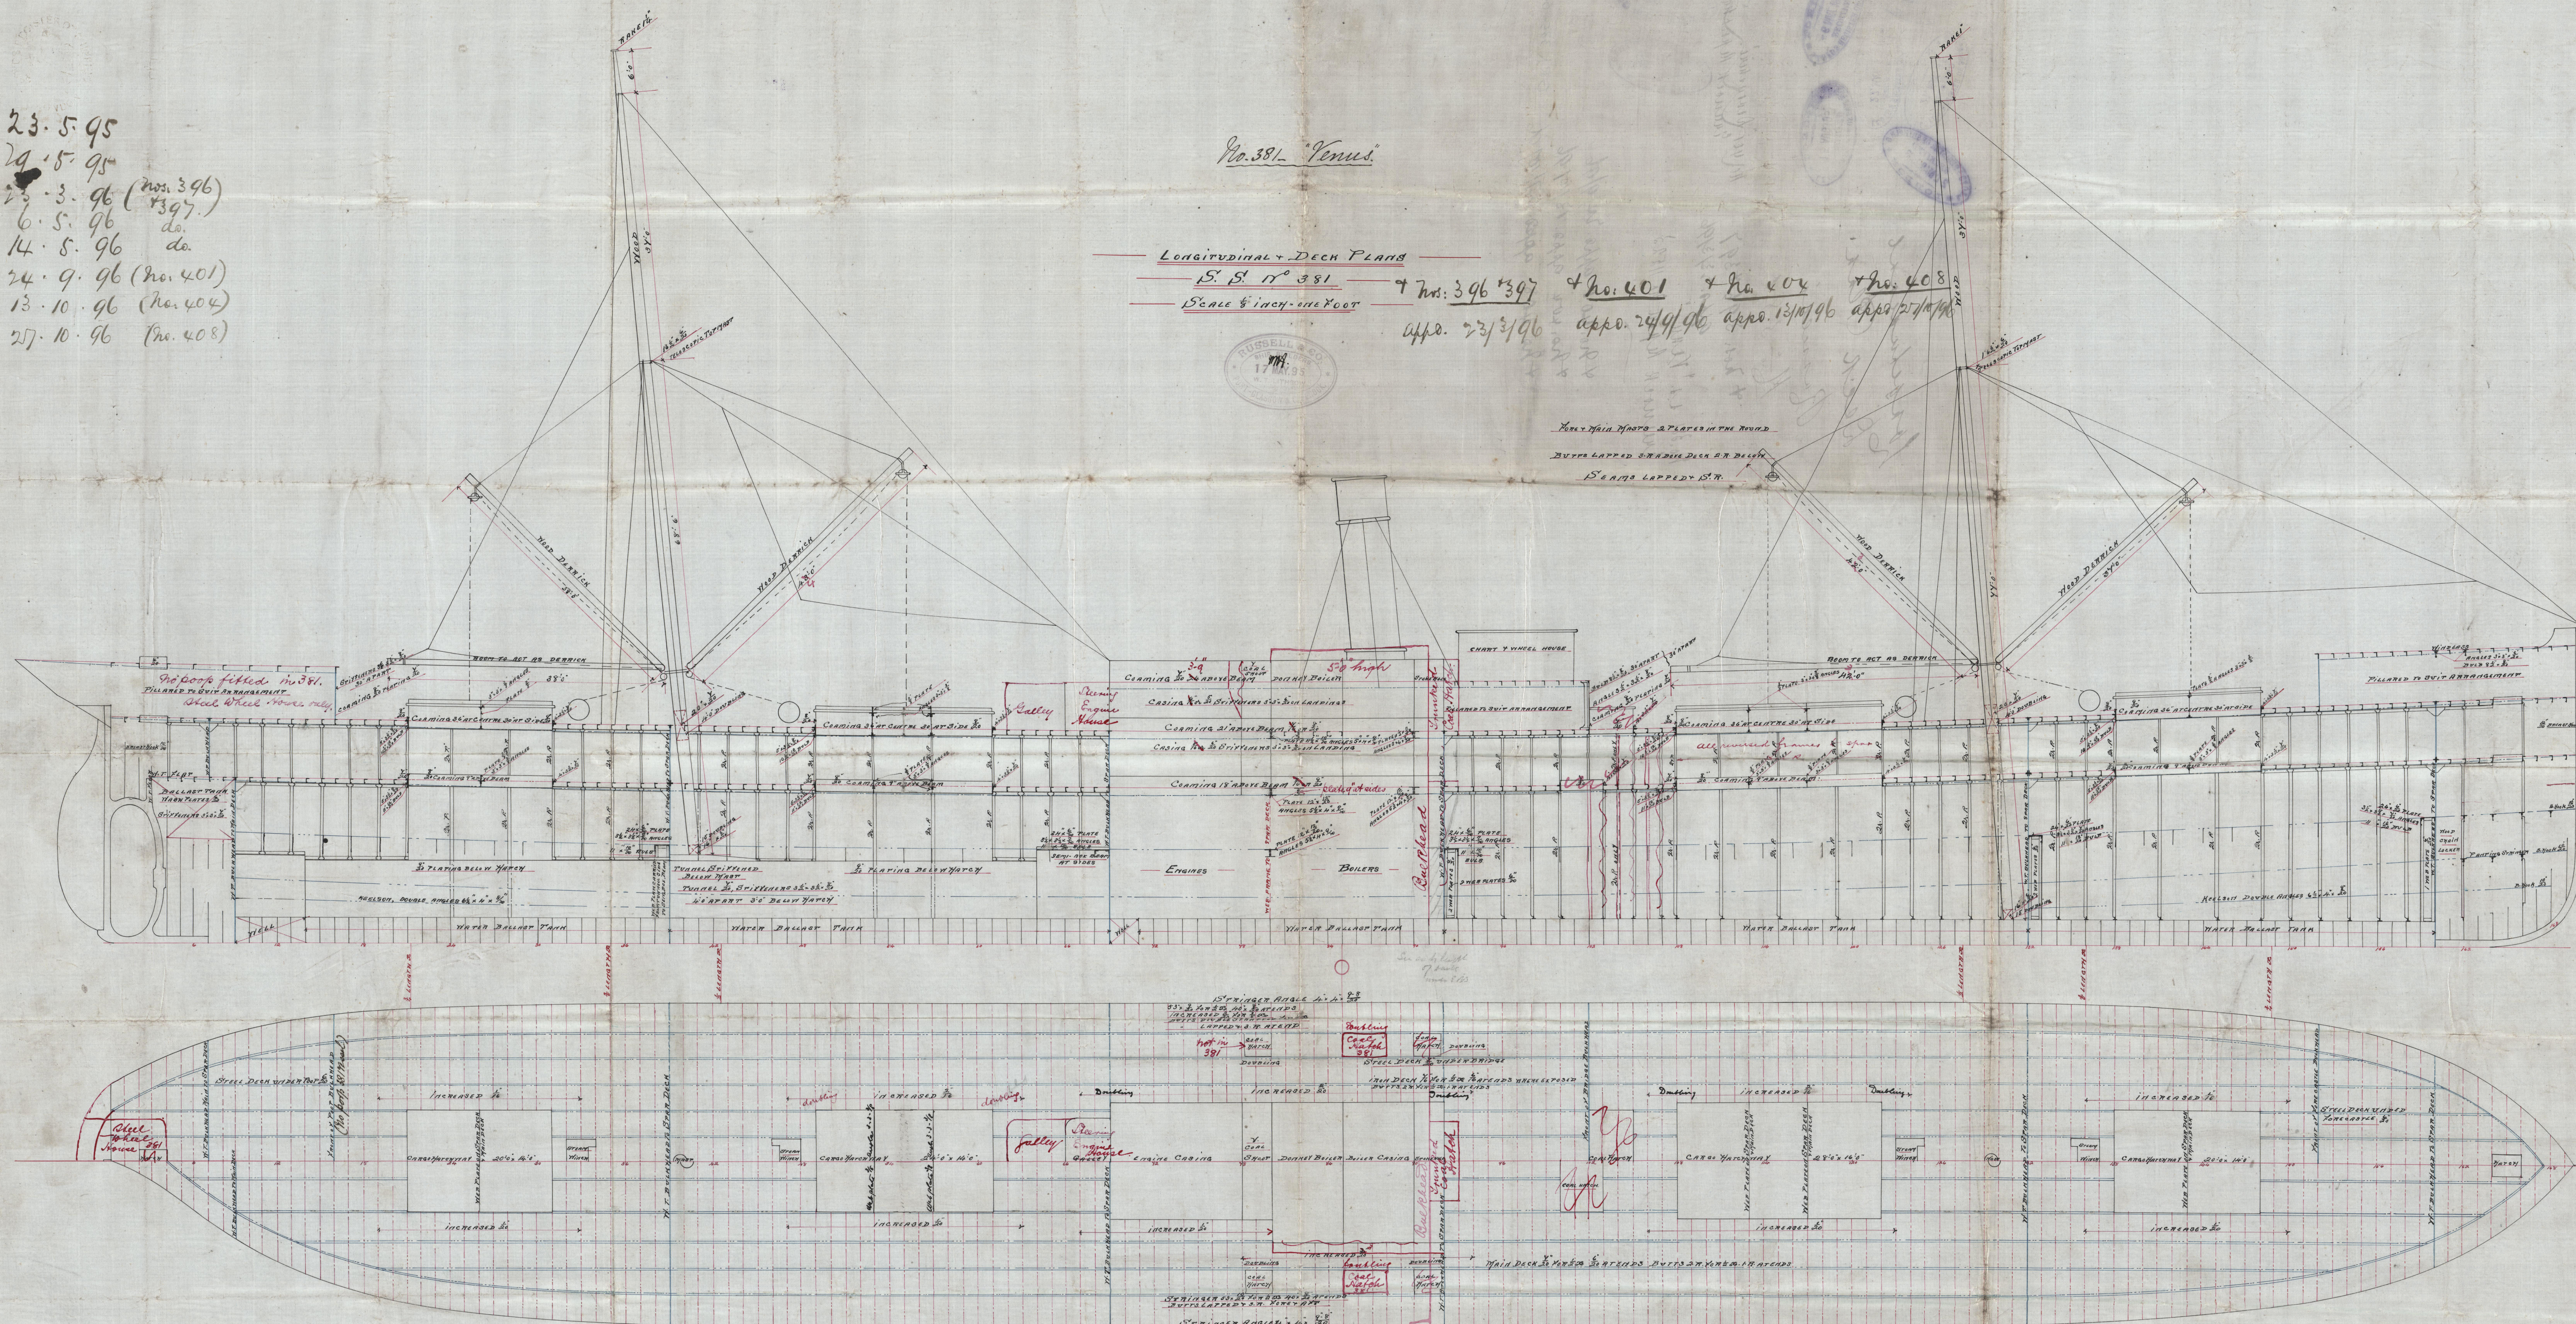


No Poop in 38!

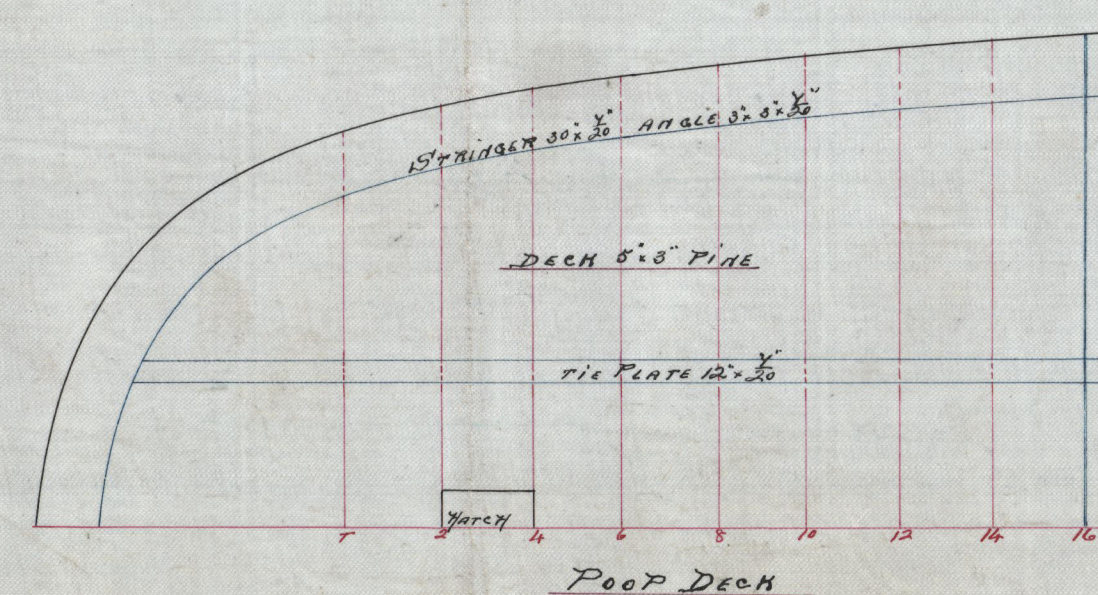

NOTE — POOP MAY NOT BE FITTED

23/5/95
24.9.96
13.10.96

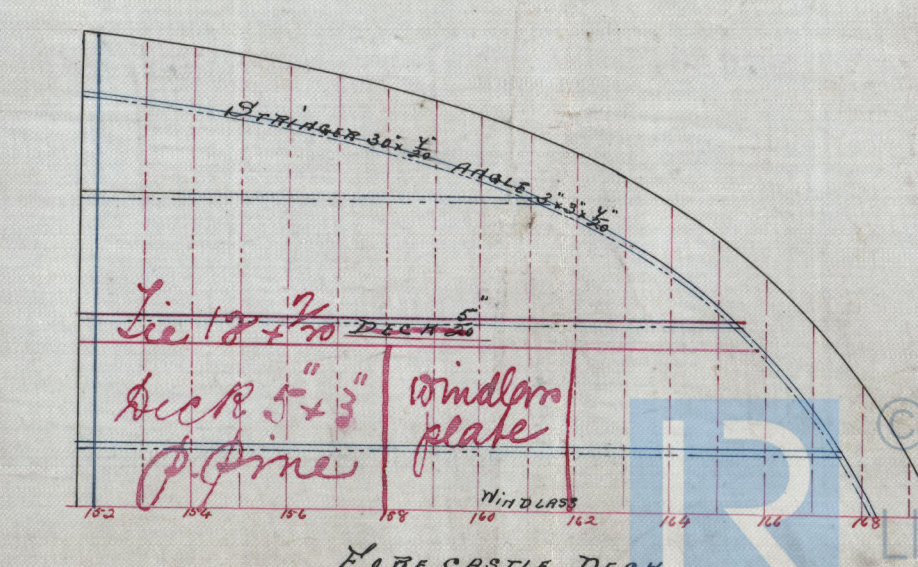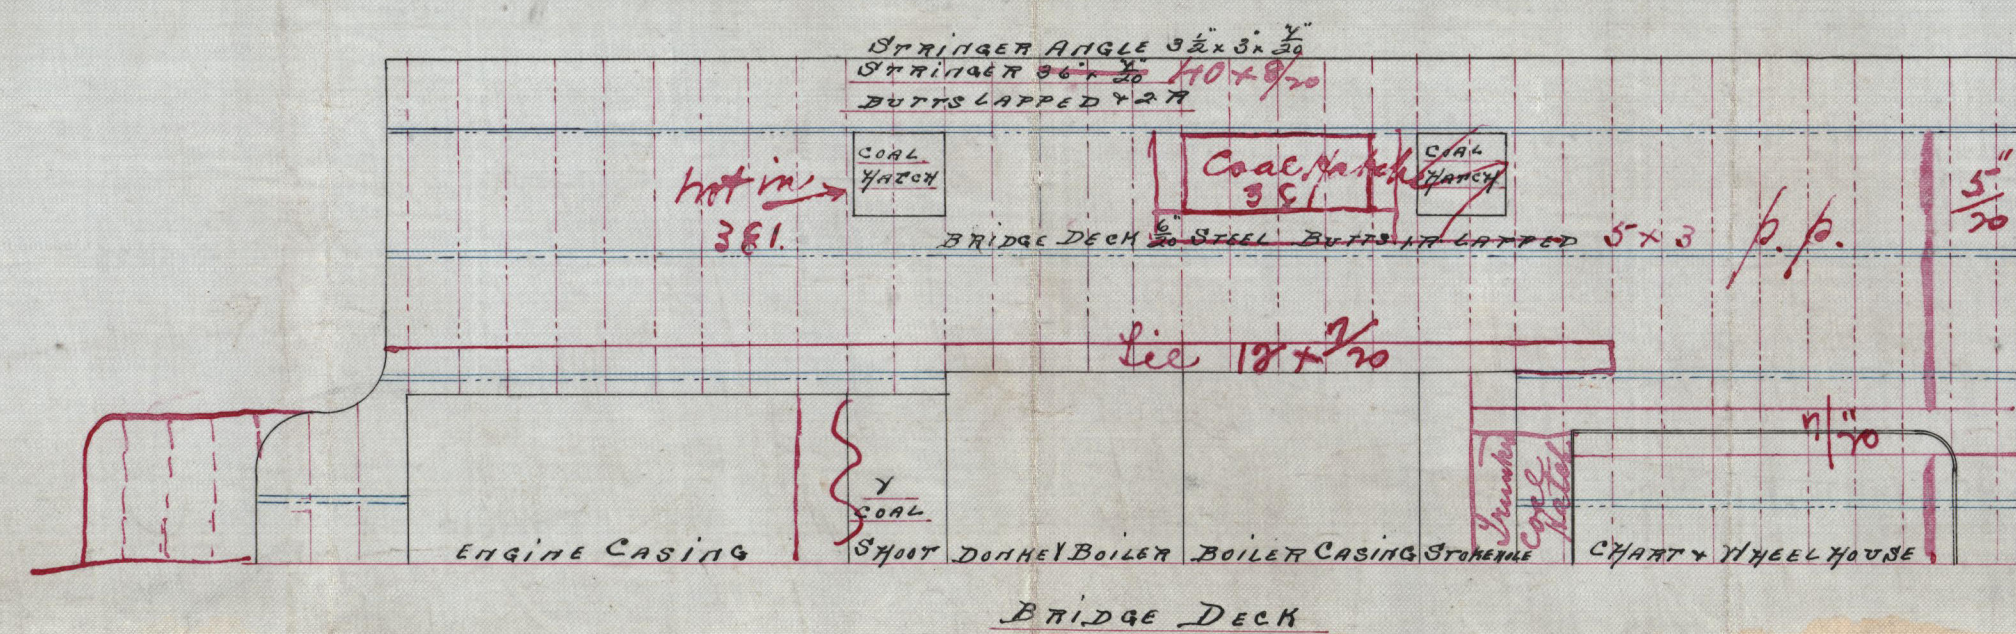

Longitudinal
Deck Plan

Russell

No. 381

+ nos. 396 + 397
appd. 23/3/96




No. 381 i.s. "Venus"
Greenock Report No. 11523

+ No. 401 appd. 24/9/96

+ No. 404 appd. 13/10/96

+ No. 408 appd. 27/10/96

GRK 335-0056

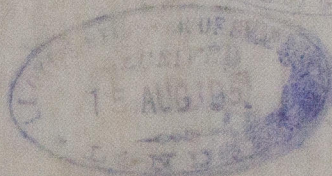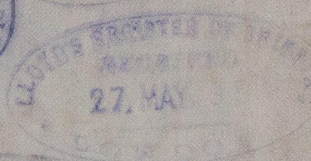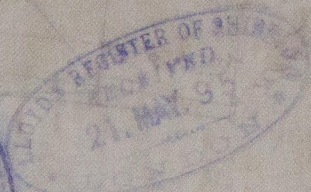

No. 401 "Venus"
Greenock Report No. 11523



© 2020

Lloyd's Register
Foundation