

Lloyd's Register of British and Foreign Shipping.

(Report on Vessel No. 11523 Port Glasgow
as "Venus")No. 4982 SHIP FORGINGS OR CASTINGS.

I have to report that the undermentioned Iron or Steel Forgings or Castings,
 manufactured by The Portland Forge Coy
 of Kilmarnock for the Vessel No. 381, being built
 by Messrs Russell & Coy of Port Glasgow
 have been inspected by me as set forth below, and found to be, so far as can be seen,
Sound & efficient


Mark on Forgings.

Lloyd's
No.

William Hamilton
Glasgow 10/4/96

	STERN FRAME.	RUDDER FRAME.	STEM.
Material* ...	<u>Scrap iron</u> <u>Forged</u> <u>11x6</u> <u>Forging & smithing</u> <u>2/8/95 to 28/12/95</u>		
How made ...			
Dimensions ...			
Progress on Inspection			
Date when Inspected			

SKETCHES OF FRAMES SHOWING POSITION AND DESCRIPTION OF WELDS OF FORGINGS, OR PARTICULARS OF TESTS APPLIED TO CASTINGS.

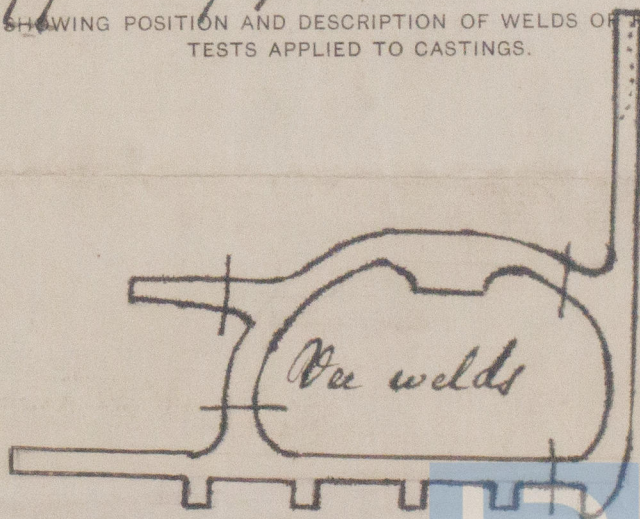

Fee (if any chargeable) £

To be paid at

* If of Iron, state whether scrap or puddled Iron. G.R. 335 0517