


№ 234

MIDSHIP SECTION OF TWIN SCREW STEAMER

TO CLASS 90 A AT LLOYDS

== DIM^{N.S.} 220' x 36' x 14'-0" M^{L.D.} ==

== SCALE $\frac{1}{2}$ INCH \approx ONE FOOT ==

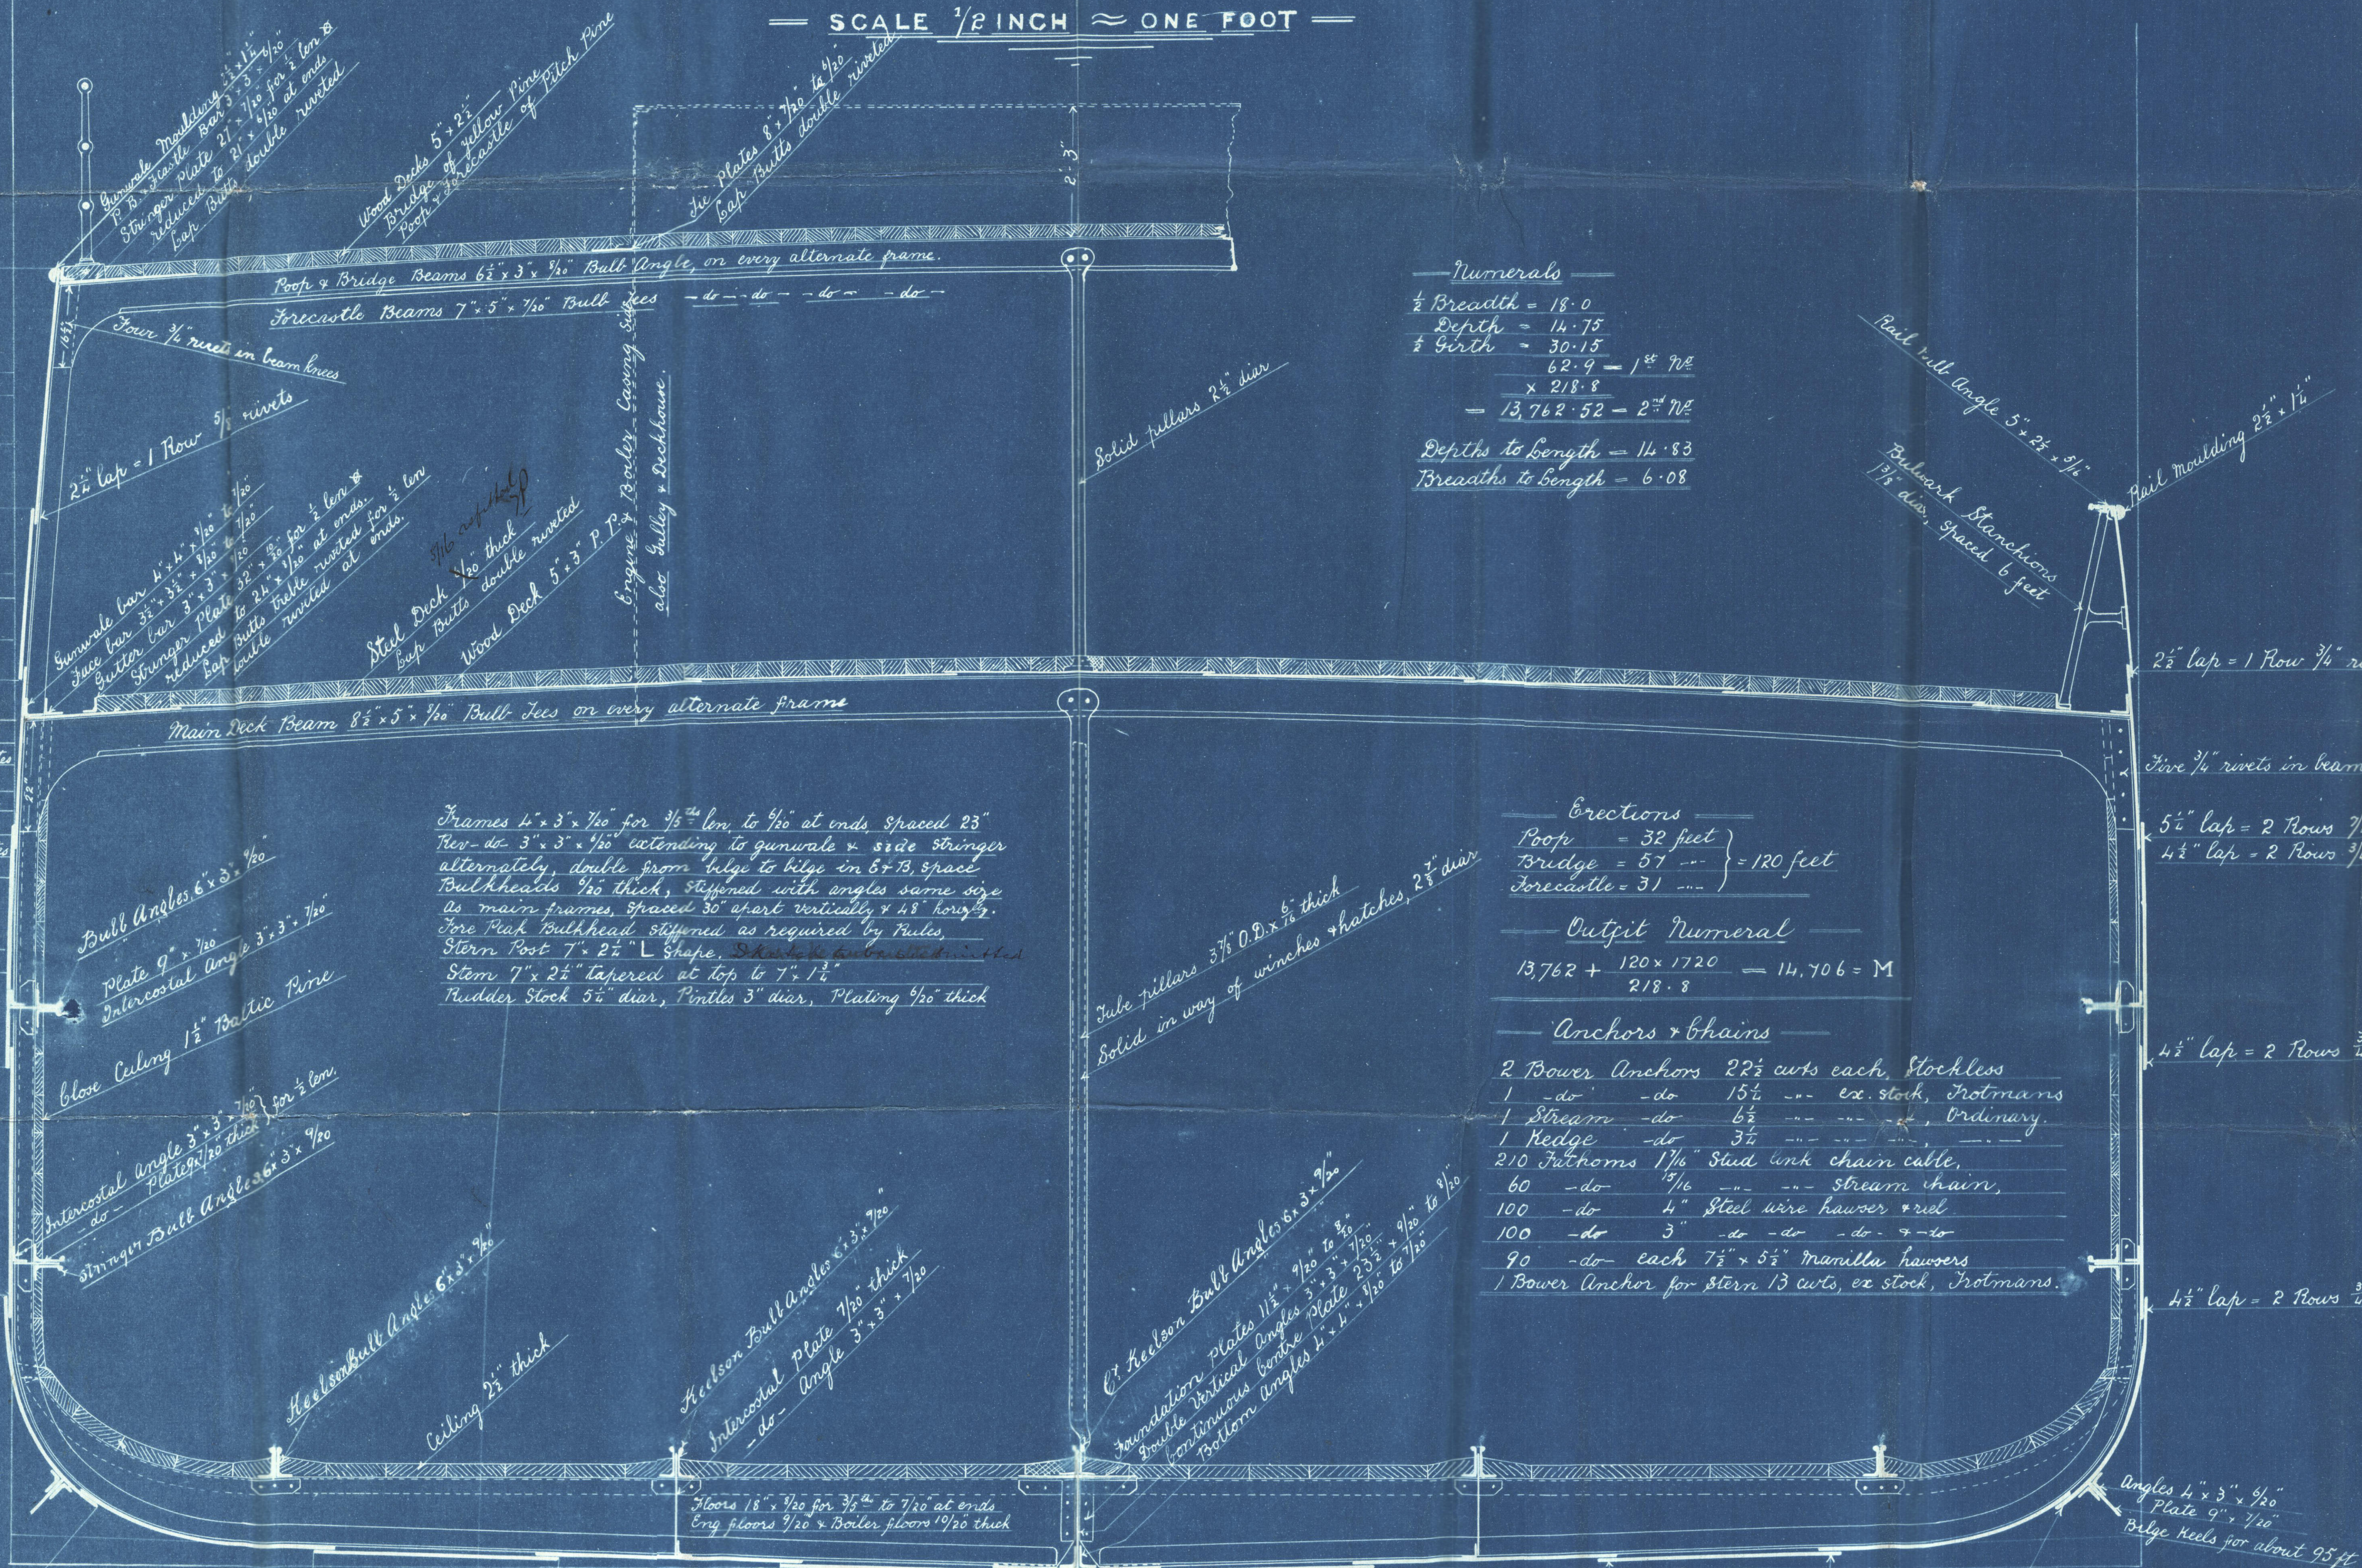

DAVID J. DUNLOP & CO.,

ENGINEERS & SHIPBUILDERS




PORT GLASGOW

s.s. "Idolin."

Greenock Report

no. 11539

GRR 335-0083

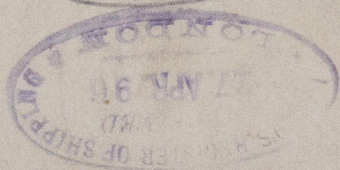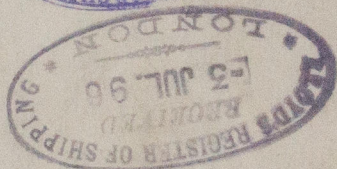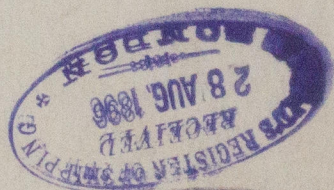

London
J. B. Mearns & Co. No. 114 Midship Section



© 2020
Lloyd's Register
Foundation