



23.3.96

DAVID & DUNLOP & CO  
ARCHITECTS & ENGINEERS  
24 MAR 96  
INCH WORKS  
PORT-GLASGOW

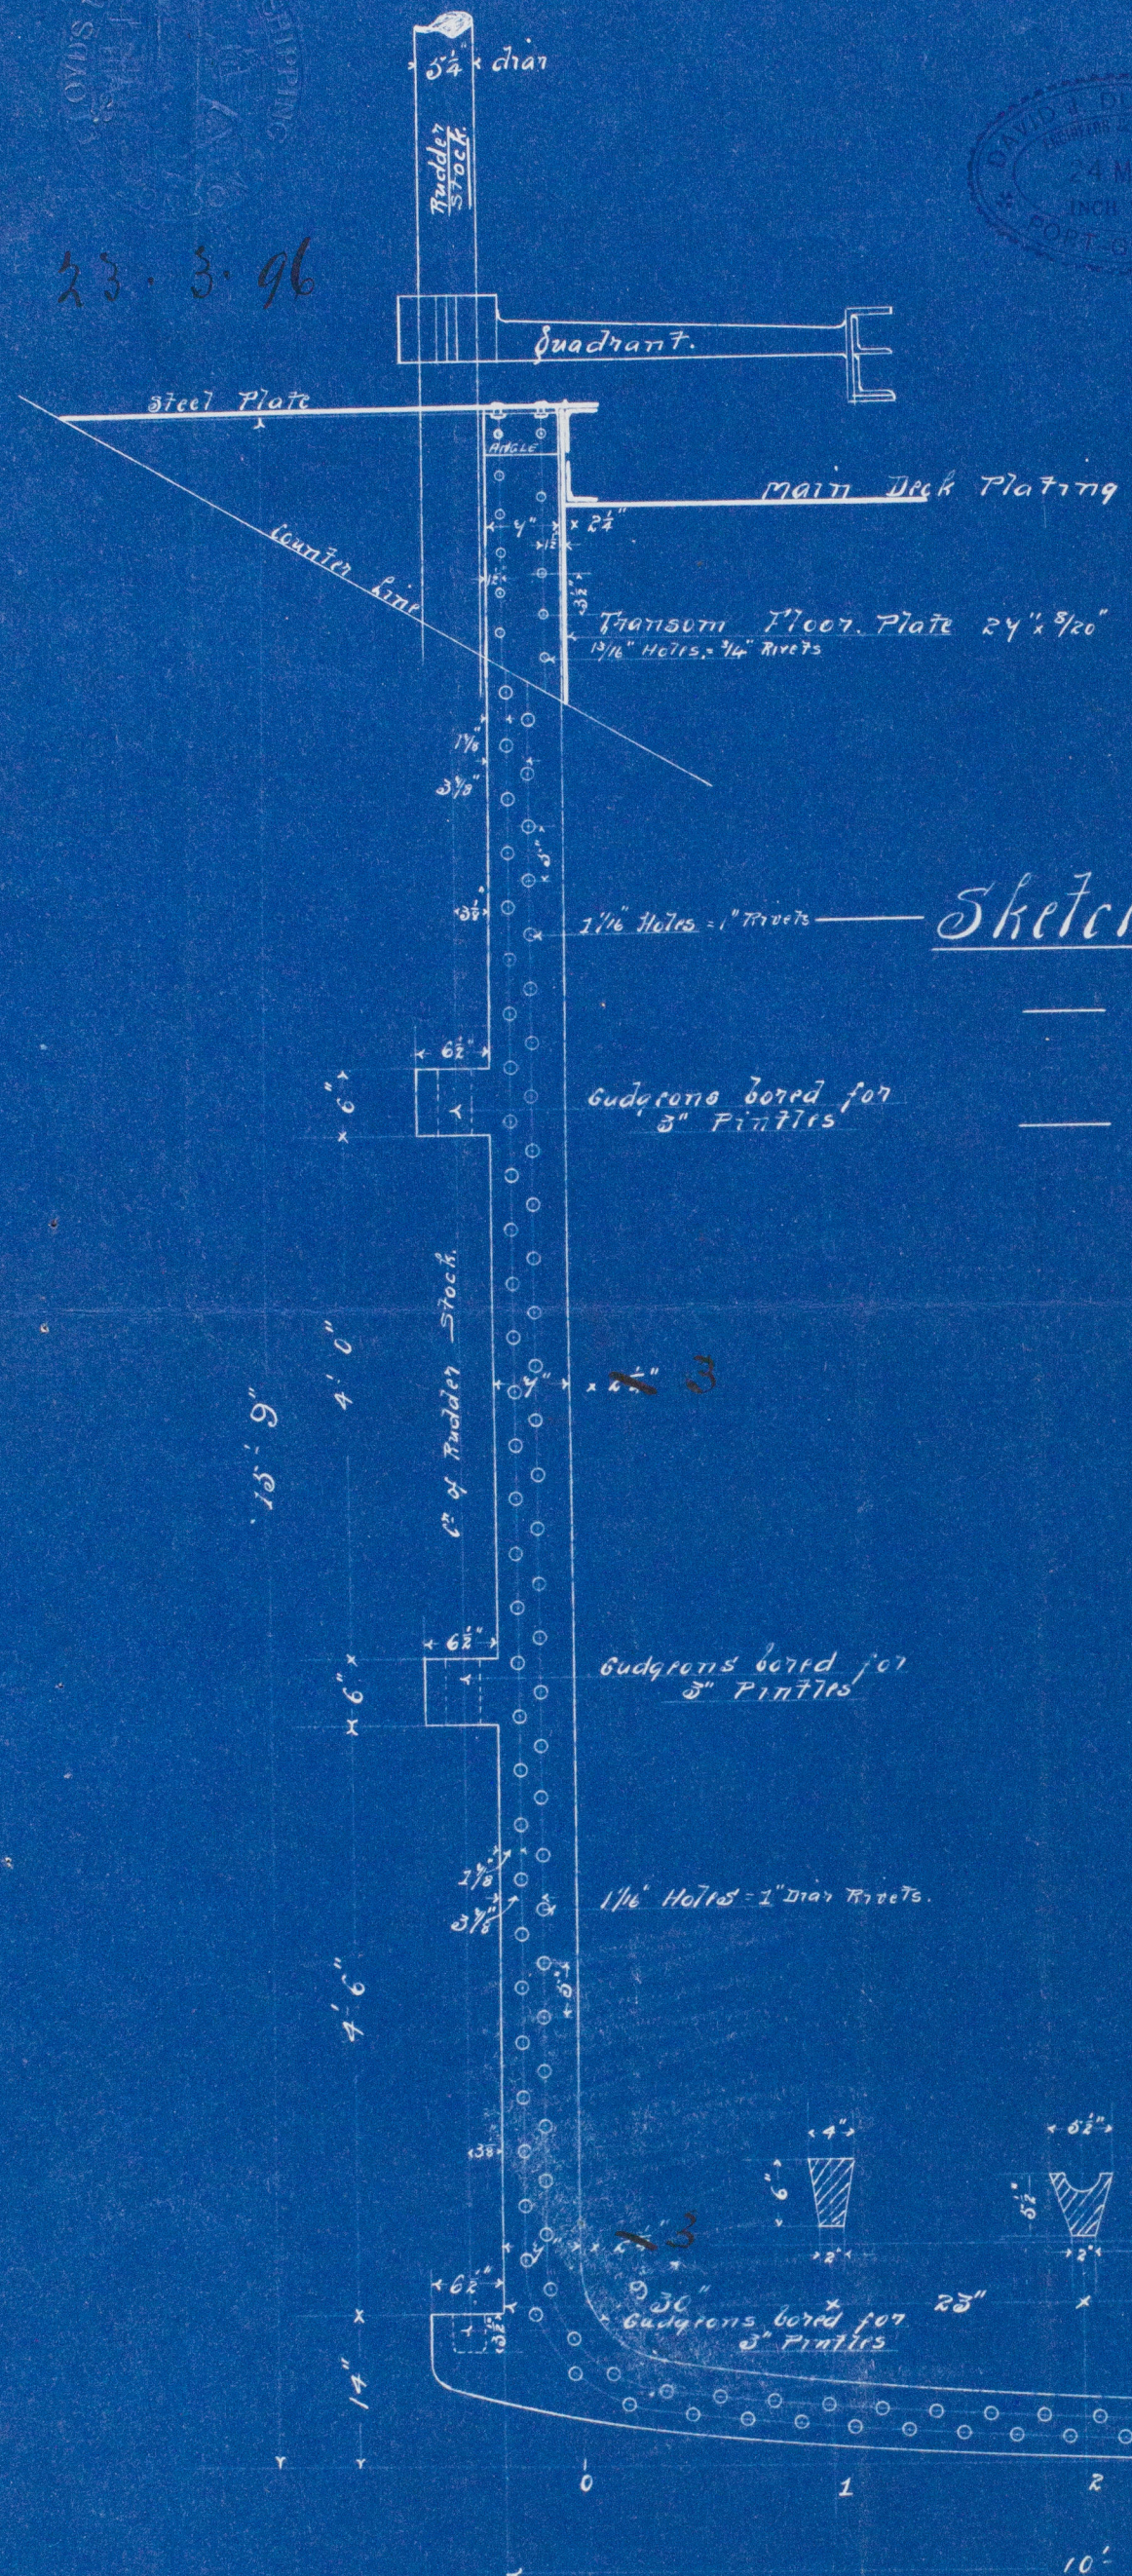

Sketch of Stern Post  
"T55" N° 234.  
Scale 3/4" = 1 foot.

18<sup>TH</sup> MARCH 96

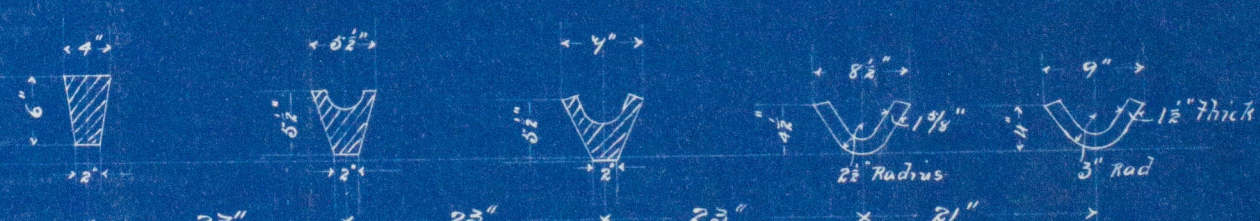

13/76 GRK 335-0086



"J. Lorin."  
Greenock Report  
No. 11519.



GRK 335-0086

1 ton put - David J. Munro & Co. No. 114.



© 2020

Lloyd's Register  
Foundation