

Lloyd's Register of British and Foreign Shipping.

(Report on Vessel No. 11879 Port Kilmarnock
as "Heron")No. 5283 SHIP FORGINGS OR CASTINGS.

I have to report that the undermentioned Iron or Steel Forgings or Castings,
 manufactured by The Portland Forge Coy
 of Kilmarnock for the Vessel No. 234, being built
 by Messrs J & J Dunlop & Coy of Port Glasgow
 have been inspected by me as set forth below, and found to be, so far as can be seen,
Sound & efficient

Mark on Forgings.

Lloyd's


No. 5283

W.H.

William Hamilton
Glasgow

	STERN FRAME.	RUDDER FRAME.	STEM.
Material* ...		<u>Scrap iron</u>	
How made ...		<u>Forged</u>	
Dimensions ...		<u>5'4" to 3'2" 3" thick</u>	
Progress on Inspection		<u>Forging & smithing</u>	
Date when Inspected		<u>3 to 26/6/96</u>	

SKETCHES OF FRAMES SHOWING POSITION AND DESCRIPTION OF WELDS OF FORGINGS, OR PARTICULARS OF
 TESTS APPLIED TO CASTINGS.

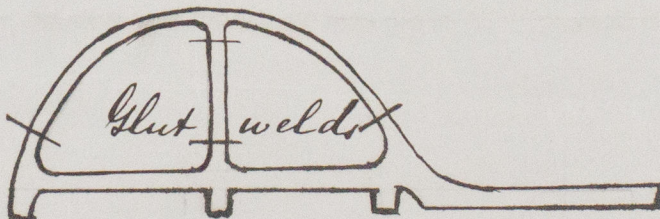

Fee (if any chargeable) £

To be paid at



© 2020

Lloyd's Register
Foundation

* If of Iron, state whether scrap or puddled Iron. GKK 335-0108