
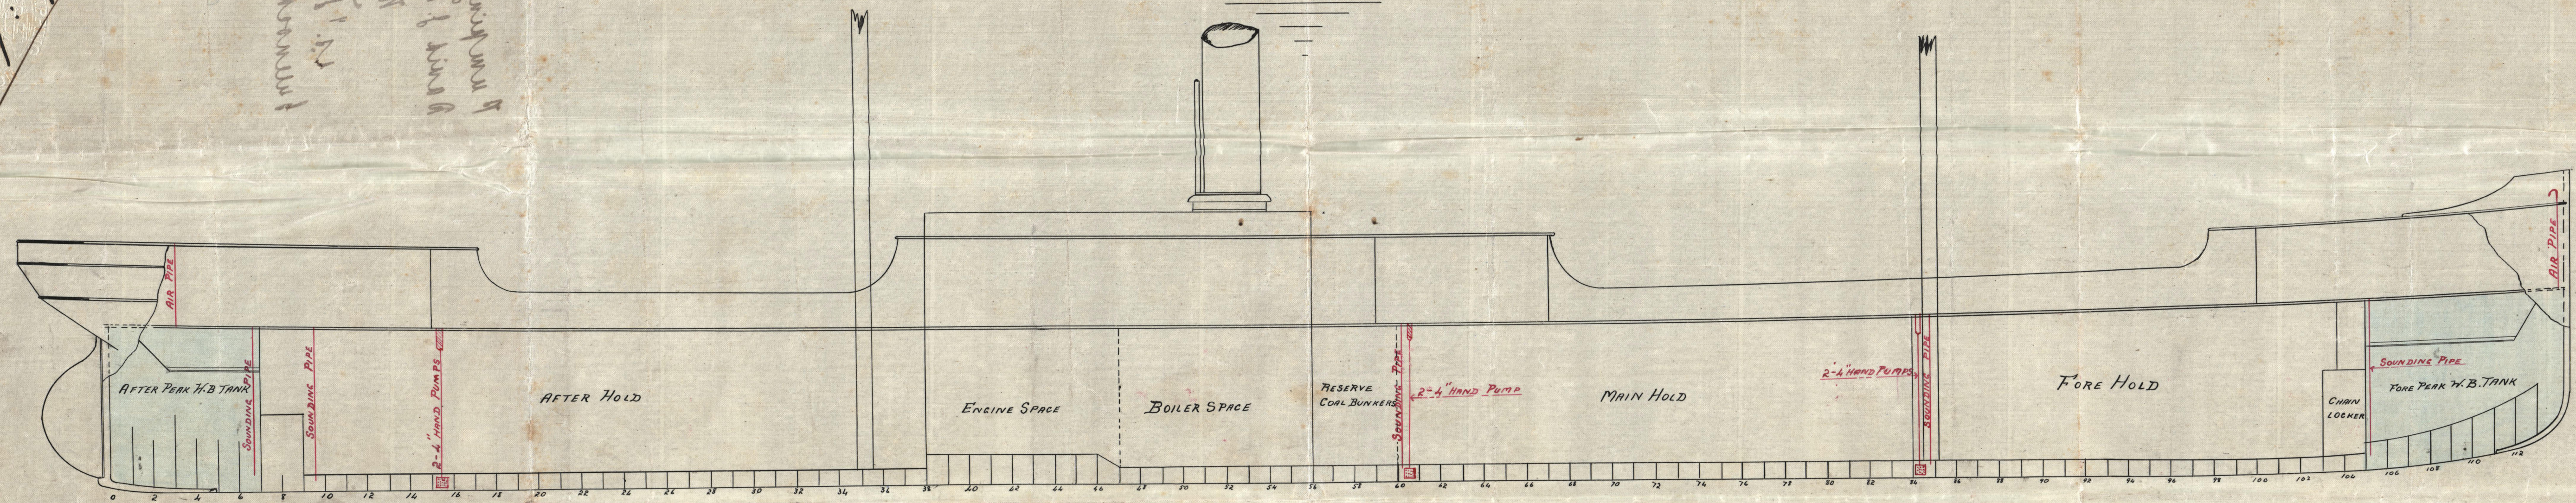


— SCALE $\frac{1}{8}$ INCH = 1 FOOT. —

BILGE SUCTIONS

BALLAST SUCTIONS

HAND PUMPS, ETC.

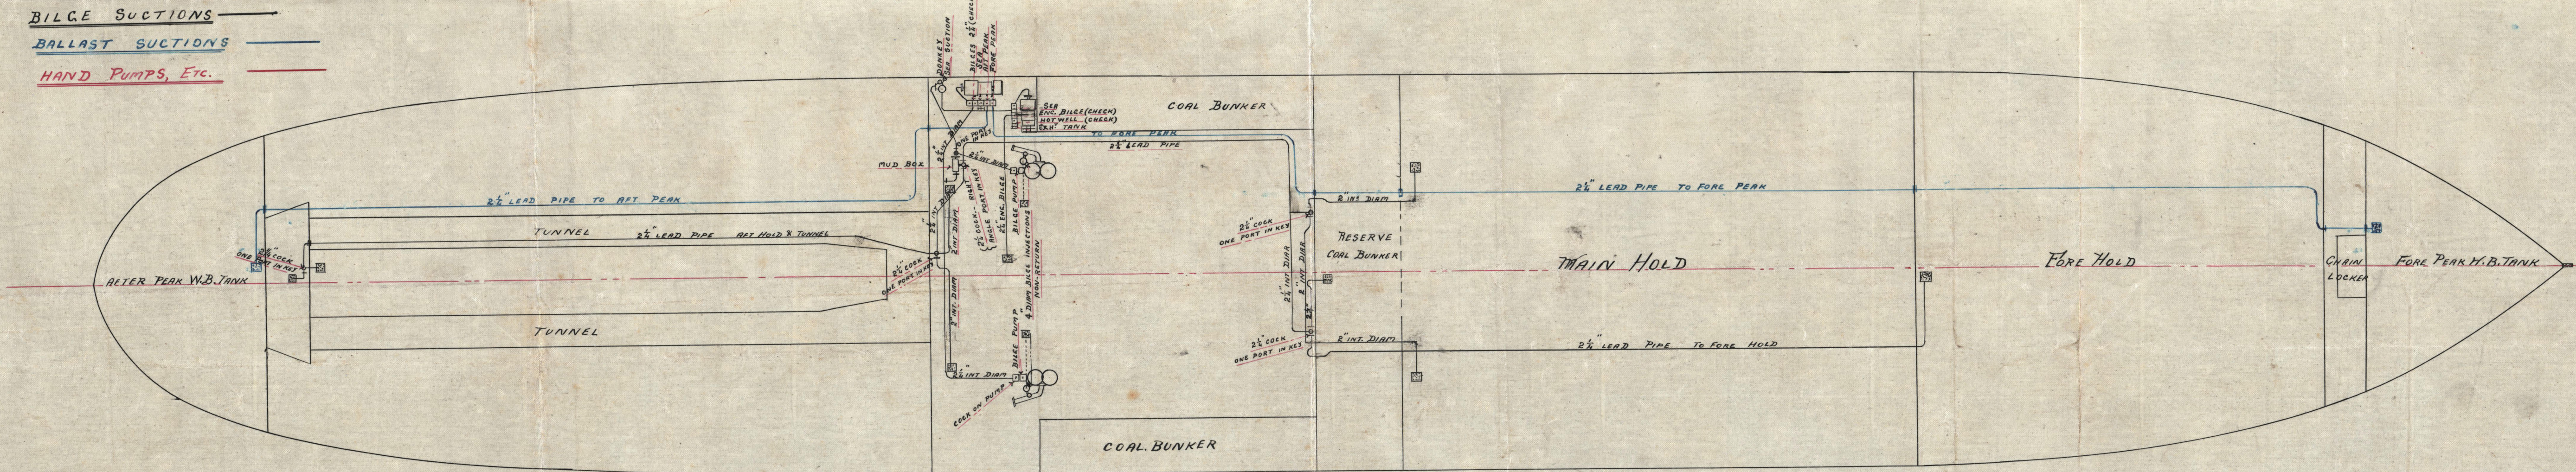

DAVID J. DUNLOP & CO.

ENGINEERS & SHIPBUILDERS

PORT GLASGOW

30.6.96

Greenock P.
17/9/96

Lloyd's Register
Foundation


G RK 335-0113

Pumping arrangements
David J. Dunlop obo.
No. 234.

is. "Tevin".
Guinness Report No. 11539.

GRK 335-0113

6th de
1896

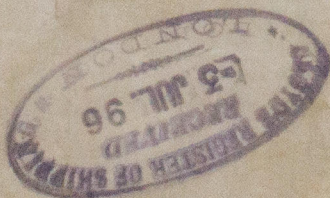

© 2020

Lloyd's Register
Foundation