
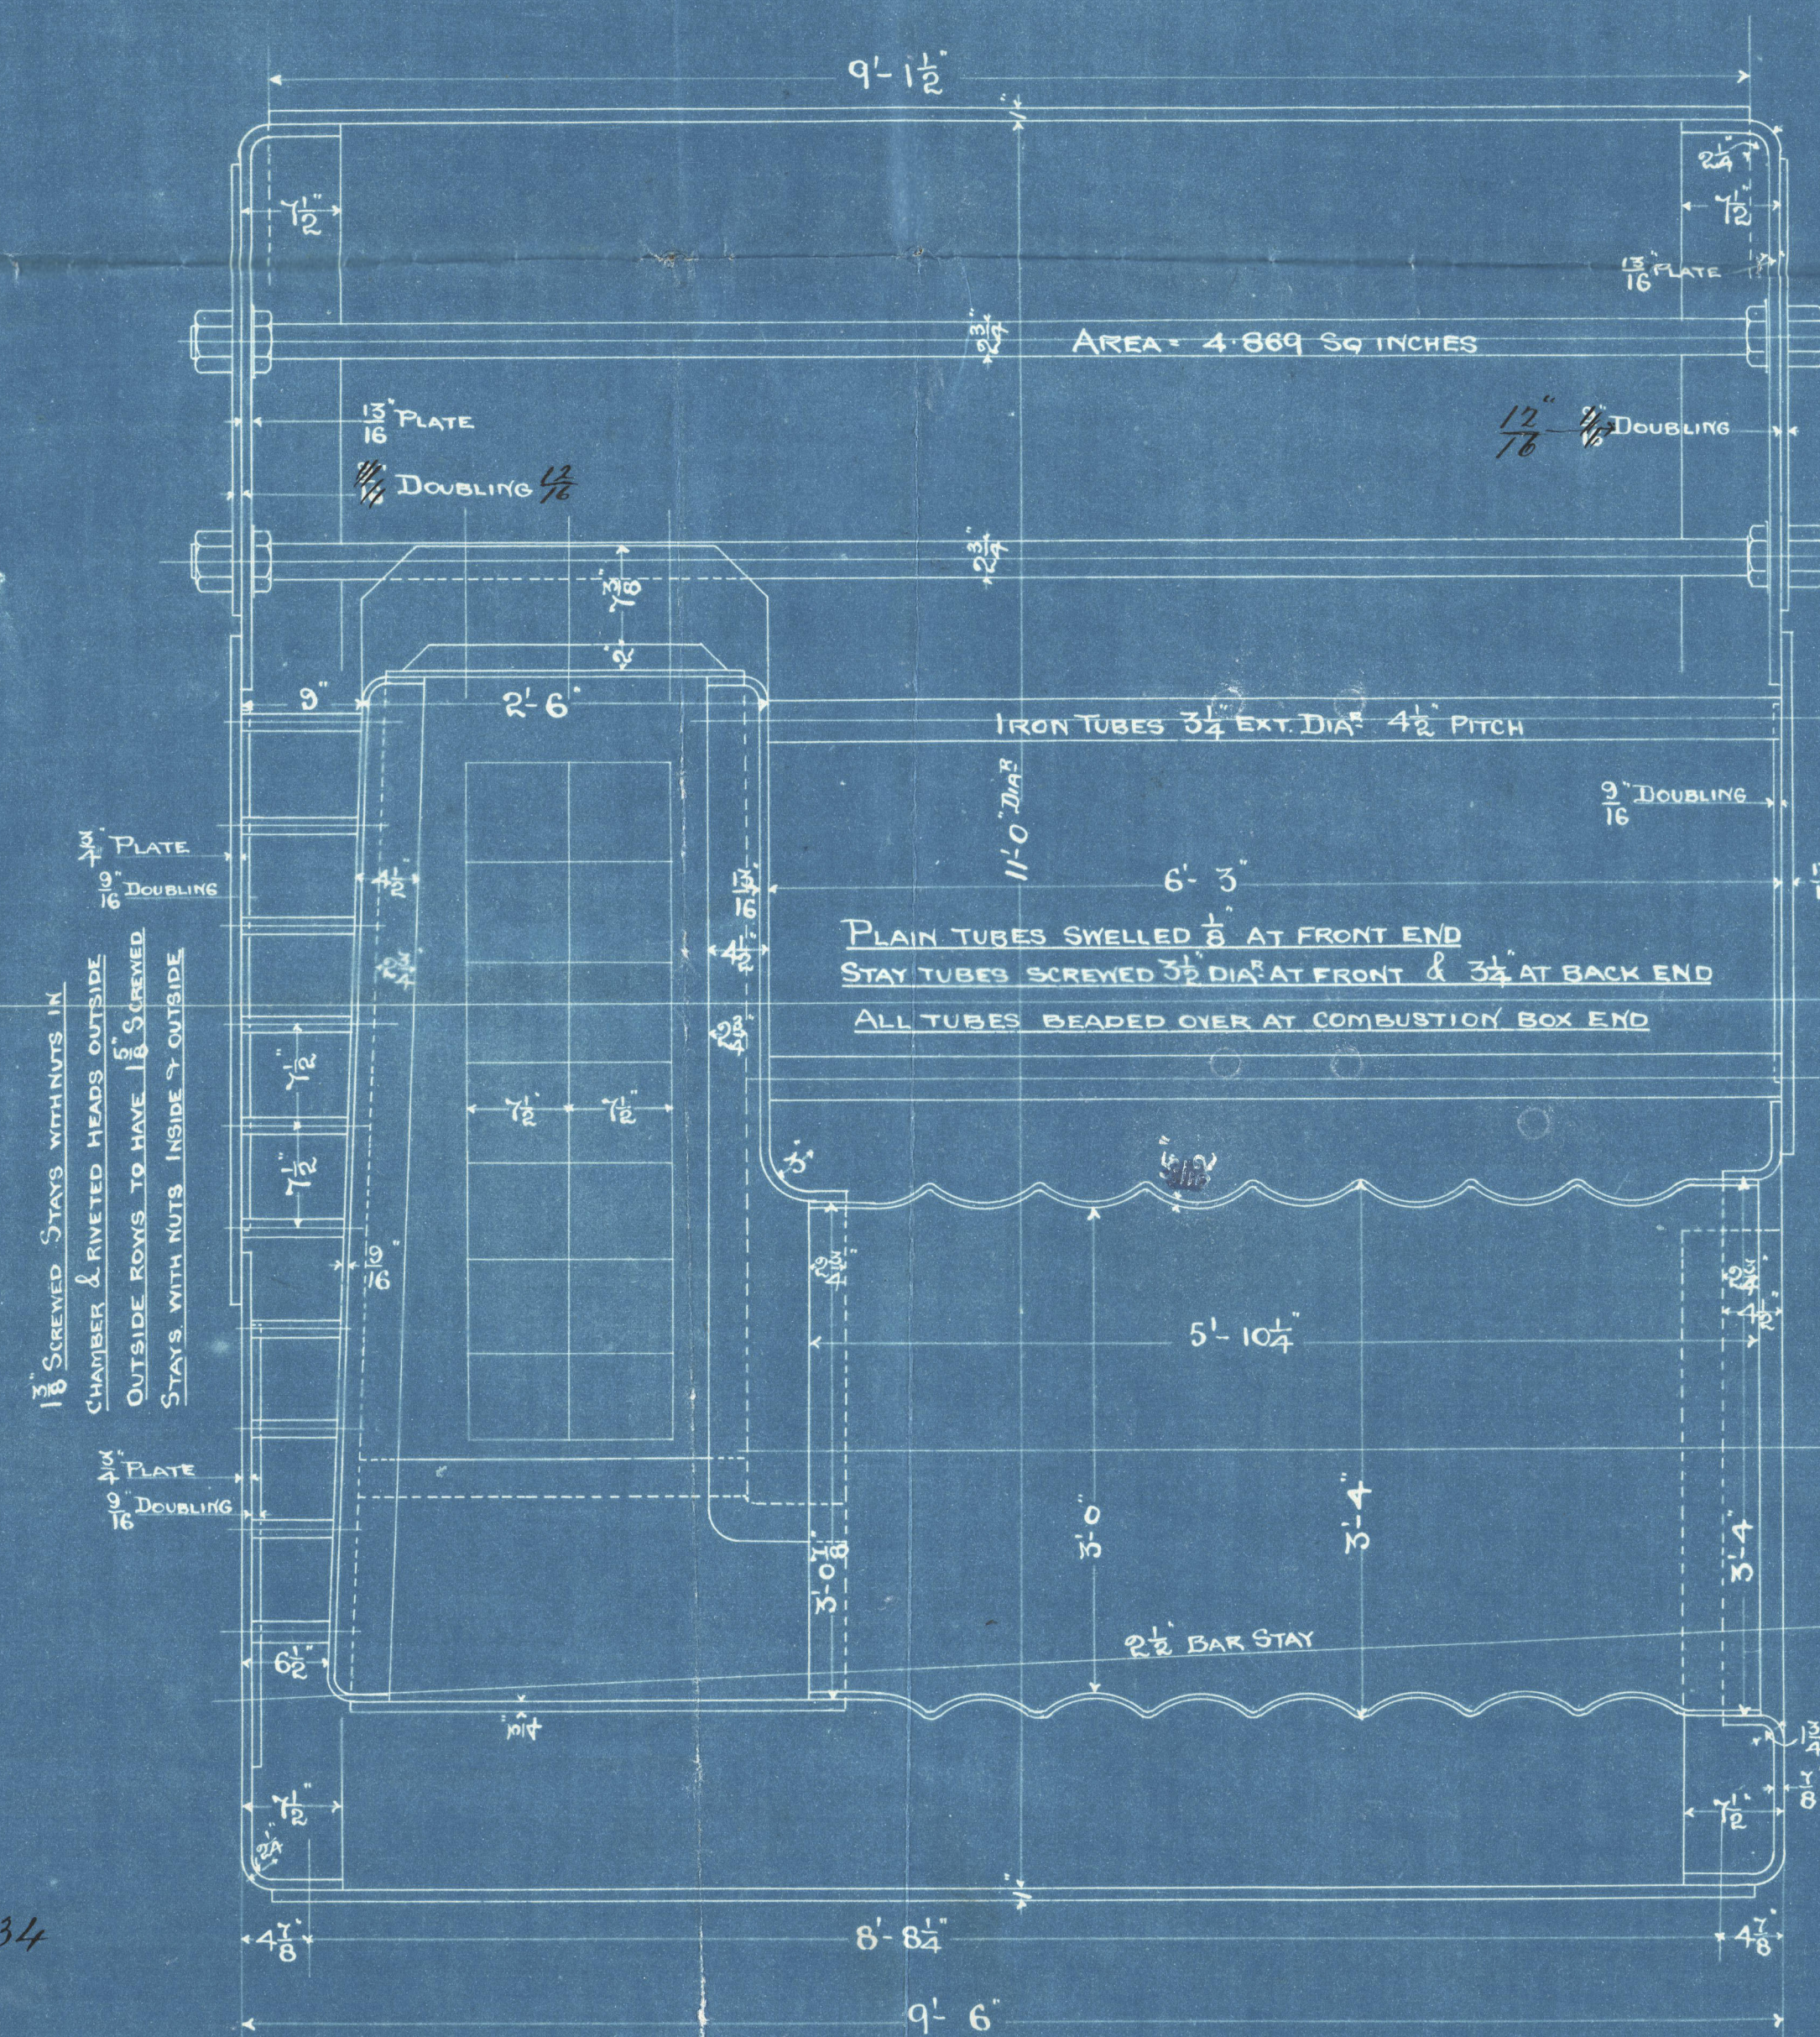
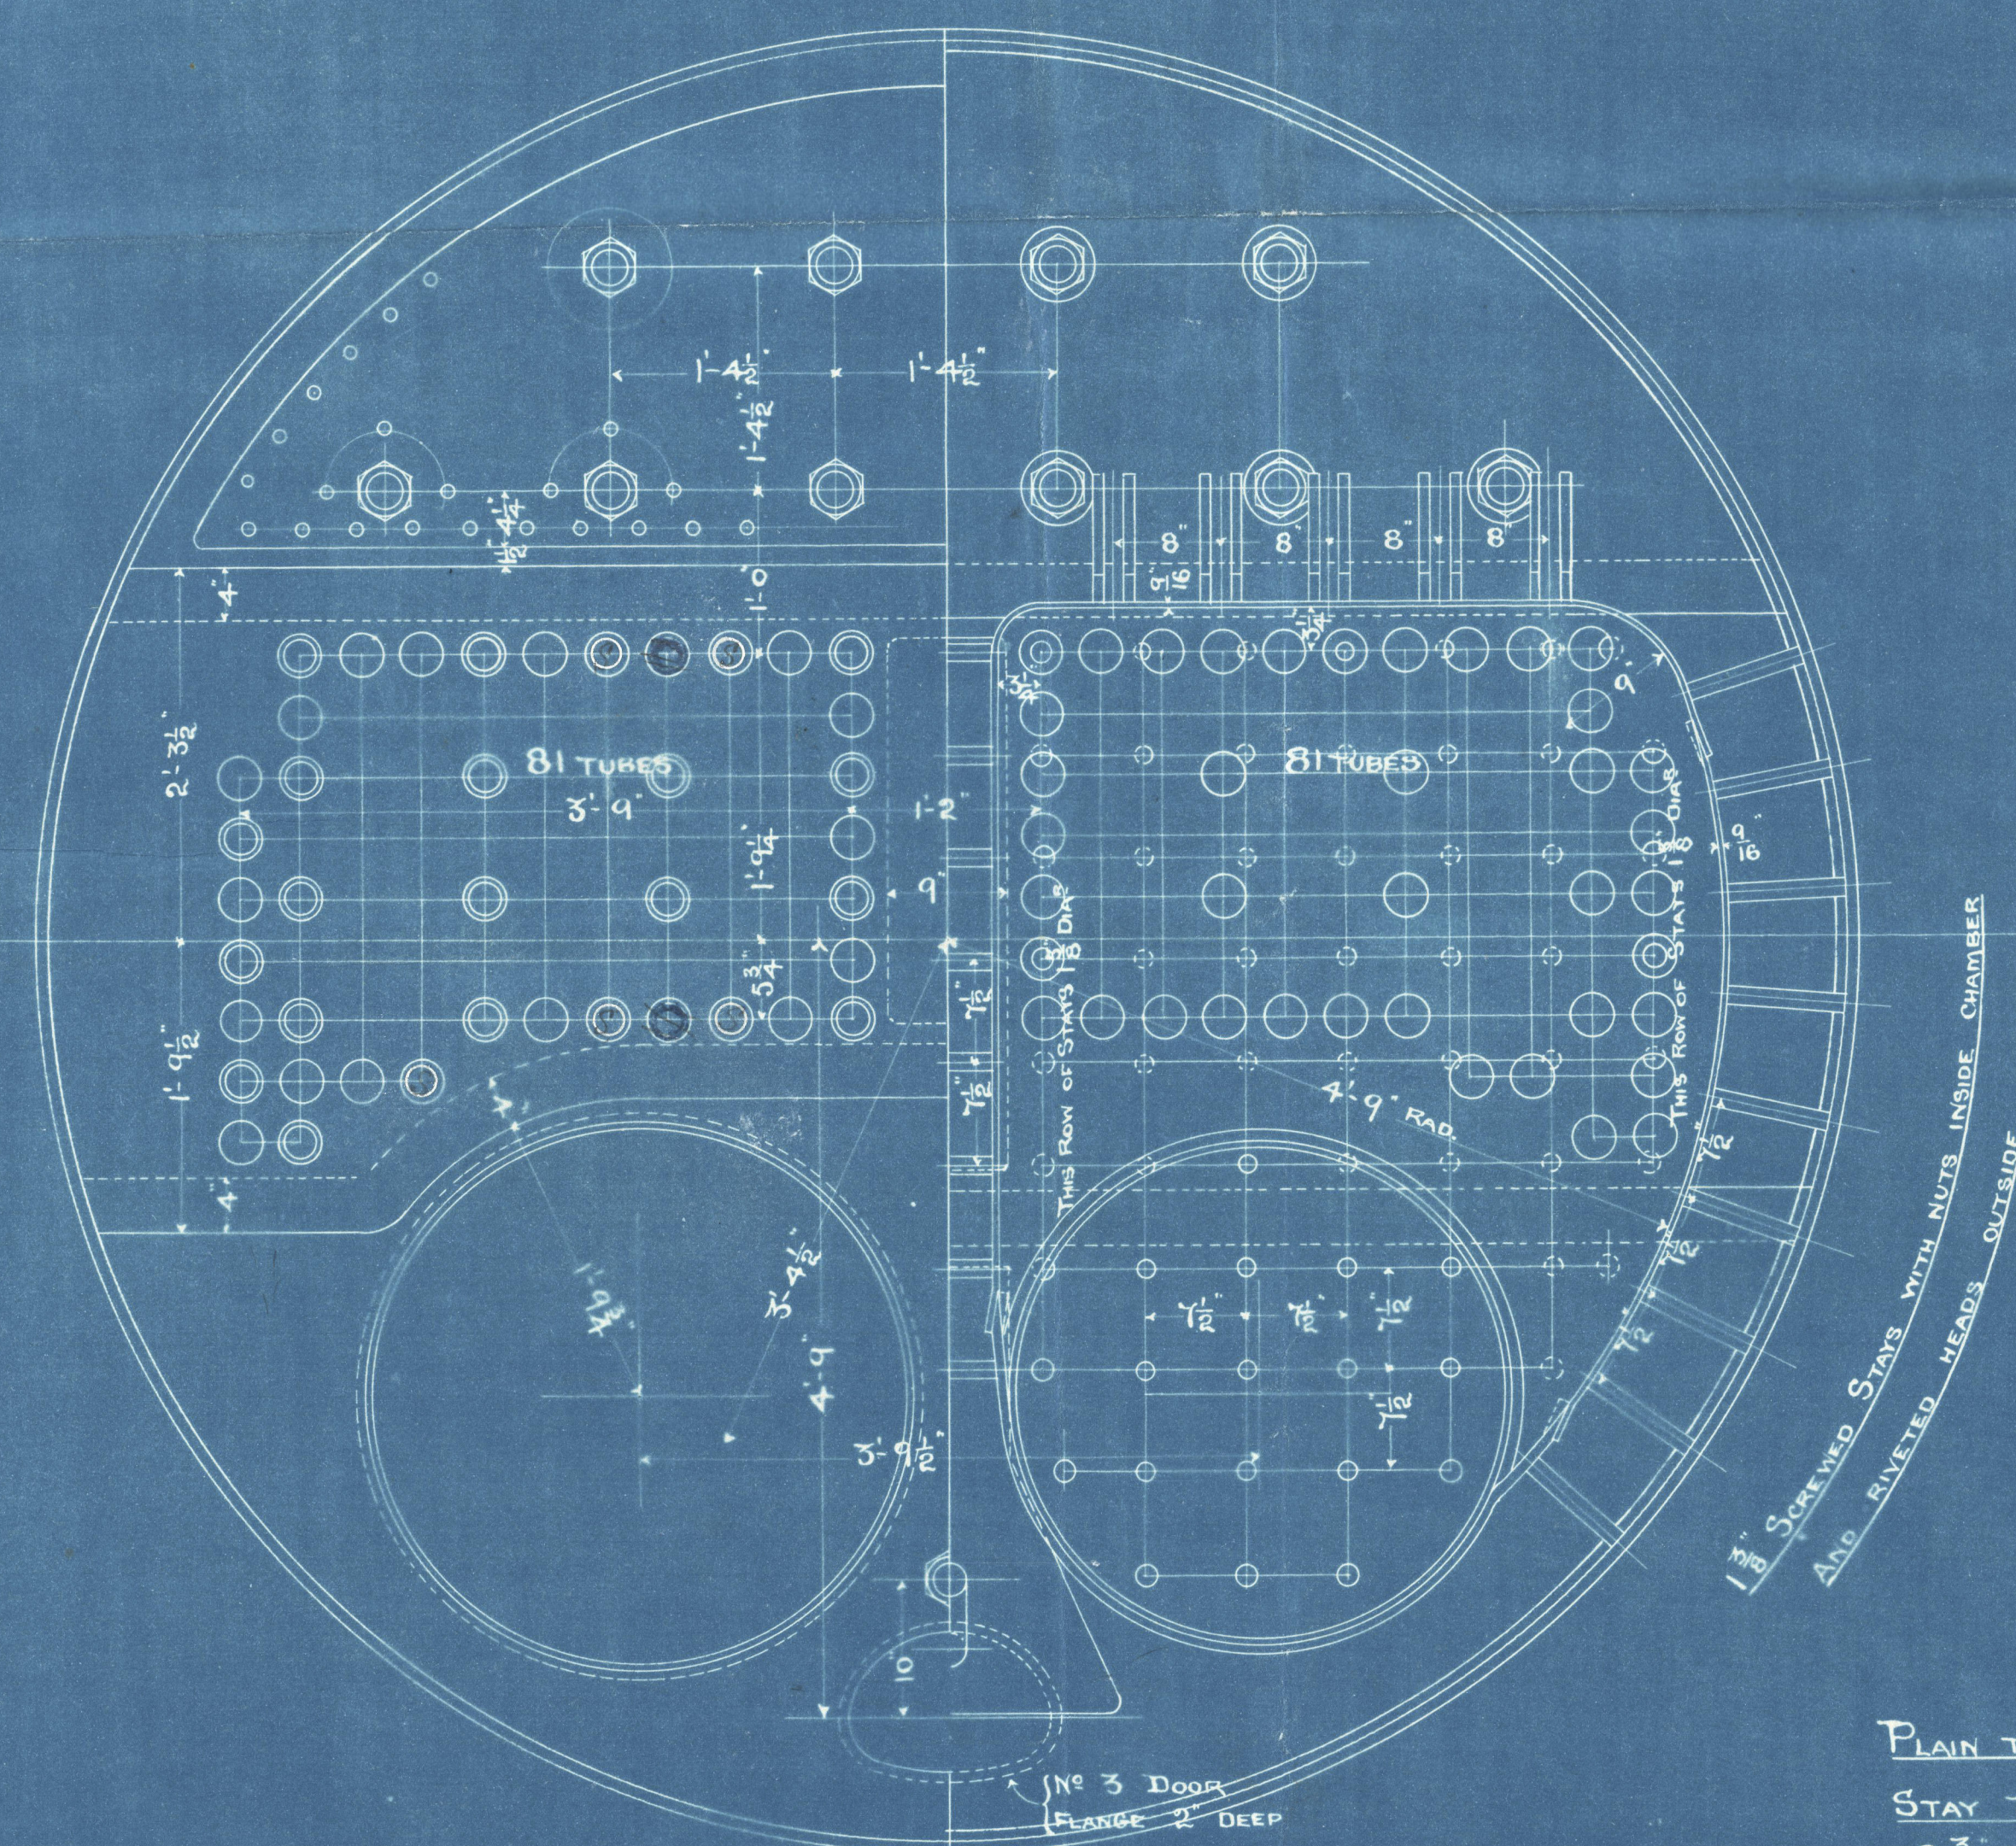
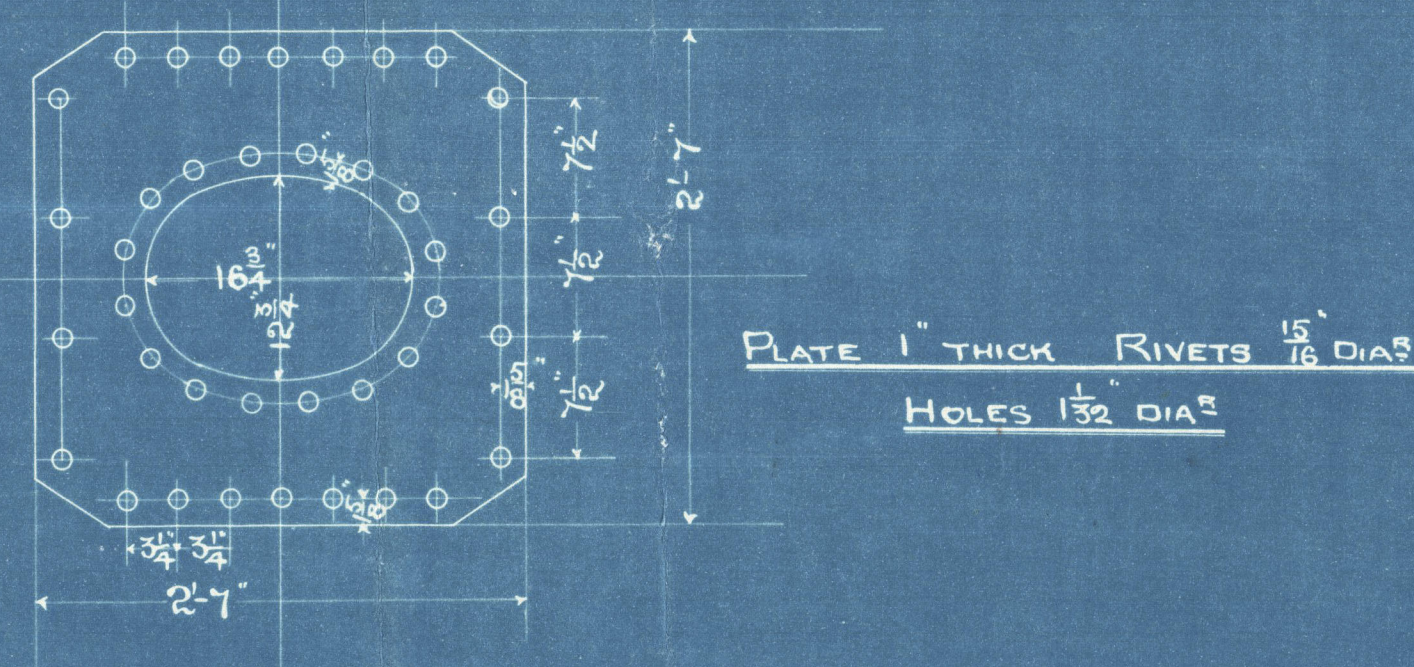
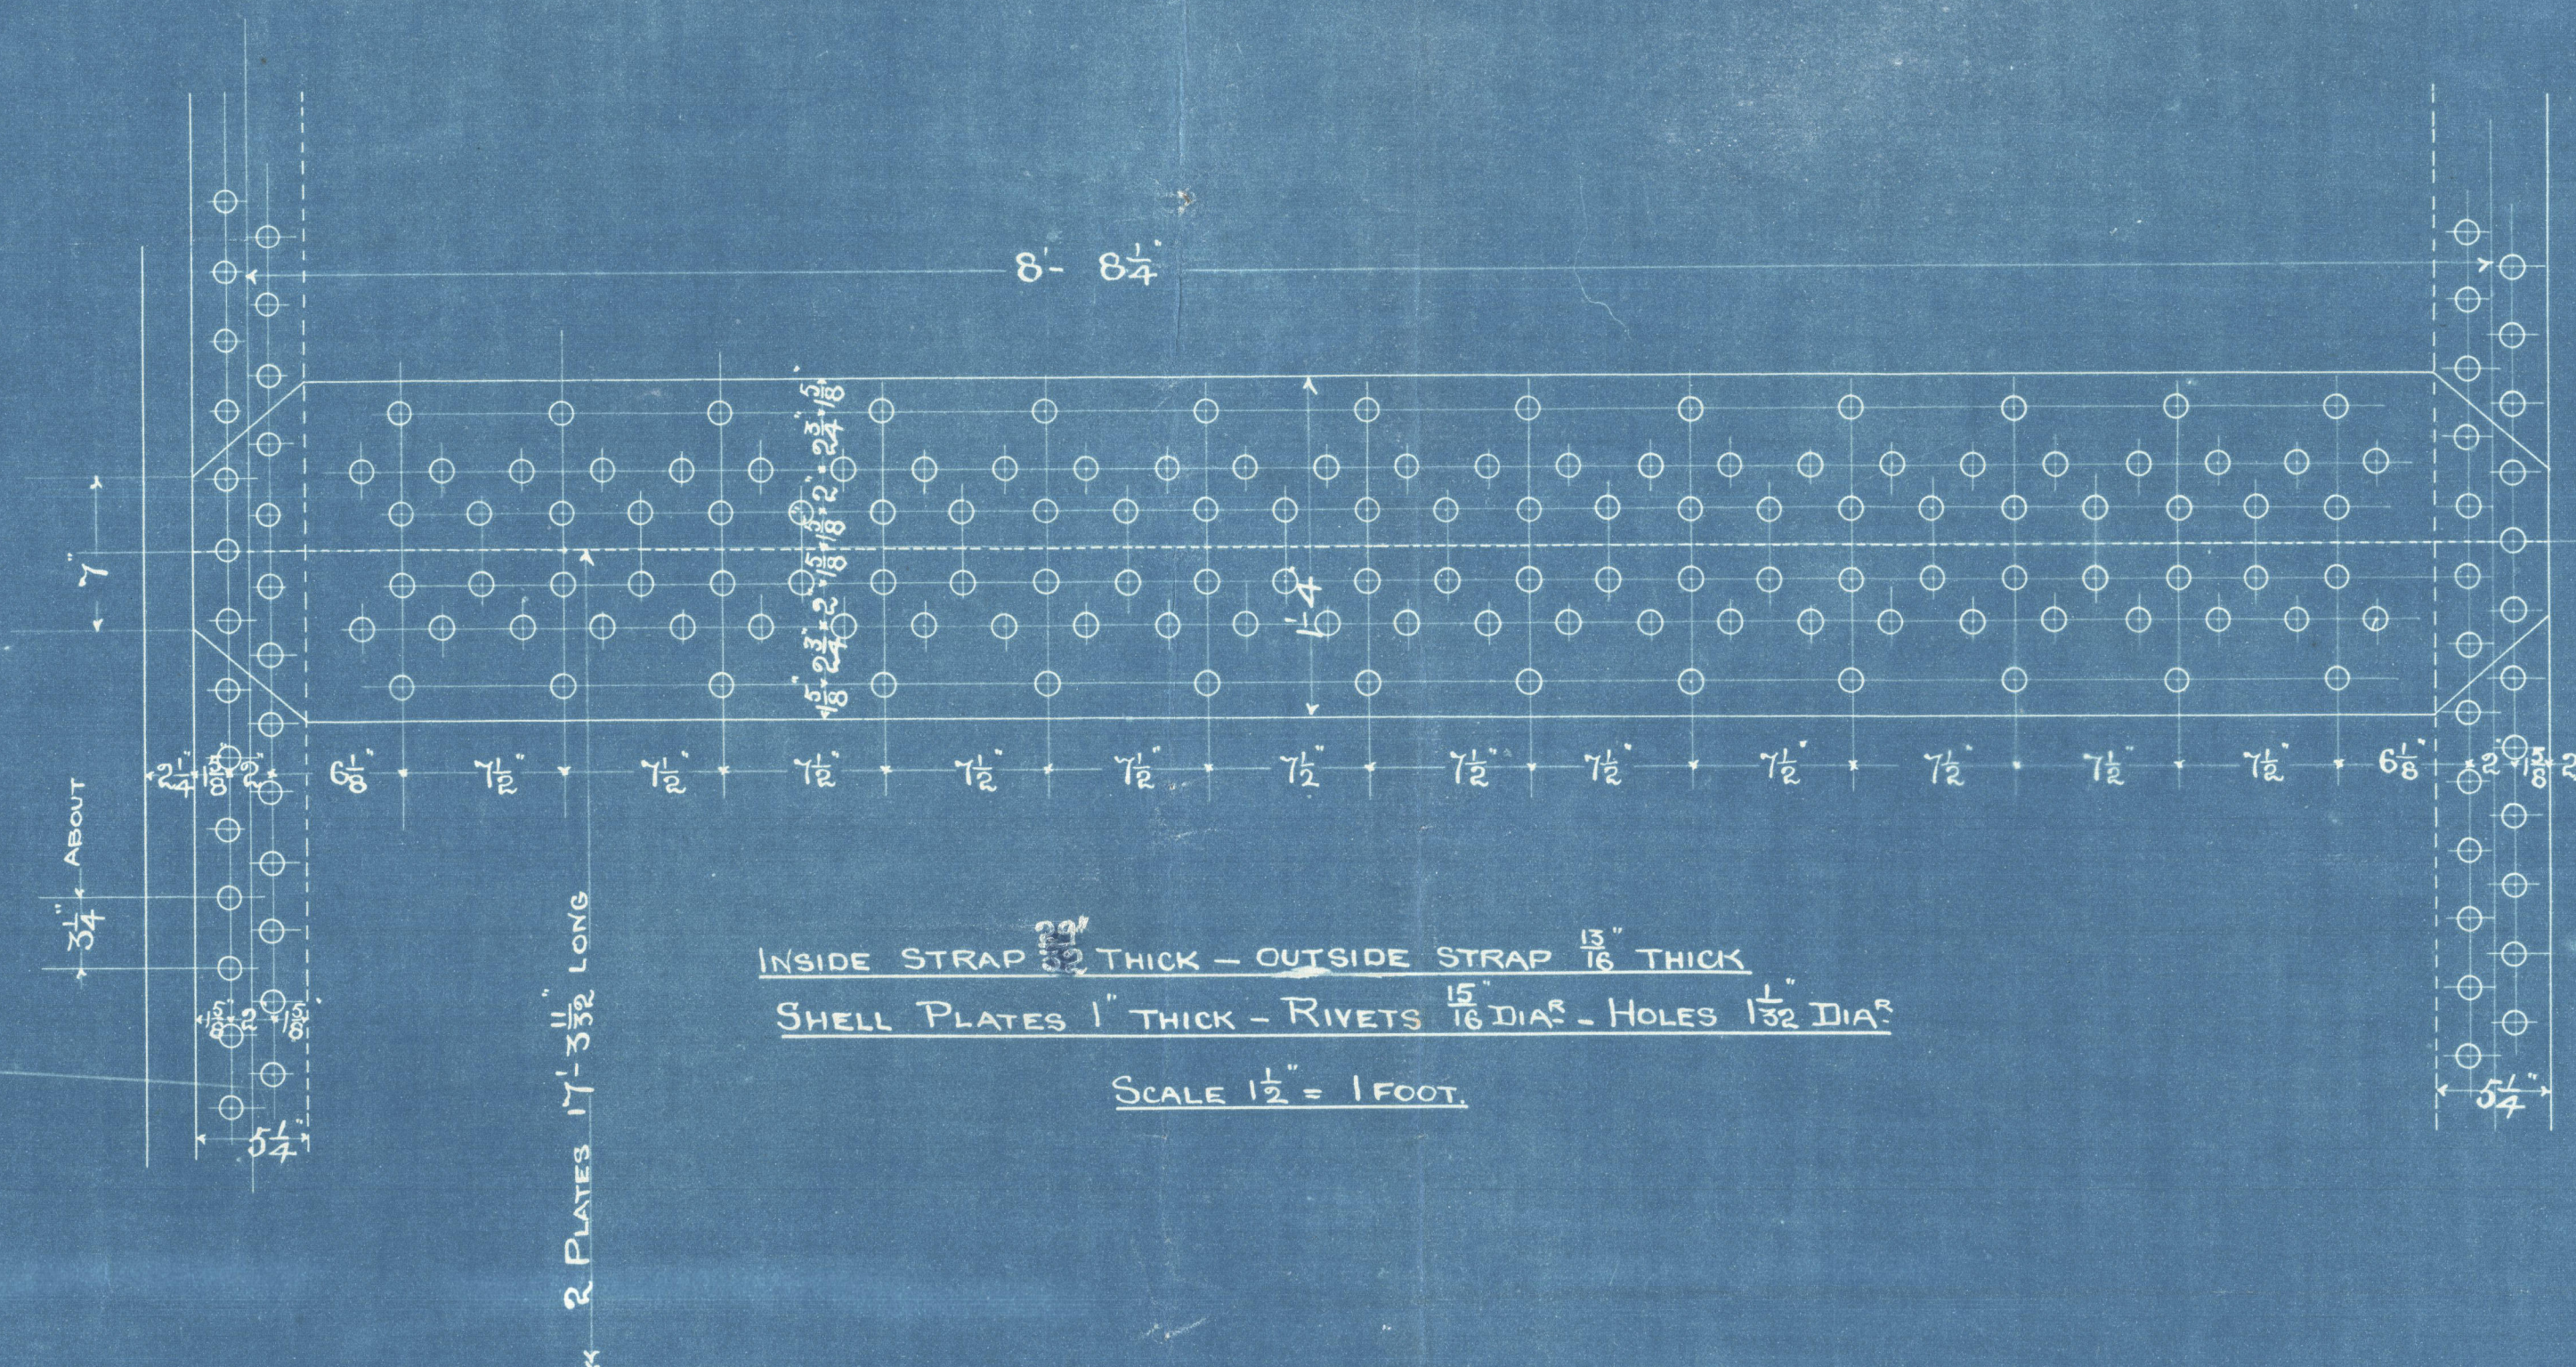


WORKING PRESSURE = 160 LBS.

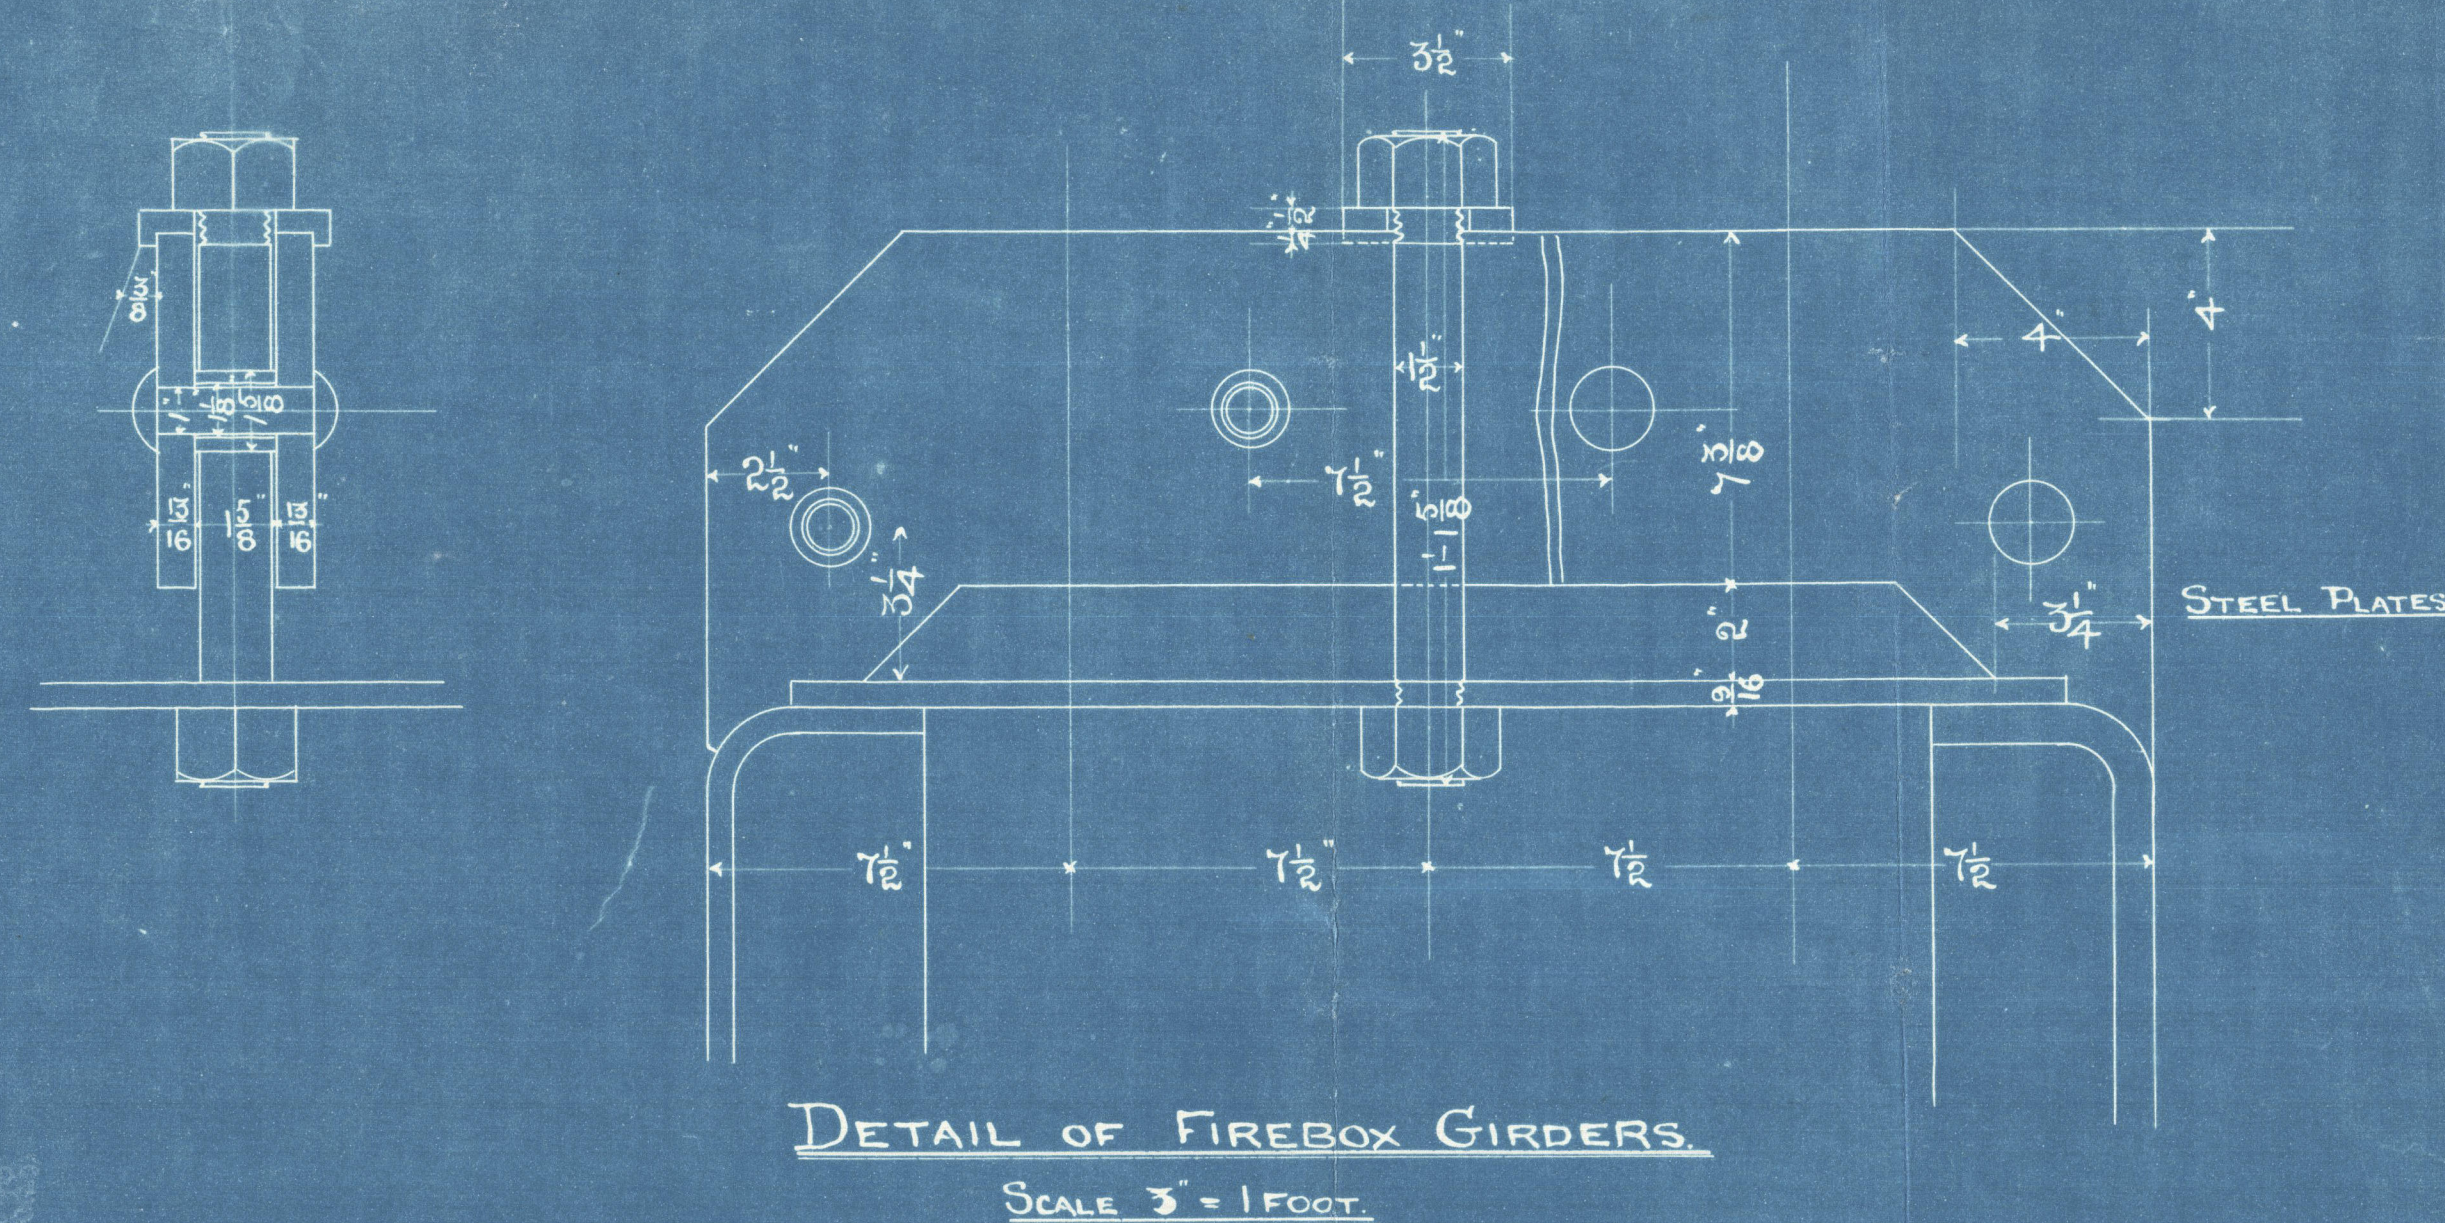

BOILERS. for S.S. 234

SCALE 1" = ONE FOOT

BOILER AS DRAWN FOR PORT SIDE - TO
OPPOSITE HAND FOR STAR^S SIDE

NOTE - ALL MATERIAL TO BE STEEL EXCEPT TUBES
WHICH ARE IRON.


DAVID J. DUNLOP & CO
ENGINEERS & SHIPBUILDERS
PORT GLASGOW

GRK 335-0114

Lloyd's Register
Foundation

U.S. "Loring"
Brunock Report no. 11539.
L.S. 234.

GRK 335-0114

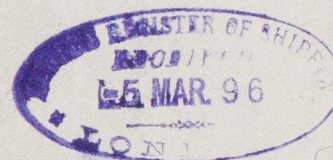

© 2020

Lloyd's Register
Foundation