




18.12.95

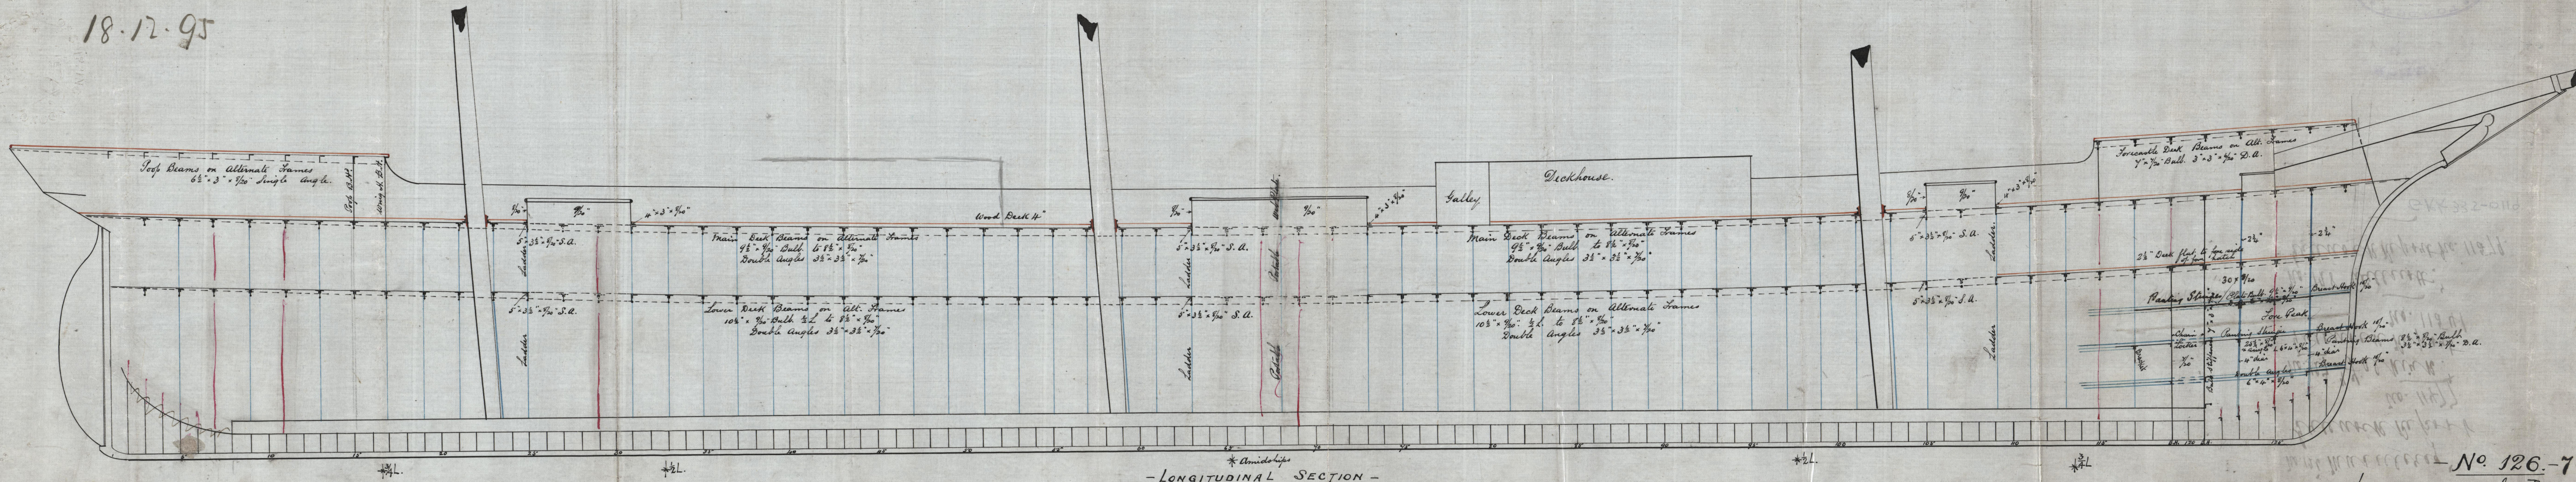

- LONGITUDINAL SECTION -

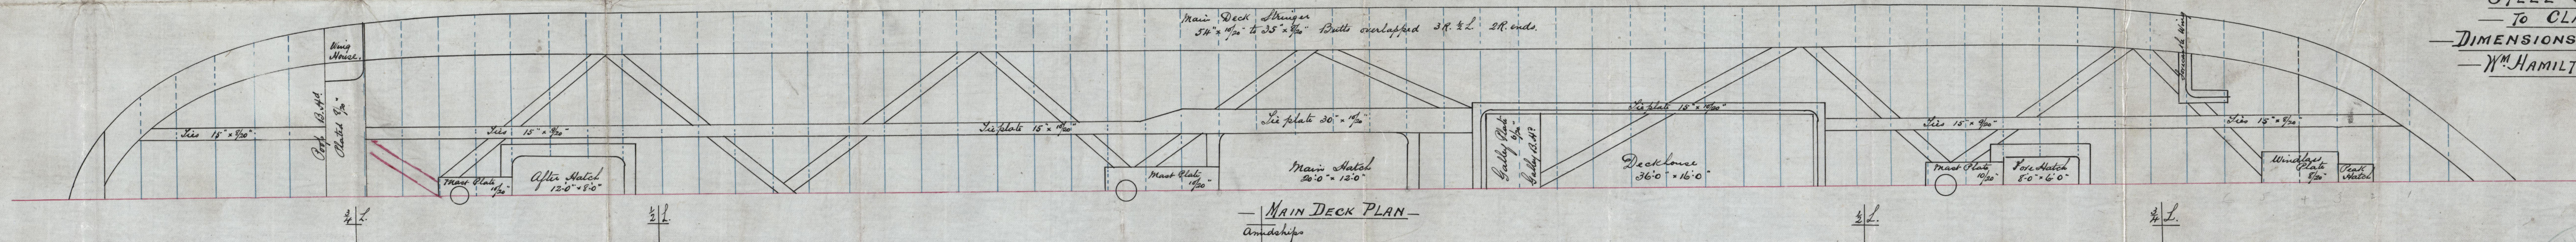

- MAIN DECK PLAN -
Amidships

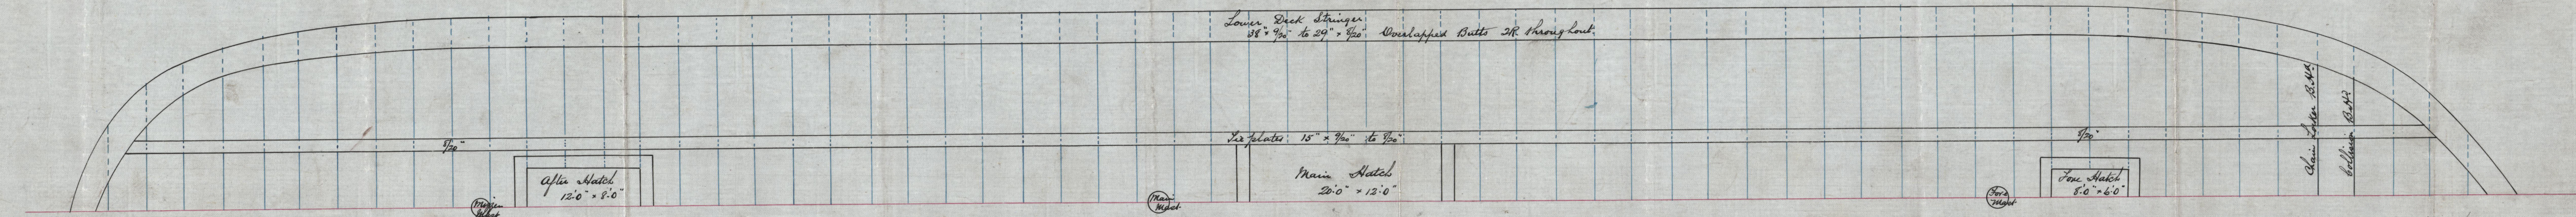

- LOWER DECK PLAN -

No. 126-7-8
 LONGITUDINAL & DECK PLANS.
 STEEL SAILING BARQUE
 TO CLASS 100A1. AT LLOYDS.
 DIMENSIONS. 258'0" x 39'11" x 25'12" MLD to M.D.
 Wm. HAMILTON & Co. PORT GLASGOW.



18/12/95

No. 126 Musclerag
Guano Report

No. 11477

No. 127. "Falkin R."

Guano Report

No. 11541

No. 128 "Willerott."

Guano Report No. 11579.

GRK 335-0119



© 2020

Lloyd's Register
Foundation