


76.5.96

RUDDER FRAME Nos 127-8

— WITH —  
"PORTLAND" PATENT DETACHABLE COUPLING  
— Scale 1/2" inch —

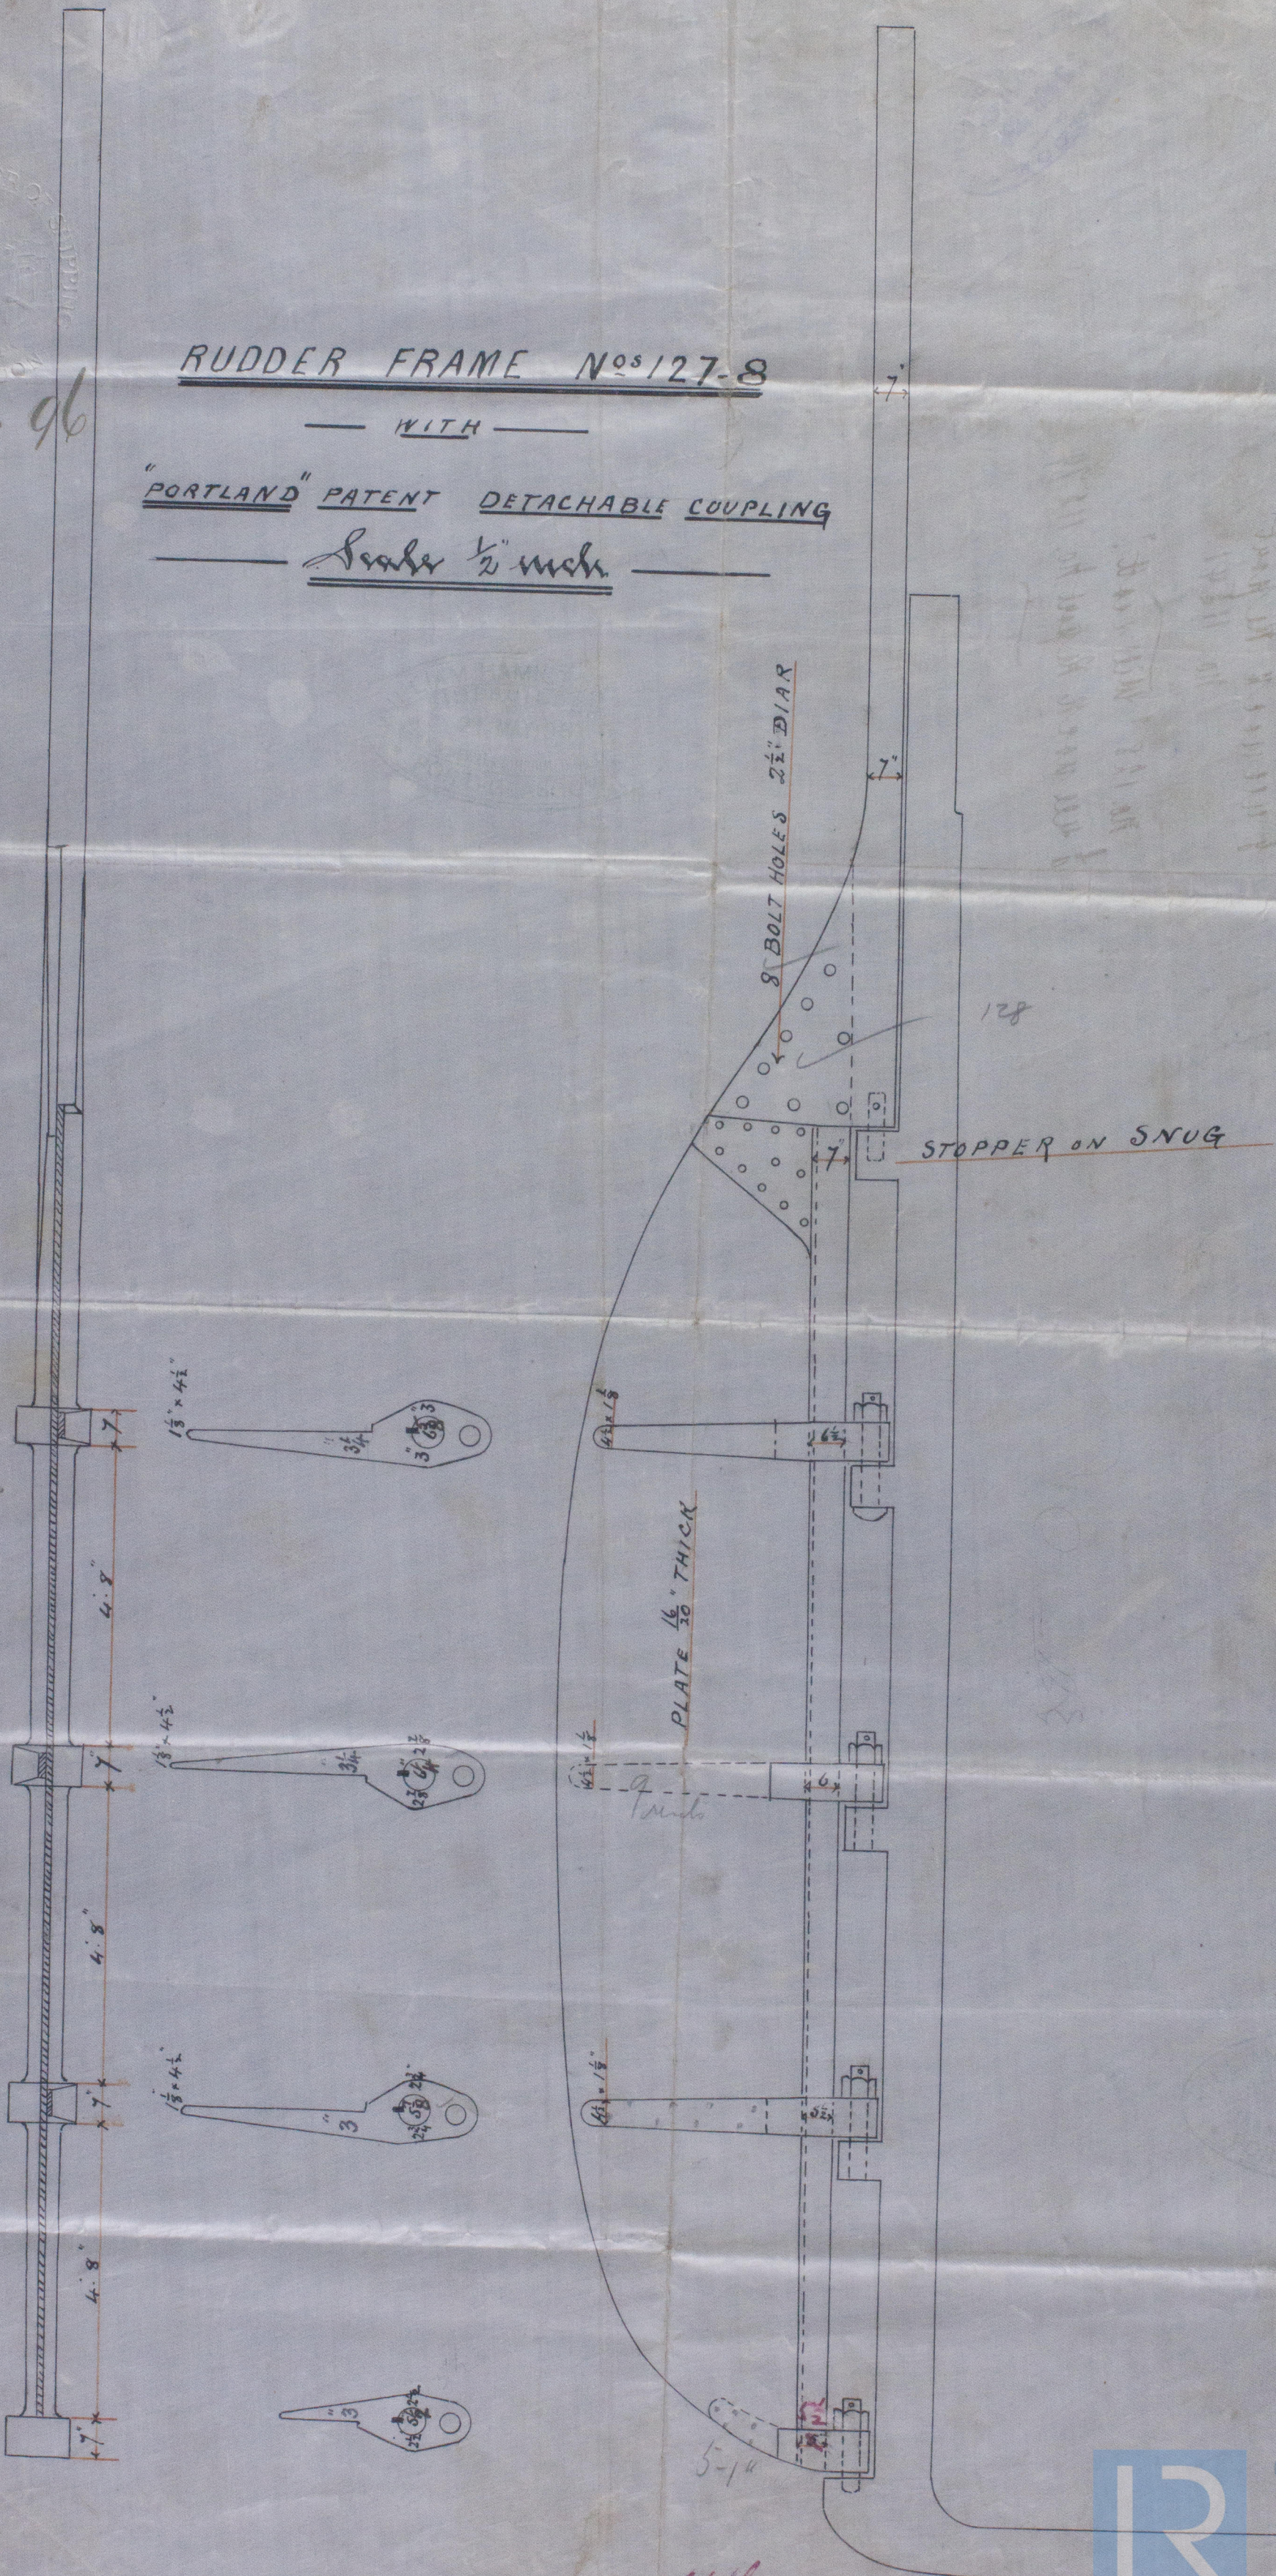

*Handwritten notes:*  
128  
129  
*Handwritten:* 14/6 28/5/96




Rudder Frame  
with the Patent Lock and Coupling  
W. Hammett & Co  
No 127. 1128

No 127. Falkirk  
See also Report  
No. 11541.

No. 128 "Willcott."  
See also Report No. 11579

GRK 335-0121

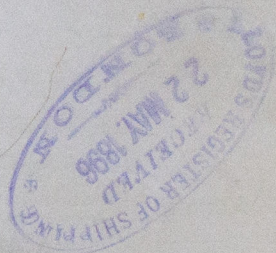

© 2020

Lloyd's Register  
Foundation