

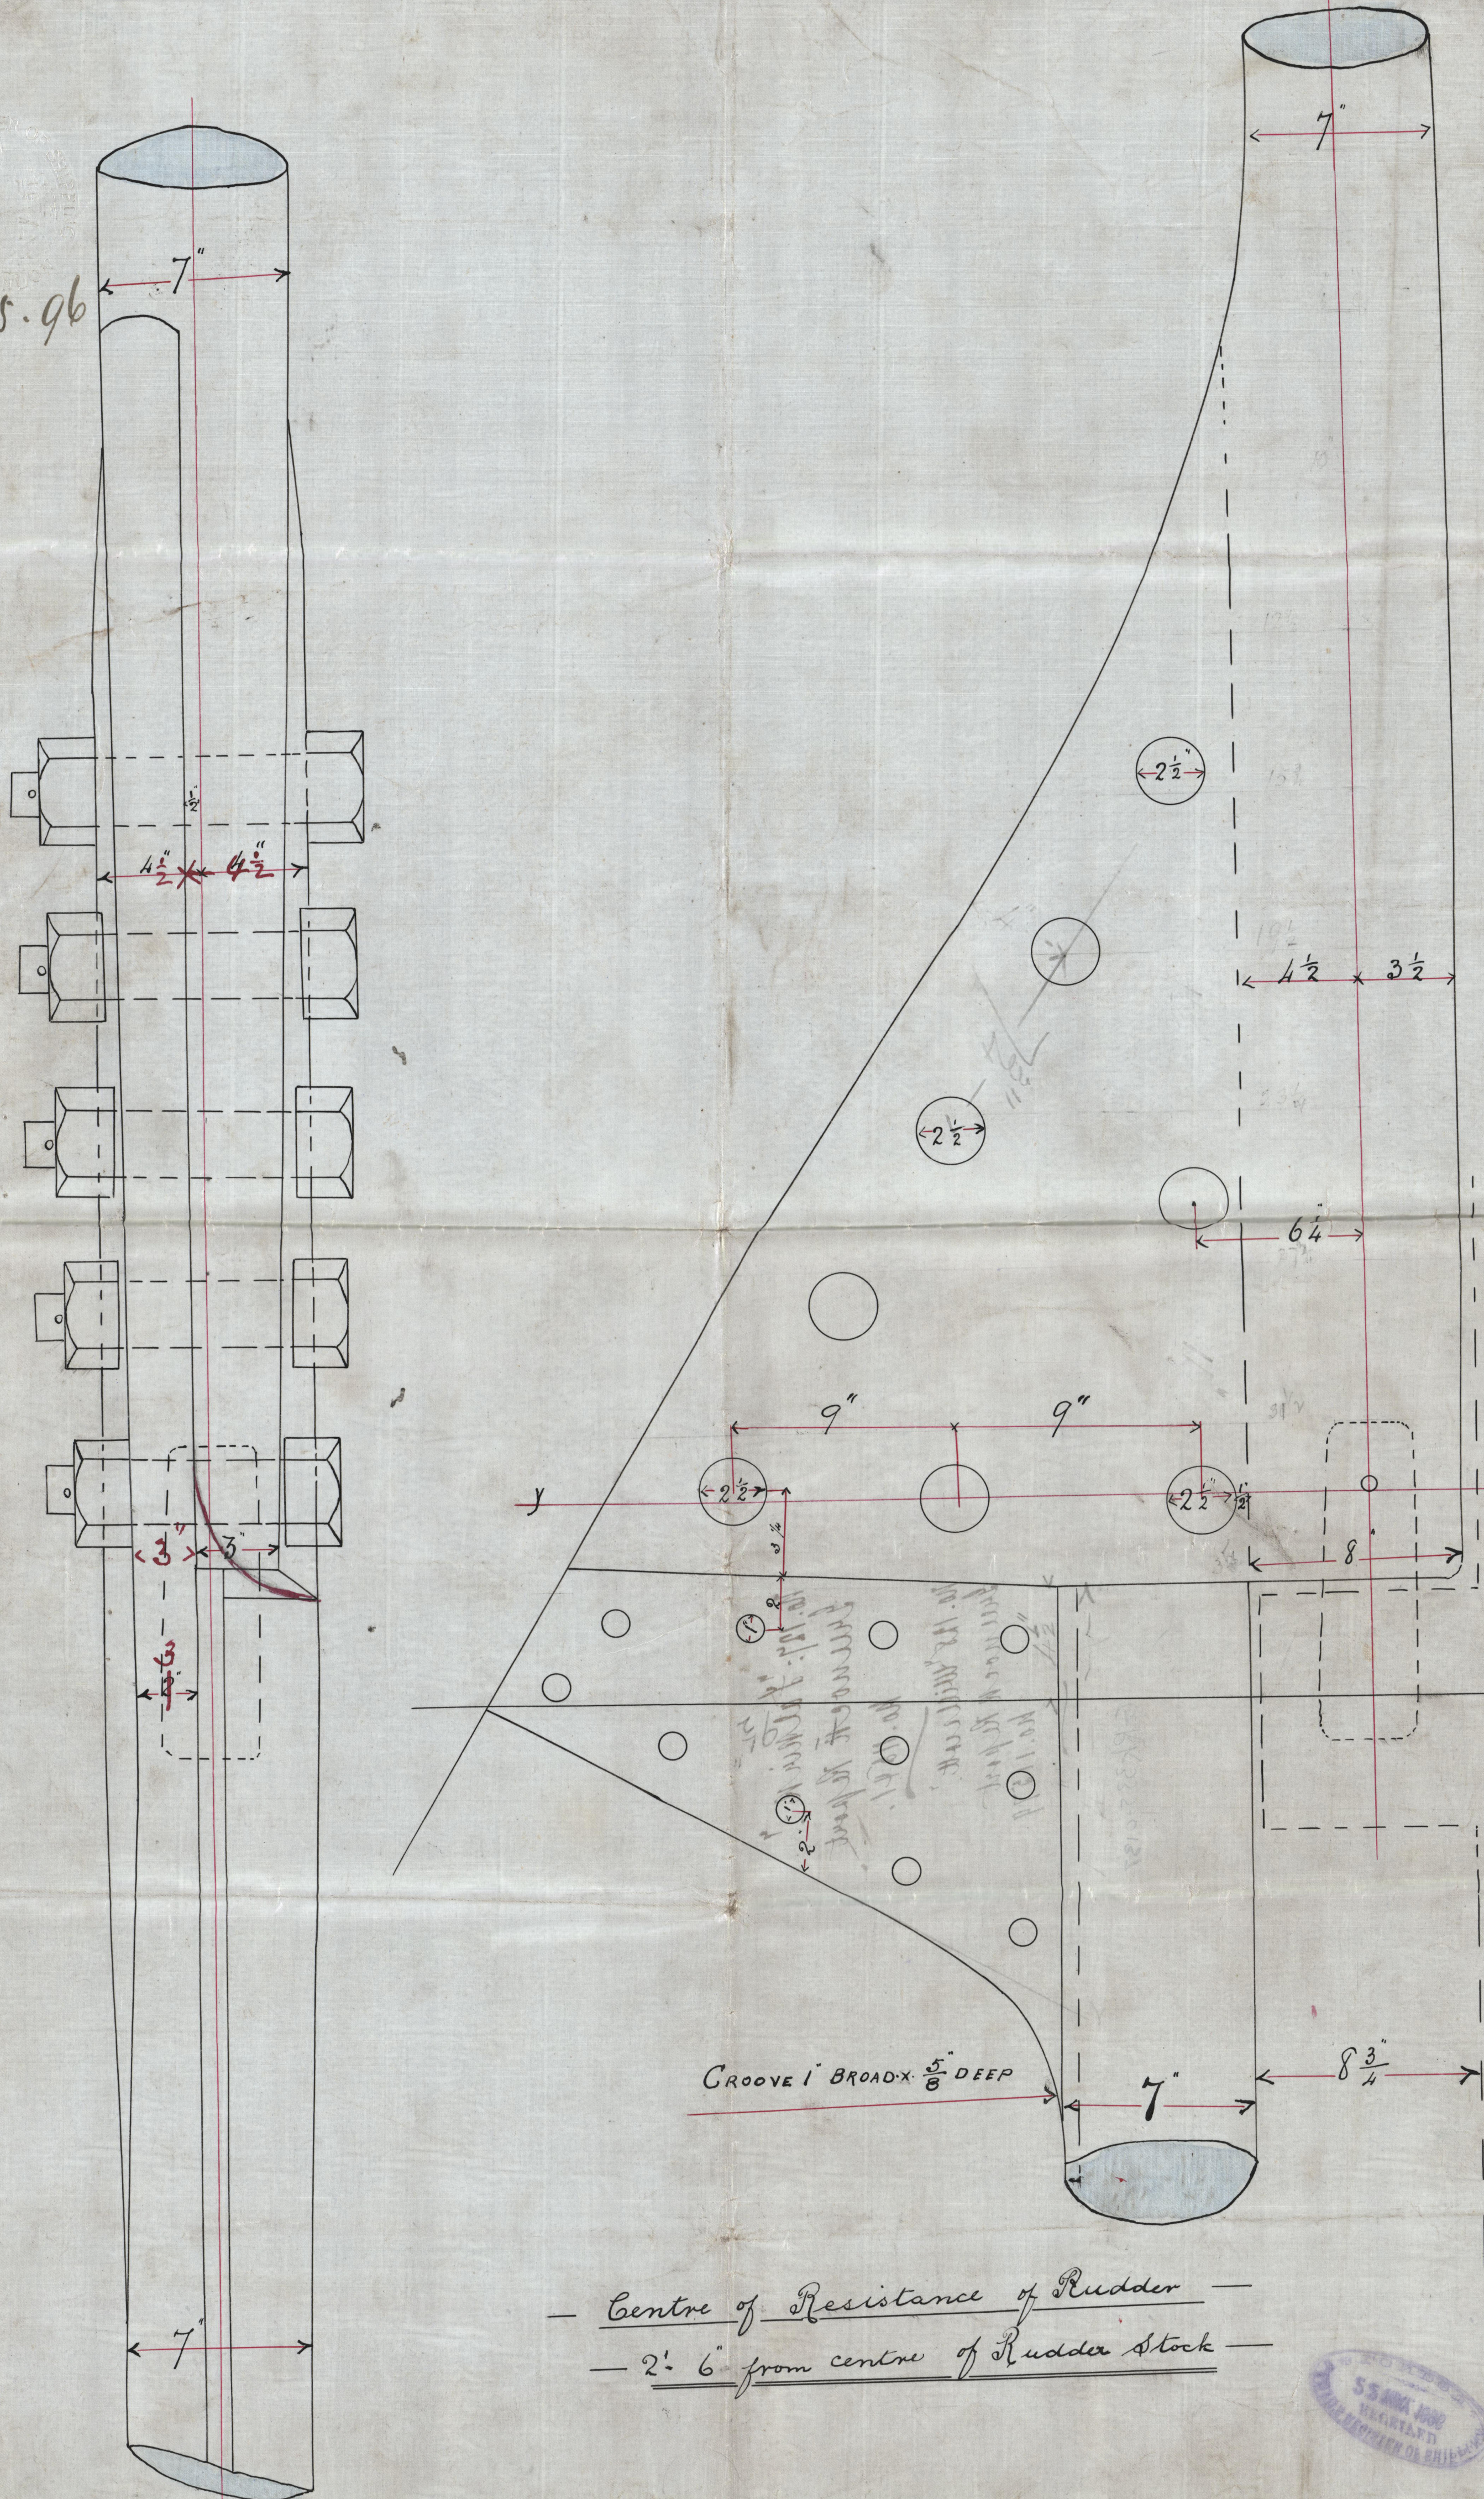


26.5.96

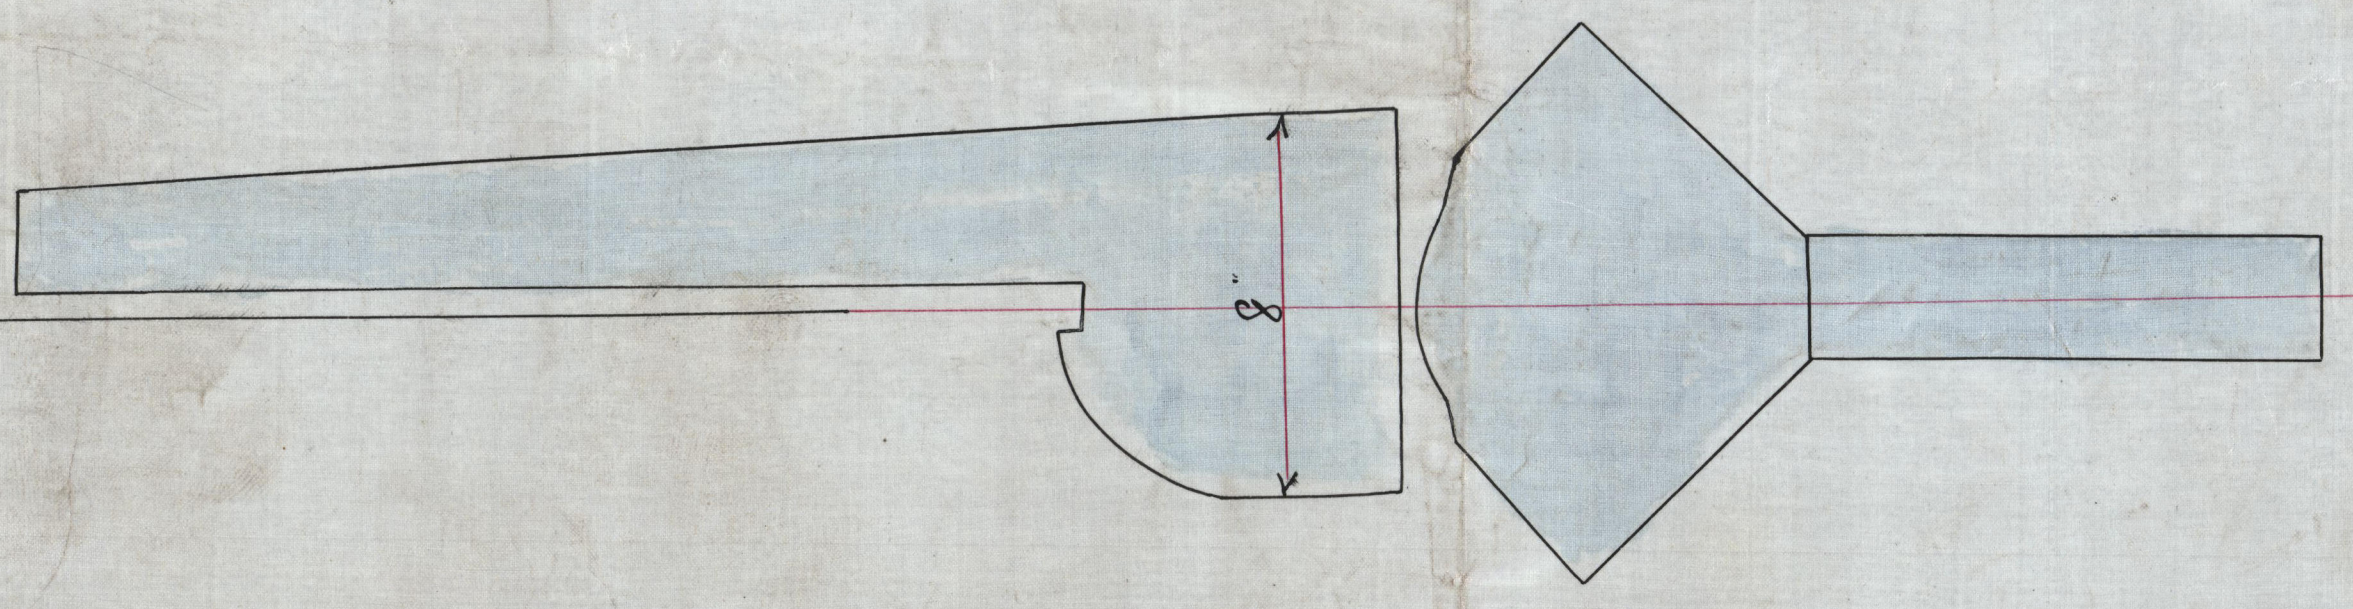

— Centre of Resistance of Rudder —  
 — 2' 6" from centre of Rudder Stock —

— SECTION THRO. X Y —

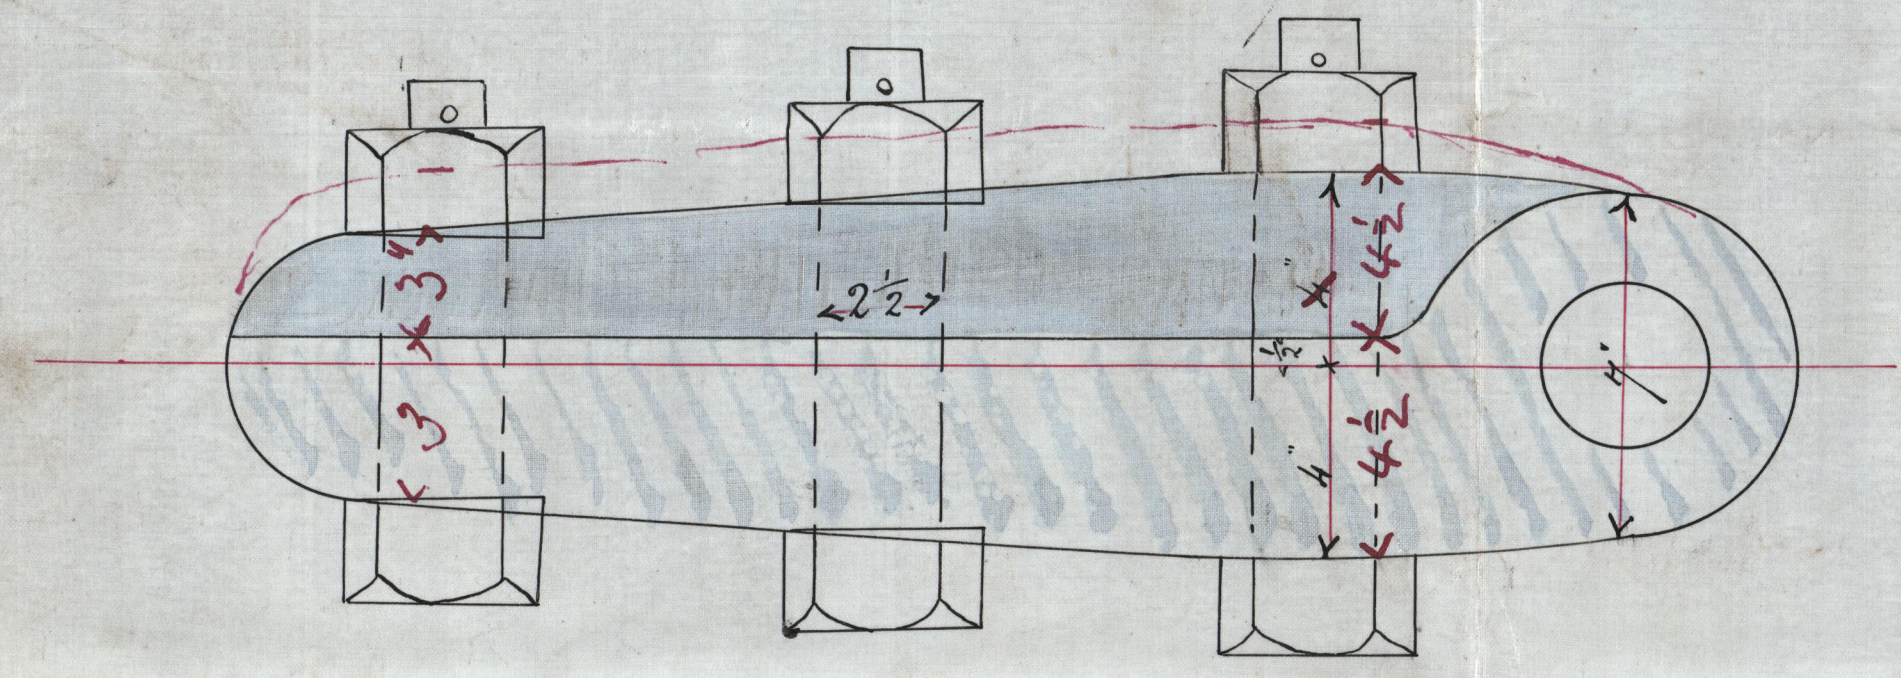

— Sketch of 'PORTLAND' Patent Detachable Coupling —  
 — For Barques No 127 + 8 —  
 — Scale one fourth full size —

23/5/96



© 2020

Lloyd's Register Foundation

GRK335-0137



No. 127: "Falmouth"  
Guano Report  
No. 11541.

No. 128: "Willcott"  
Guano Report  
No. 11579

GRK335-0137








© 2020  
Lloyd's Register  
Foundation