

Received at Greenock office. 1st Sept. 1896.

Lloyd's Register of British and Foreign Shipping.

(Report on Vessel No. 11551 Port Greenock.)
"Bride de Mer"

No. 5349 SHIP FORGINGS OR CASTINGS.

The words FORGINGS or CASTINGS, IRON or STEEL, should be struck out as may be required.

I have to report that the undermentioned Iron or Steel Forgings or Castings, manufactured by Messrs Robt Kerr & Son of Irvine for the Vessel No. 146, being built by Messrs McIndoch & Murray of Port Glasgow have been inspected by me as set forth below, and found to be, so far as can be seen, Sound & efficient


Mark on Forgings.

Lloyd's
No. 5349
W.H

William Hamilton
Glasgow 29/8/96

	STERN FRAME.	RUDDER FRAME.	STEM.
Material*		<u>Scrap iron</u>	
How made		<u>Forged</u>	
Dimensions		<u>4 to 2 pintles</u>	
Progress on Inspection		<u>Forging & smithing</u>	
Date when Inspected		<u>4 to 25/8/96</u>	

SKETCHES OF FRAMES SHOWING POSITION AND DESCRIPTION OF WELDS OF FORGINGS, OR PARTICULARS OF TESTS APPLIED TO CASTINGS.

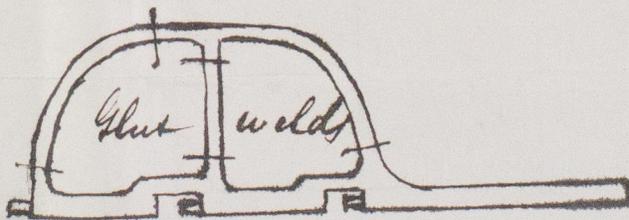

Fee (if any chargeable) £ : :

To be paid at _____



© 2020

Lloyd's Register
Foundation

* If of Iron, state whether scrap or puddled Iron.

