





4.7.96

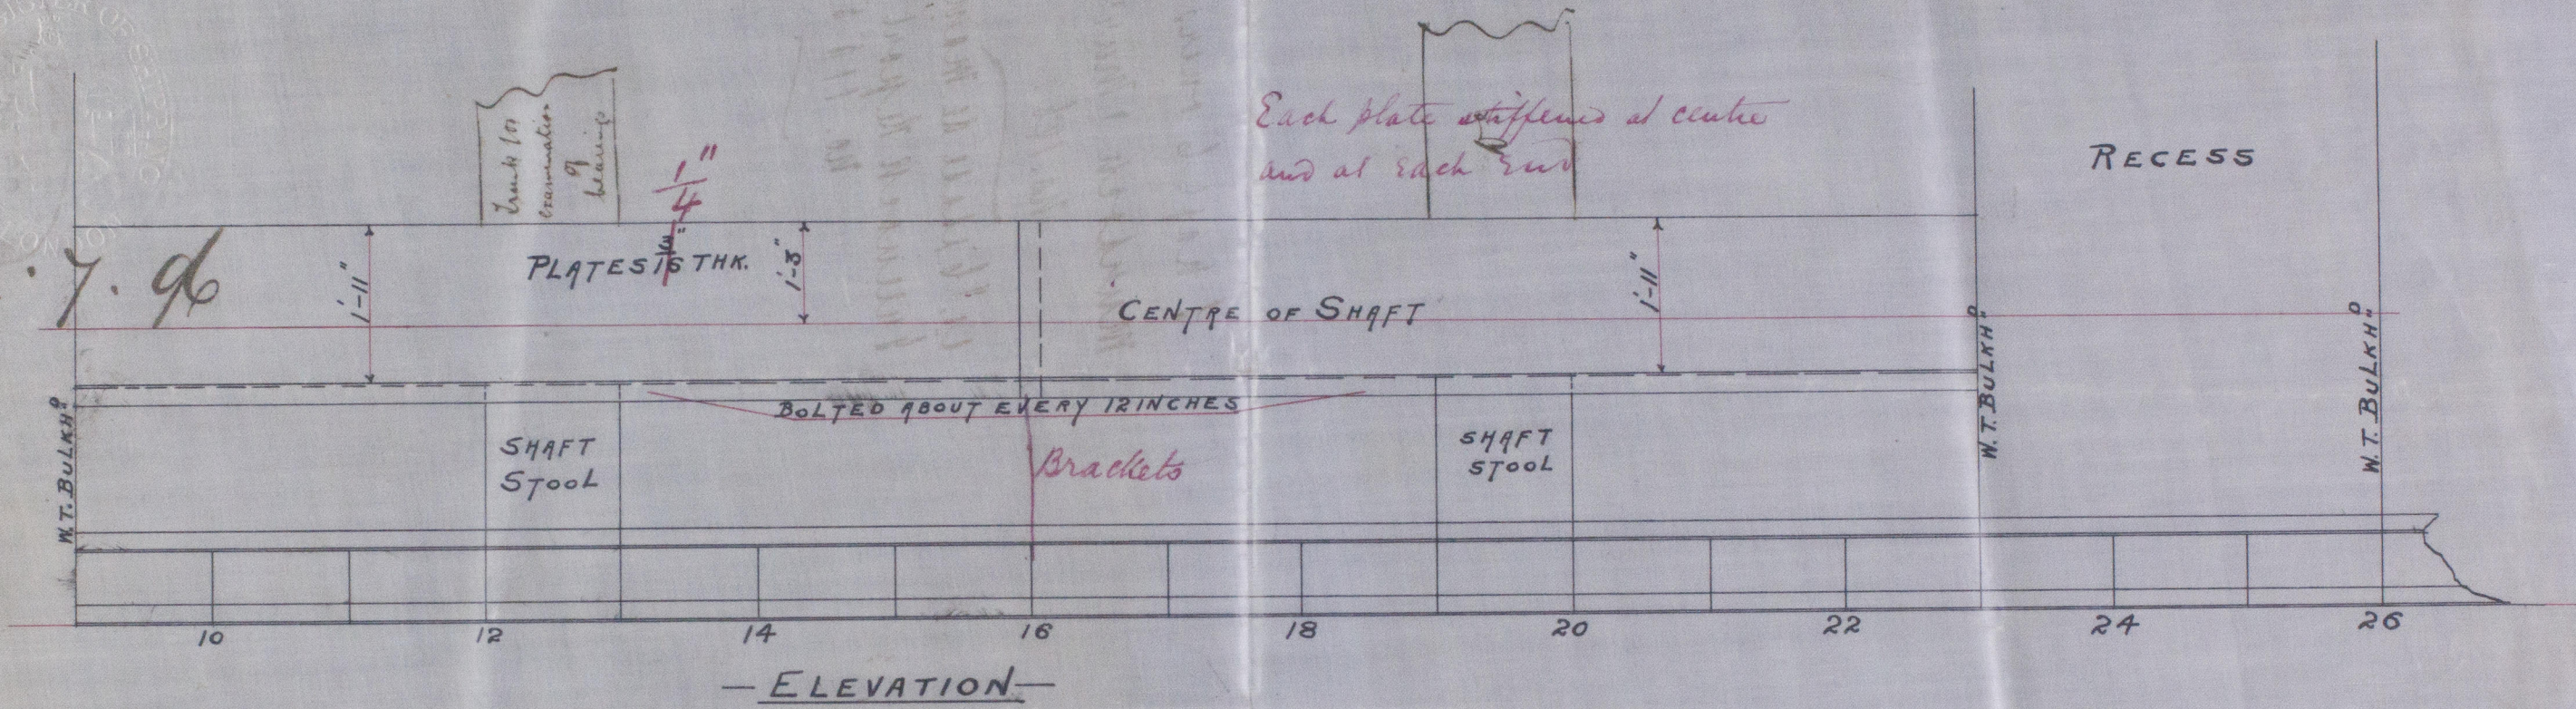

— SKETCH OF SHAFT COVERS —

— T.S.S. N° 146 —  
— SCALE 1/2 INCH = 1 FOOT —  
— DRAWING N° 3106 —

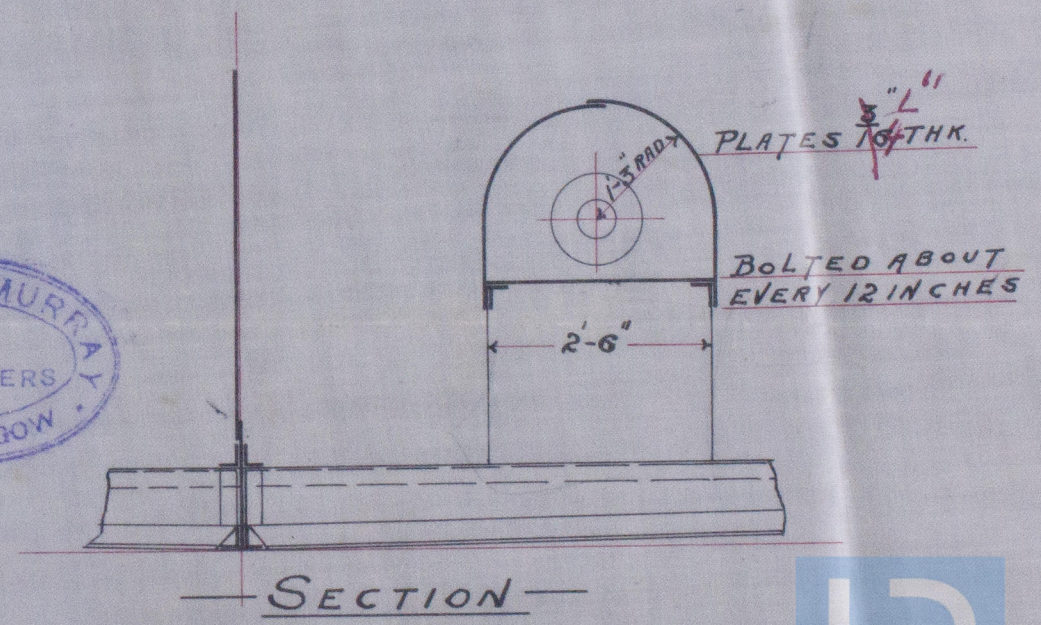

JIM  
4/7/96





SECTION

DEMAND V. 2108

SCALE 1/2 INCH = 1 FOOT

2108 V. 2108


ELEVATION





1 hapt 6 rurs  
Murdock & Murray  
No. 146.

No. 11553.

GRK 335-0156

1000

© 2020

Lloyd's Register  
Foundation