


Ref 141 July 1896

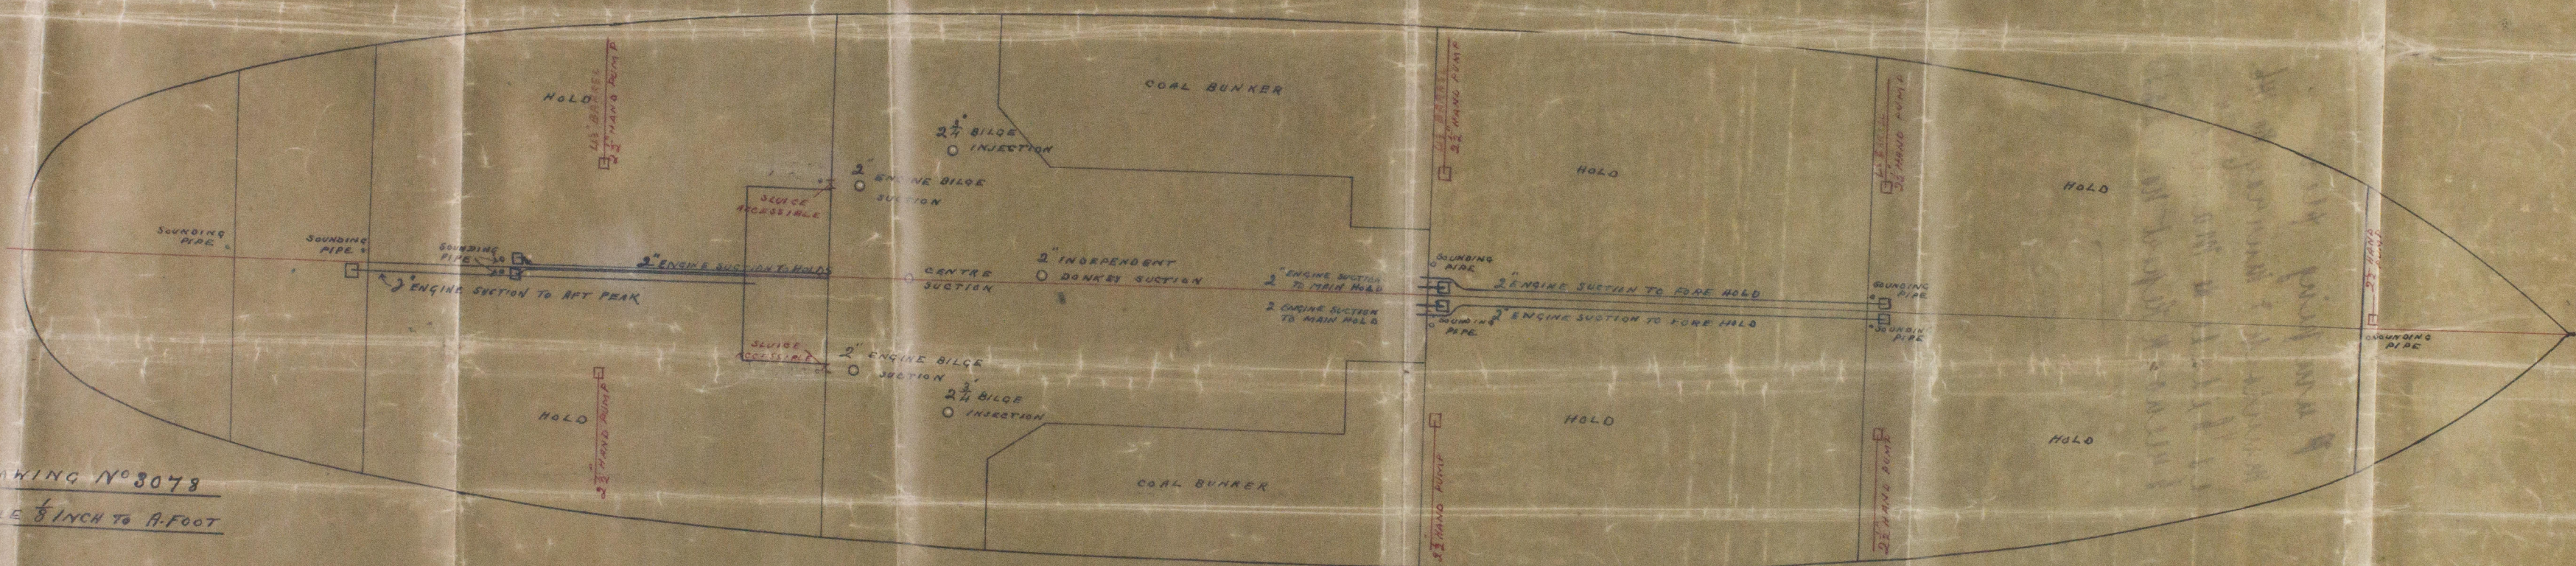

PUMPING ARRANGEMENT
TWIN SCREW STEAMER
N 146



DRAWING N° 3078
SCALE 1/8 INCH TO A FOOT

141 July 1896



© 2020
dam
141 July 1896

GRK335-0157

 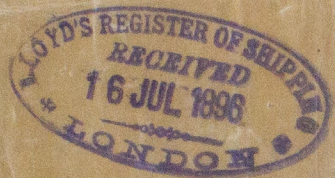

Pumping plan
Munroch & Murray No. 146.
Munroch Report No. 11552.

GRK335-0157



© 2020

Lloyd's Register
Foundation