

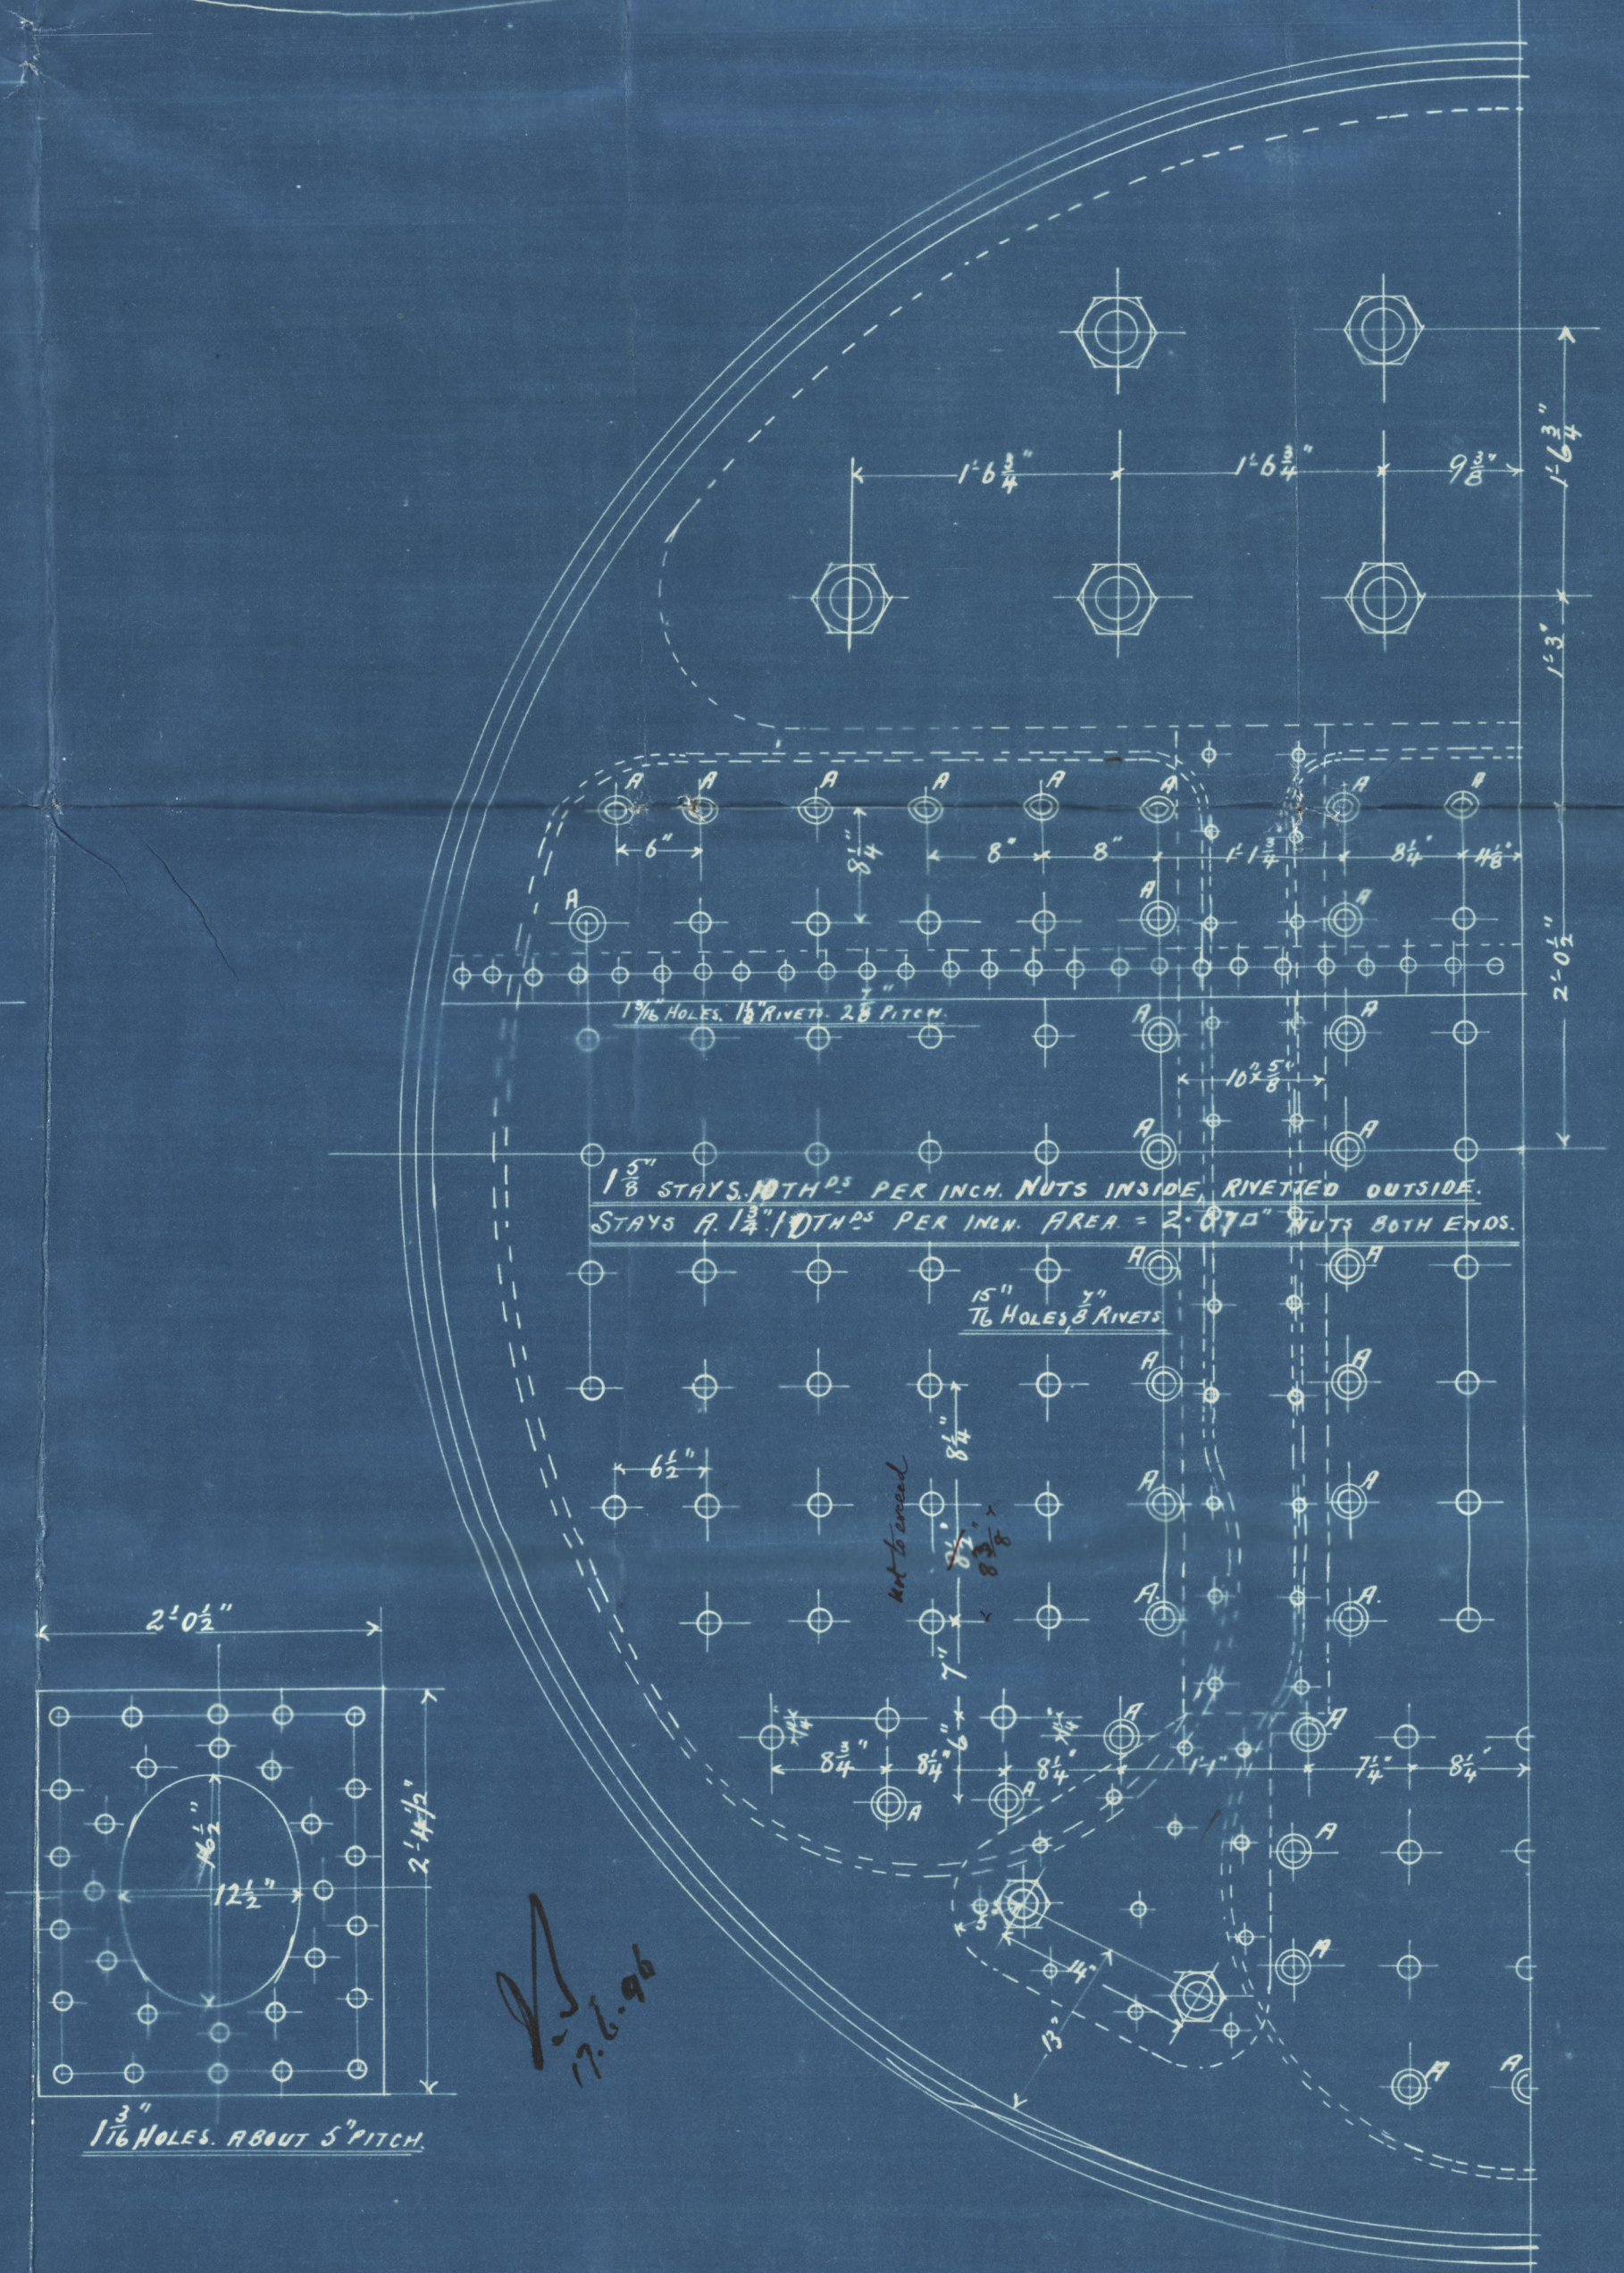


24  
19.6.96

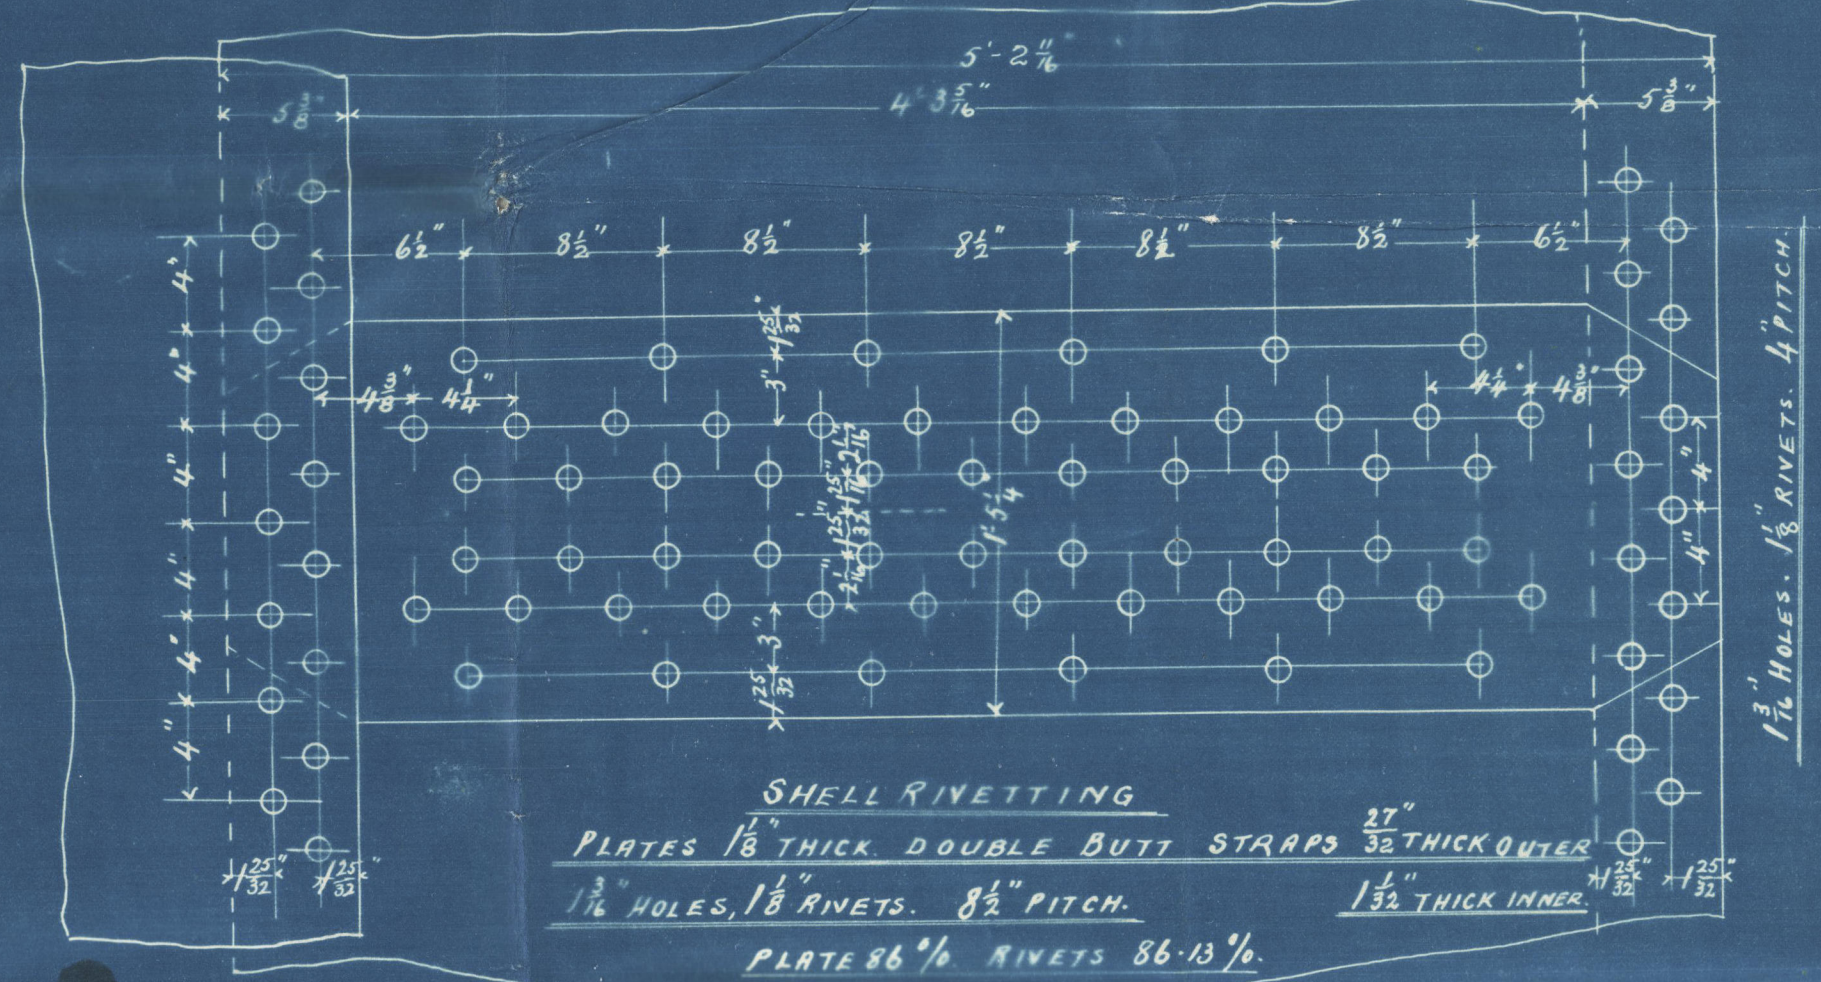

from pitch of stay tubes  
not to exceed 1 1/2"  
no body tubes plates to be 27" thick with stays as shown

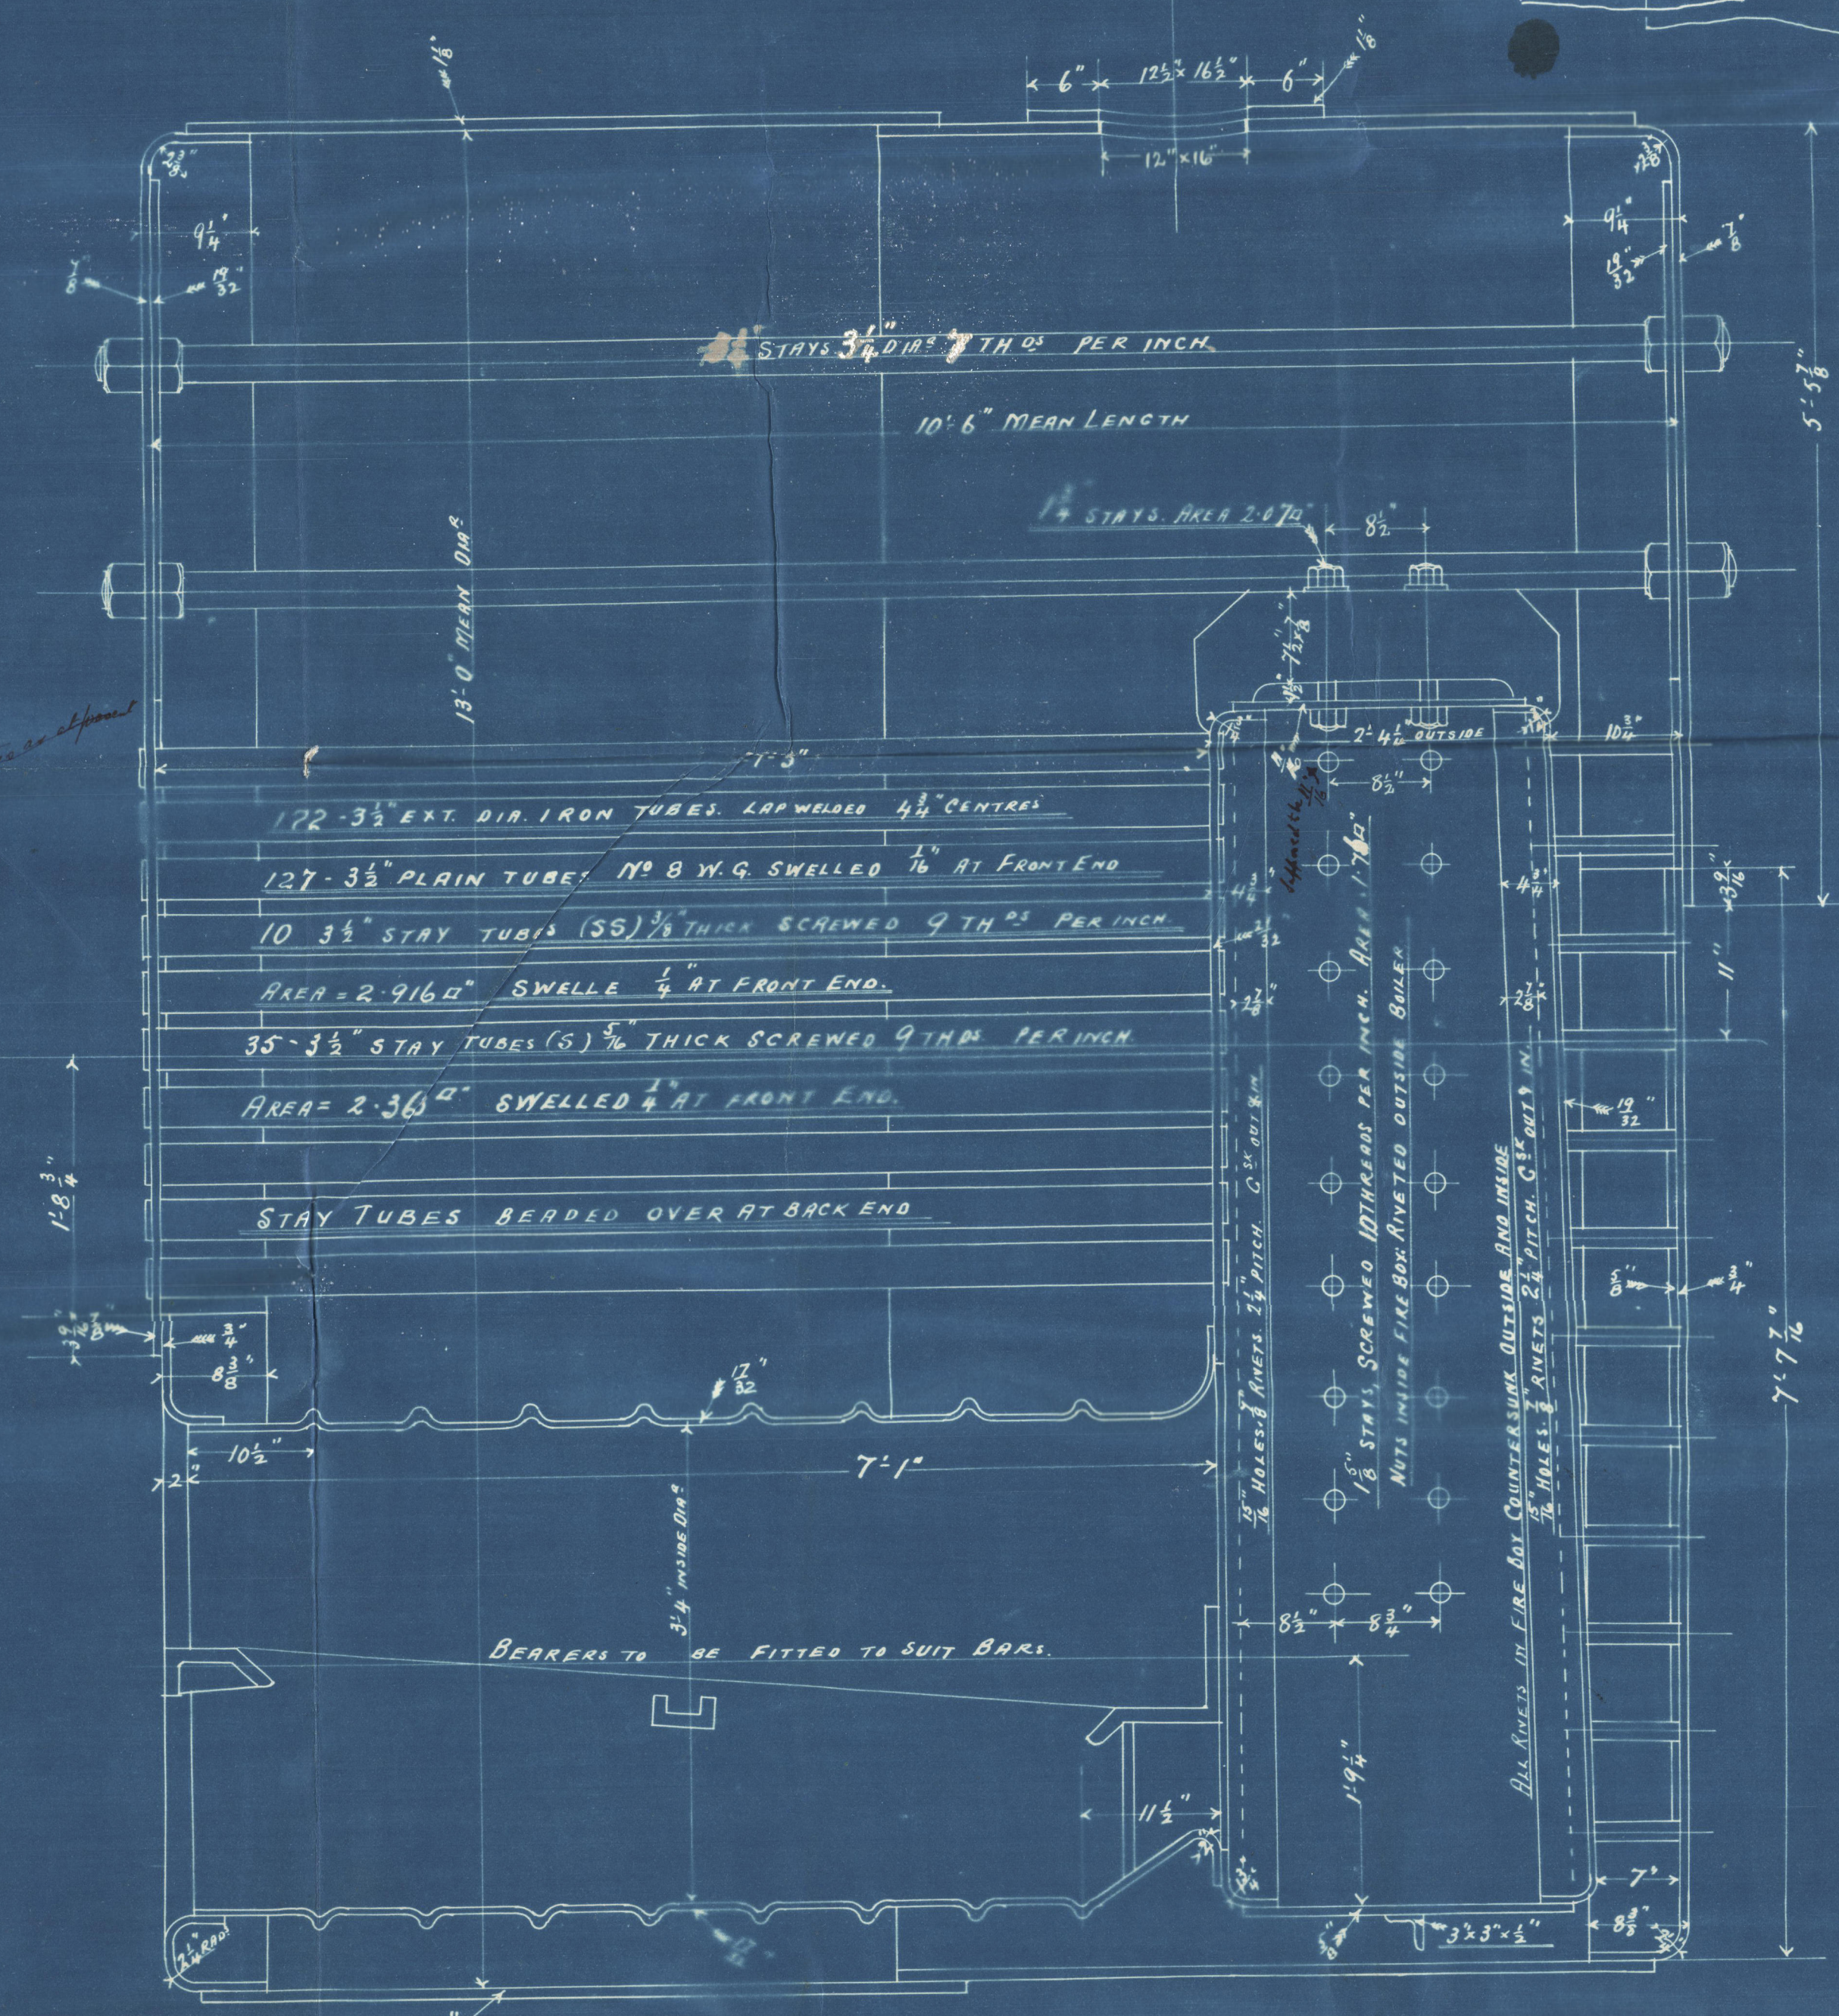

ALL LARGE HOLES TO BE CUT AND PLANNED SADDLES FITTED FOR  
STOP AND SAFETY VALVES. ANGLE BARS AT SIDES AND BACK FOR SECURING COMPOSITION.  
PLATES, RIVETS & STAYS OF STEEL  
TUBES OF IRON

BOILER N<sup>o</sup> 683.

MARINE BOILER 13' 0" MEAN DIA. X 10' 6" MEAN LENGTH


TO PASS LLOYD'S FOR 175 LBS WORKING PRESSURE

SCALE 1/4" = 1' FOOT.



GRK335-0179



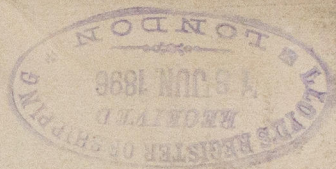

683

Ross & Duncan

"Rio Affua"

Guano Report  
No 11566.



© 2020

Lloyd's Register  
Foundation

GRK 335-0179