


Horizontal Multitubular Steel Donkey Boiler 4-9 Diam x 5-6 long.

Stogas Survey 80 lbs W.P. Hydraulic Test 160 lbs.

For Messrs John S. Kincaid & Co. No. 256, Greenwich.

Boiler No. 2161.

Scale 1" = 1 foot.

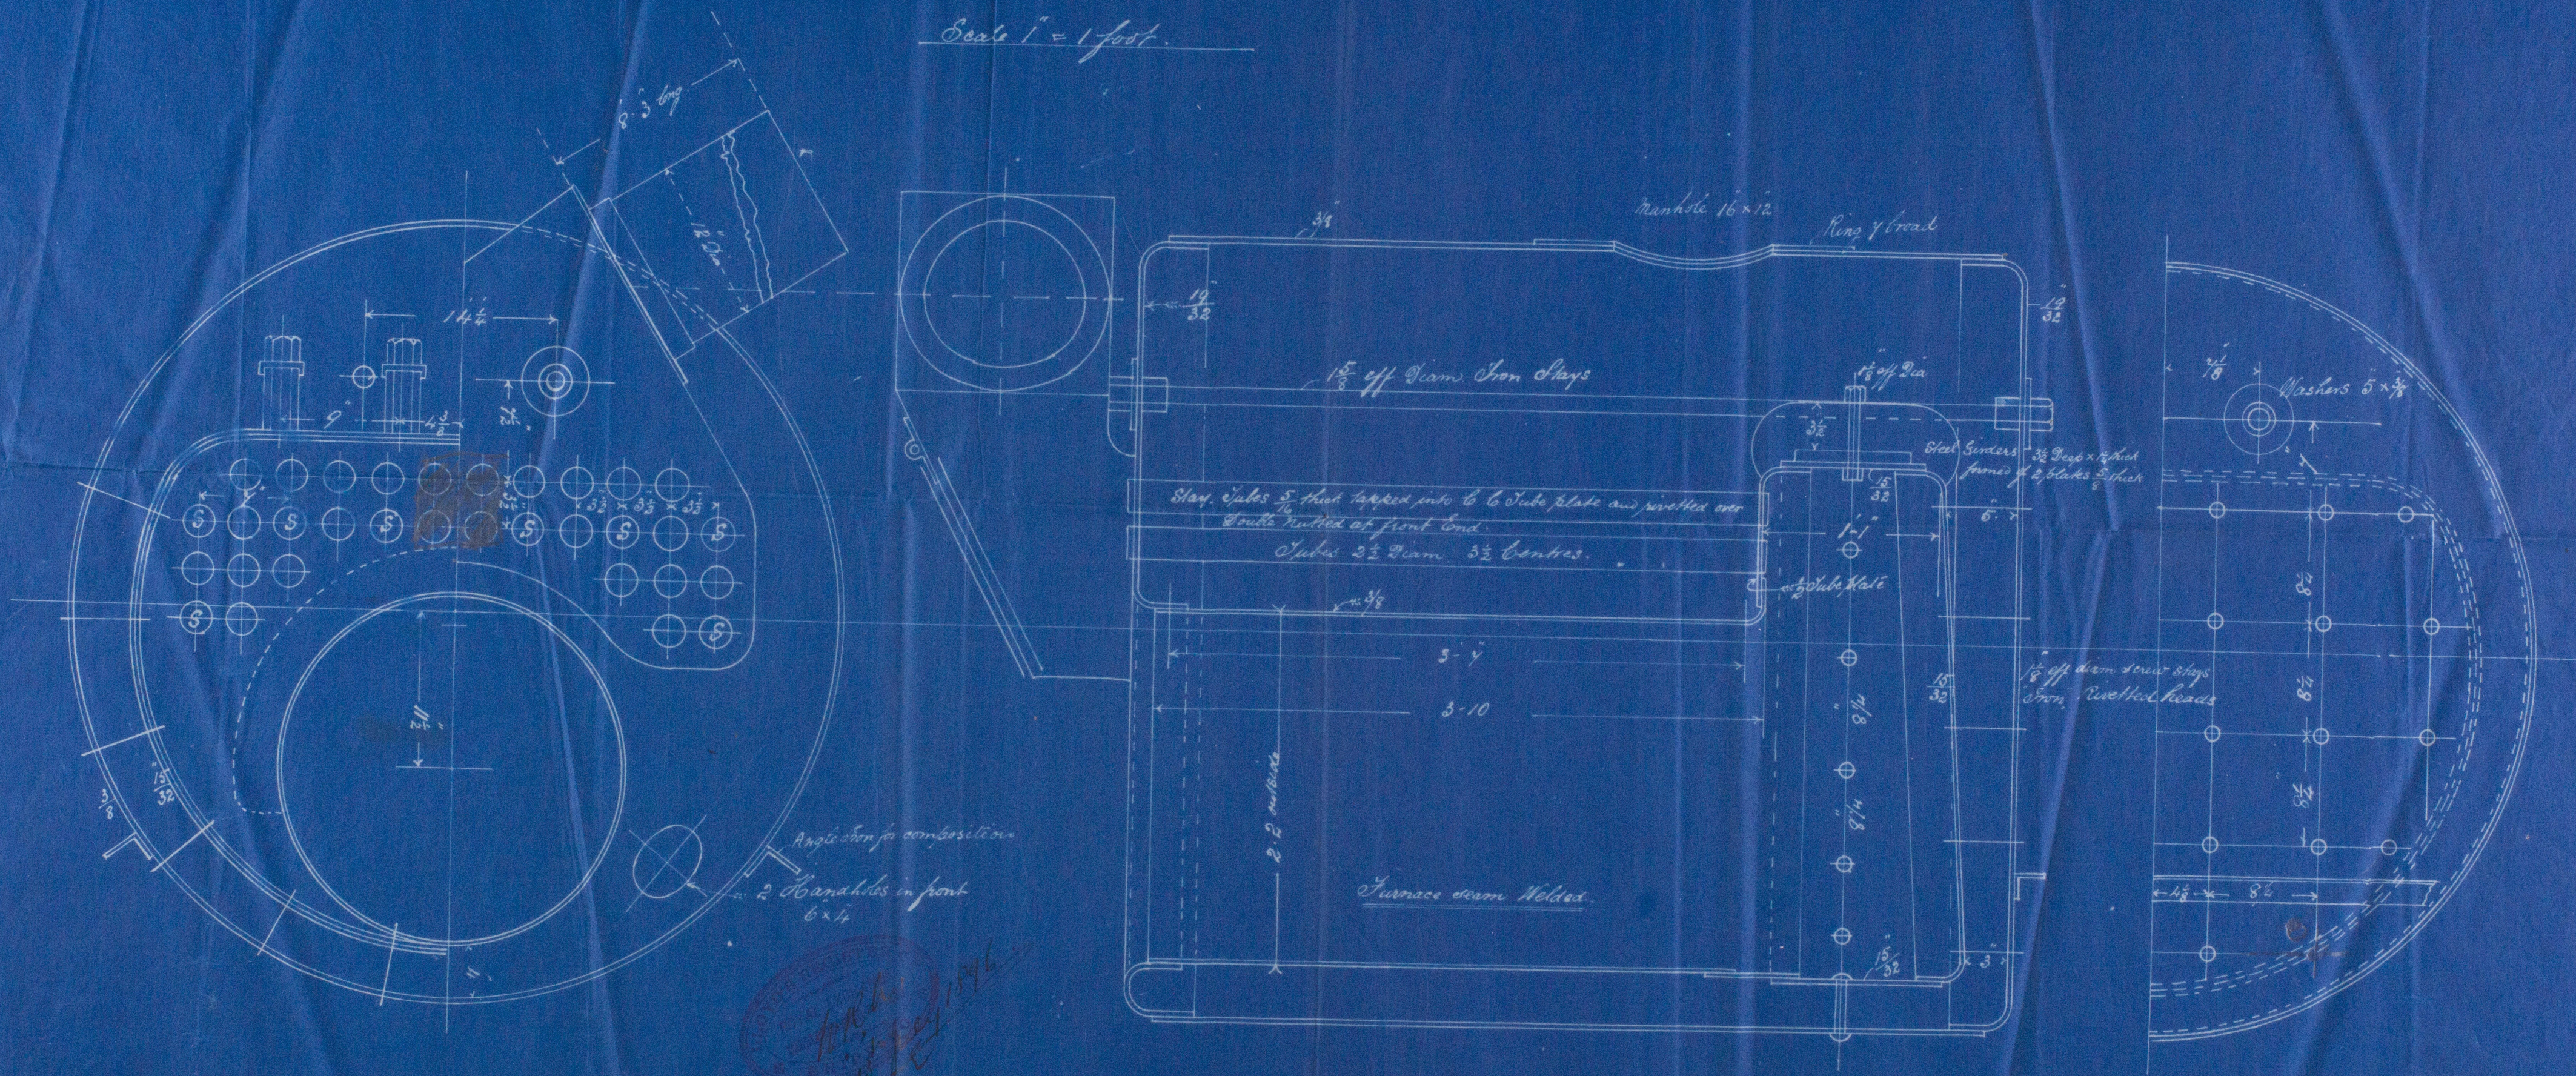

Longitudinal seam in shell lap jointed Double riveted 13/16 tubes 2 13/16 pitch Width of Lap 4 1/2

Circumferential seams " " and rest of boiler single " " " 2 " " " 2 1/2

Steel plates and Steel rivets. (Simon Martin)



CHAS. J. B. & CO. 1896

For " Rio affua "

Mess. H. Keneaid & Co

No 256 ~~London~~ London

80th Working press

Greenock Report

No 11566

GRK 335-0180



© 2020

Lloyd's Register
Foundation