


24.7.96


24/7/96

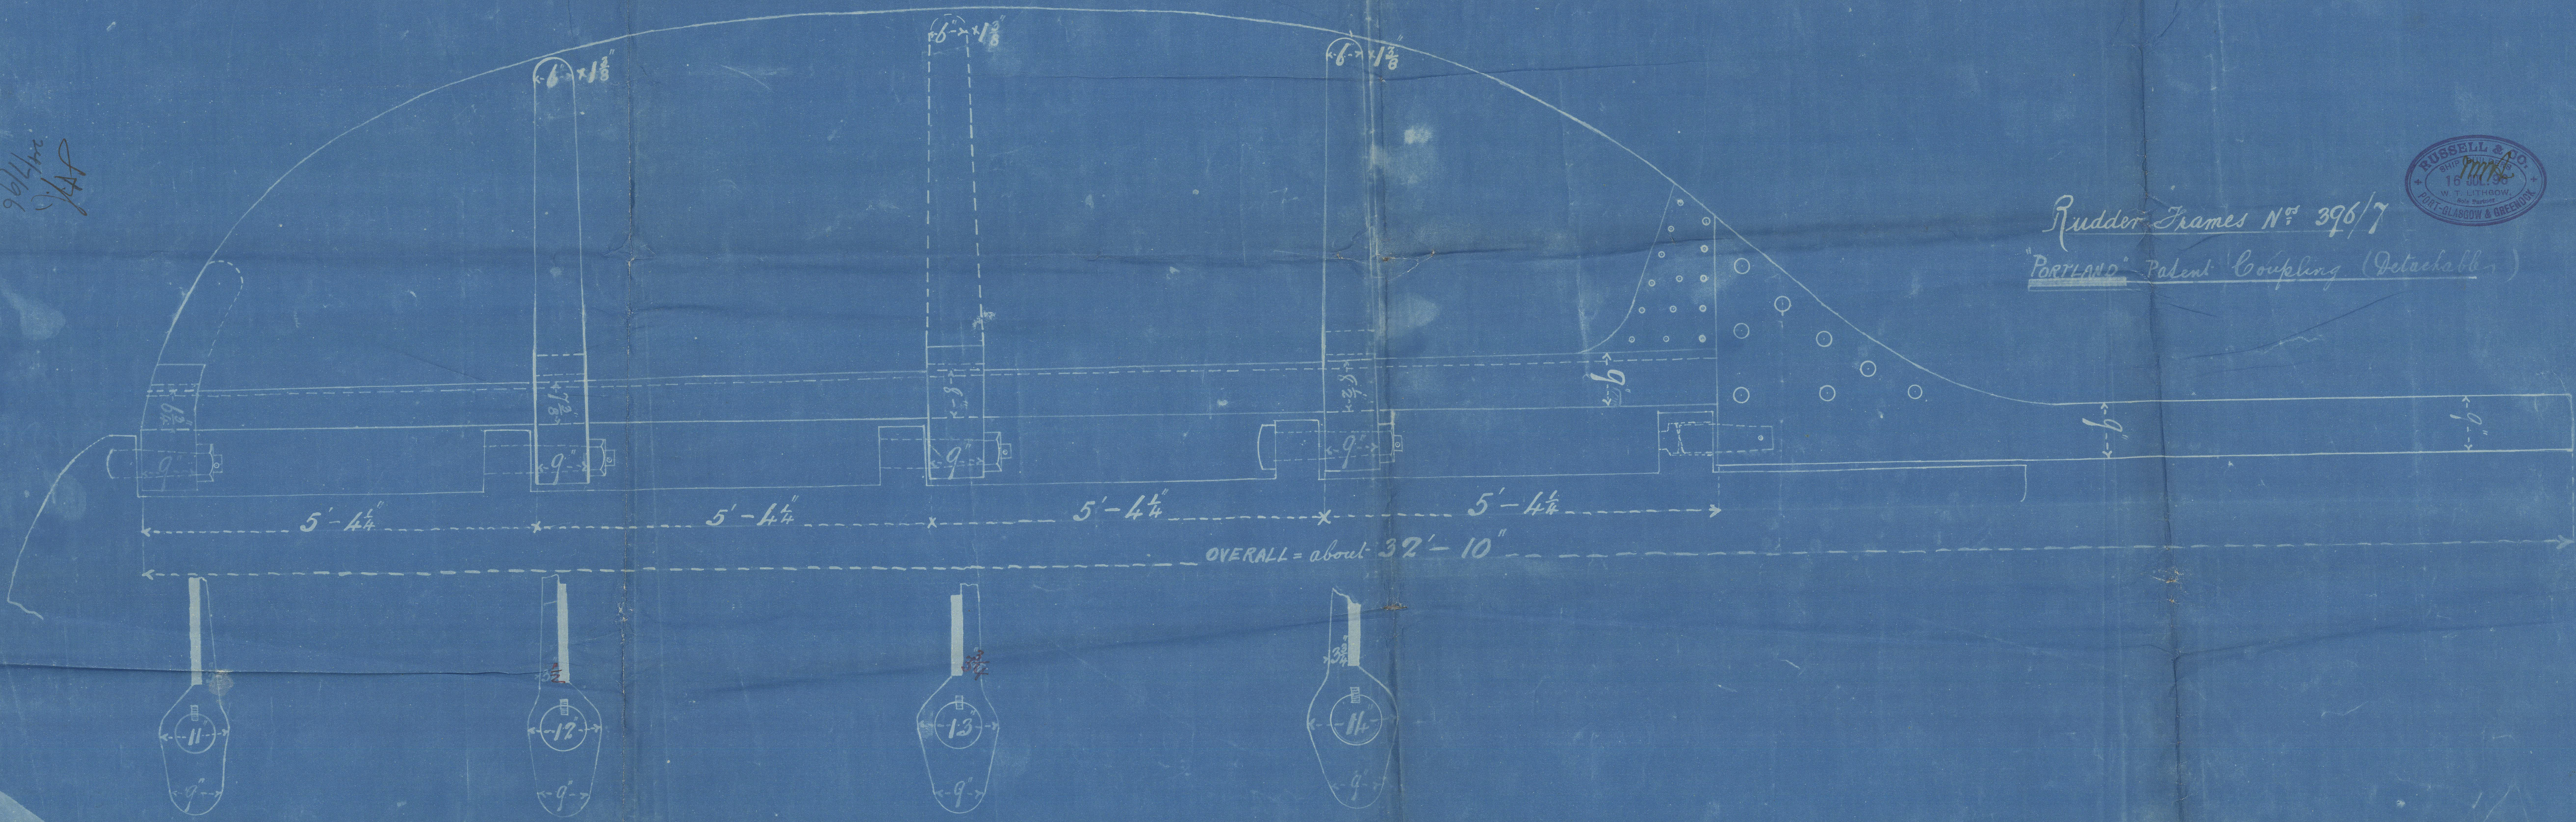

Rudder Frames N^o 396/7
"PORTLAND" Patent Coupling (Detachable)



572 536-0069

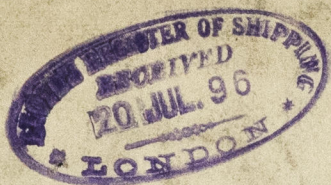

Rudder

Russell nos. 396 & 397

N. 396 : SS. "Ceres"

Grk Report N. 11601.

N. 397. SS. "Minerva"

Grk Report N. 11630.



© 2021

Lloyd's Register
Foundation

GRK396-0049