

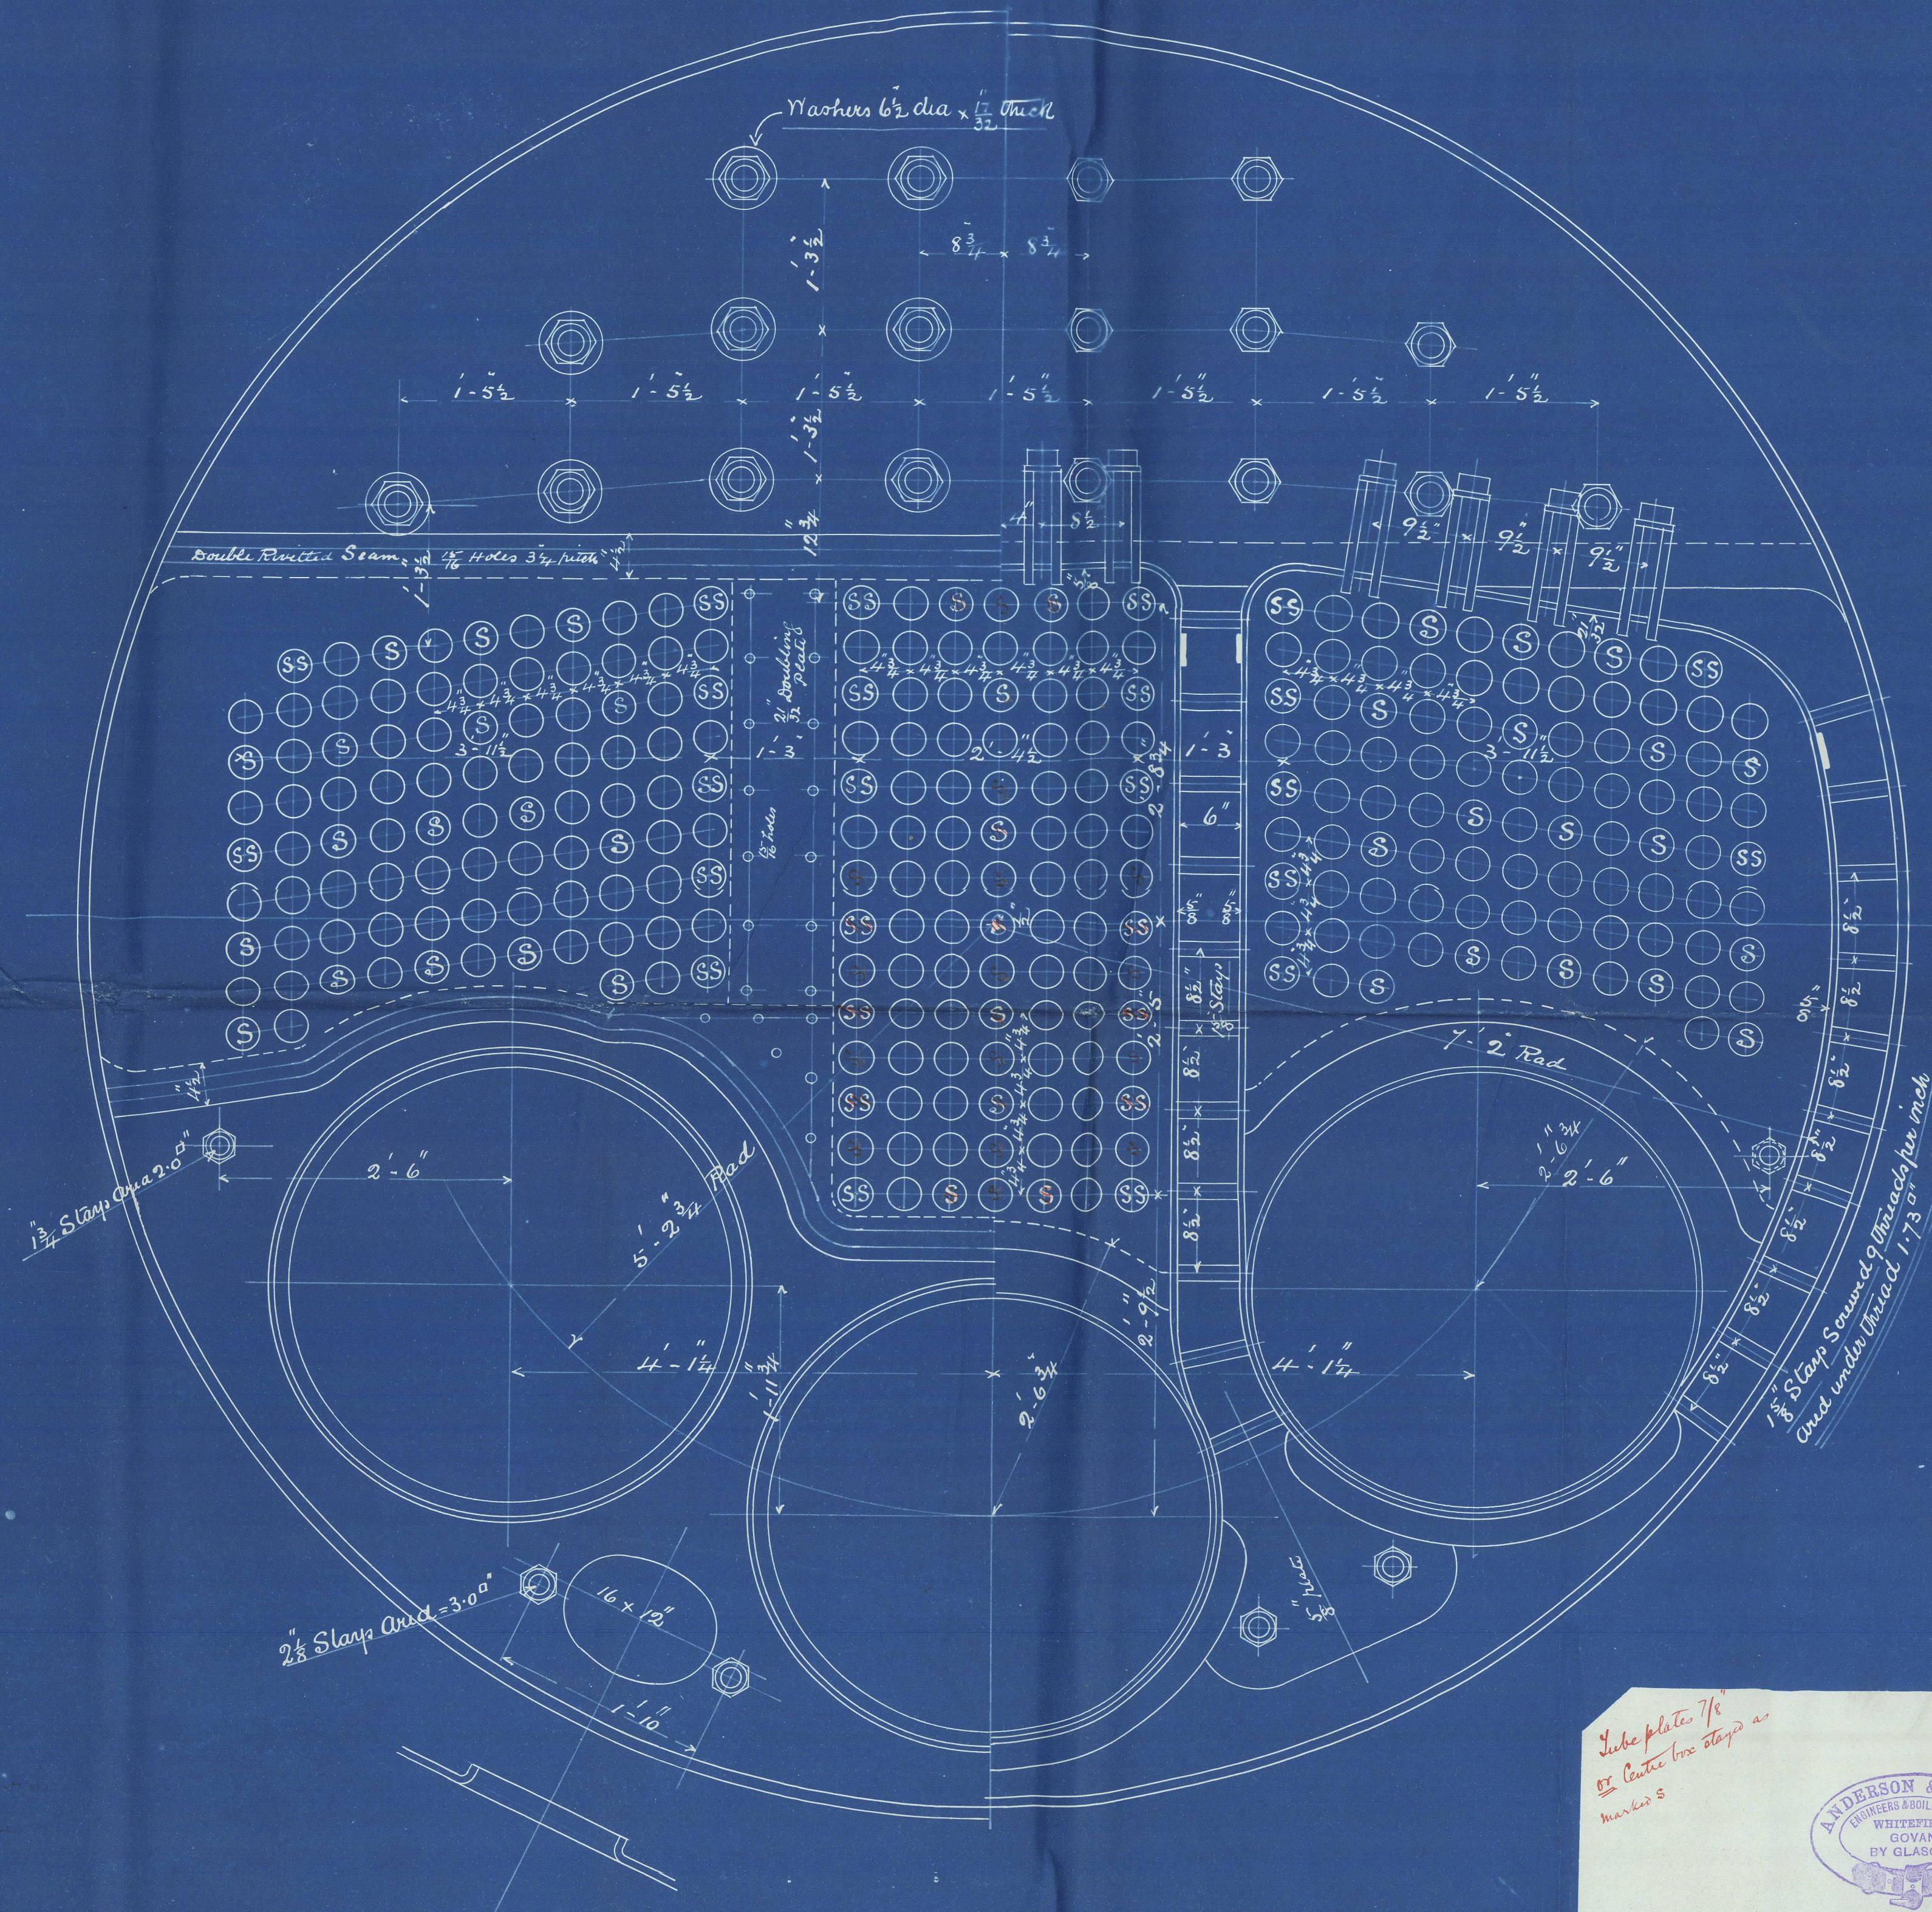



7.4.96

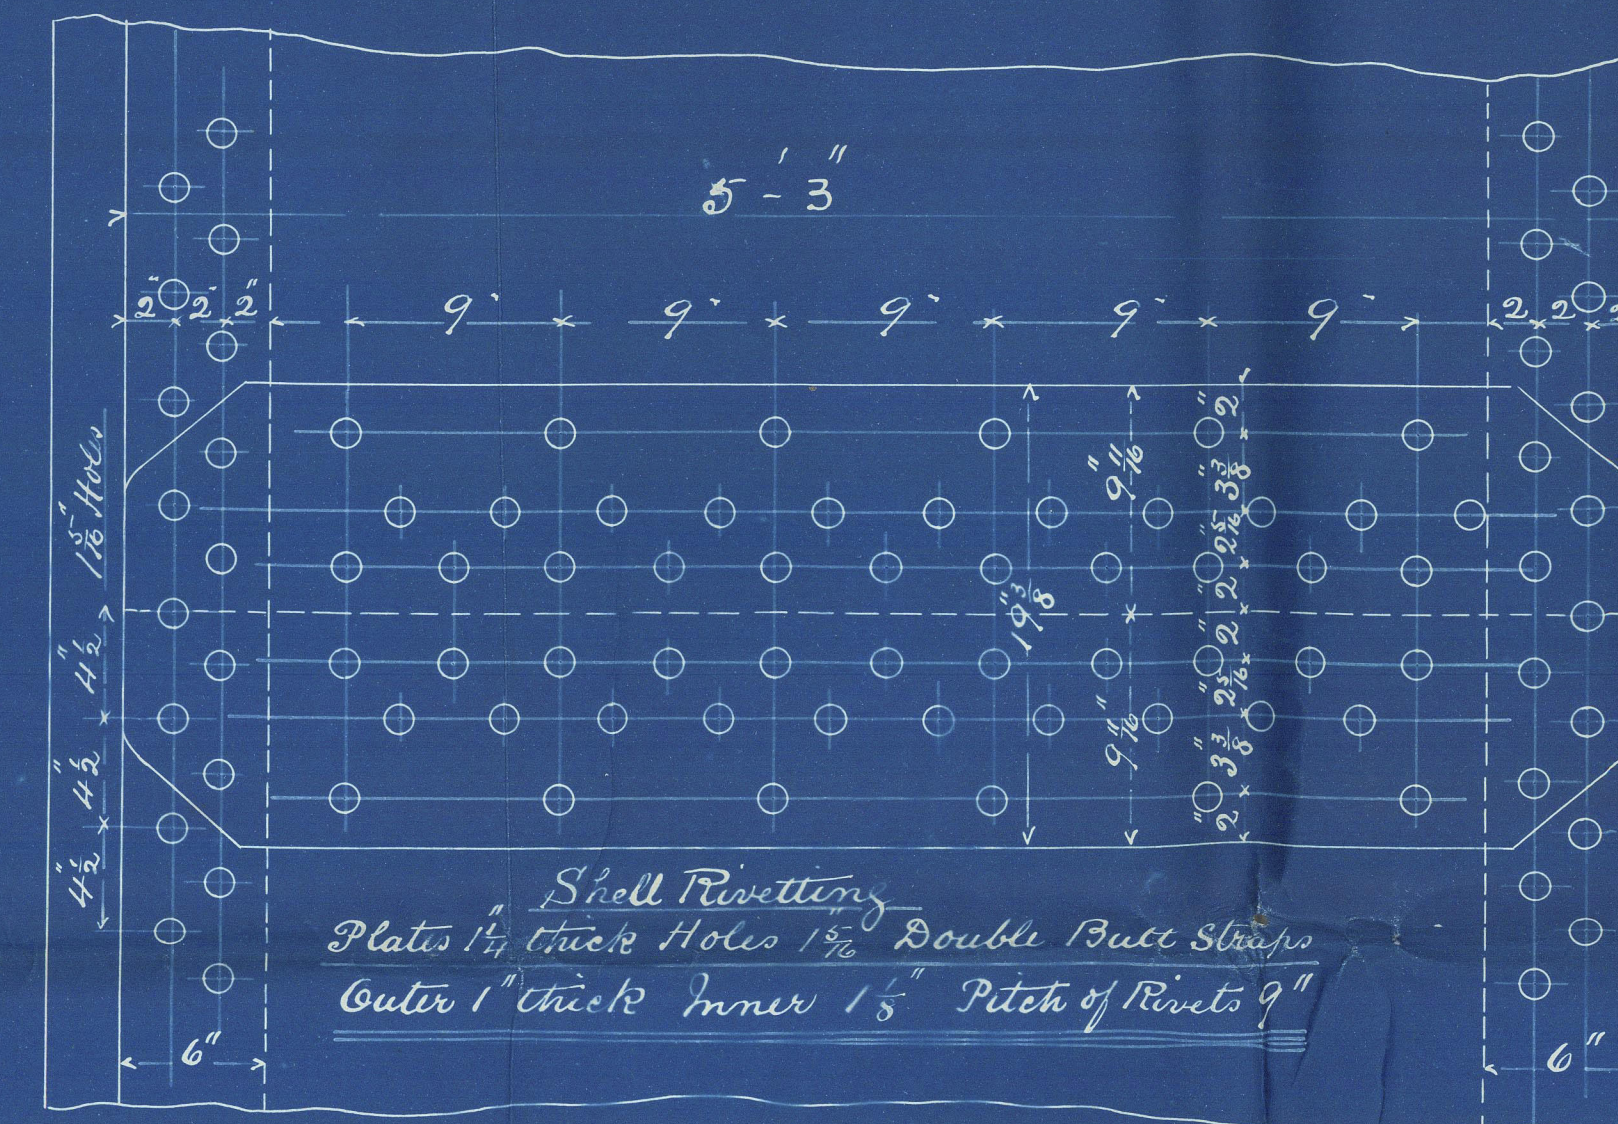

Tube plates 1/2
to outer two stays as
marked &
Anderson & Lyall
Engineers
Whitehill
Glasgow
1st April 1896
Tube plates 1/2 thick
and outer two stays
as marked & N.Y.R.

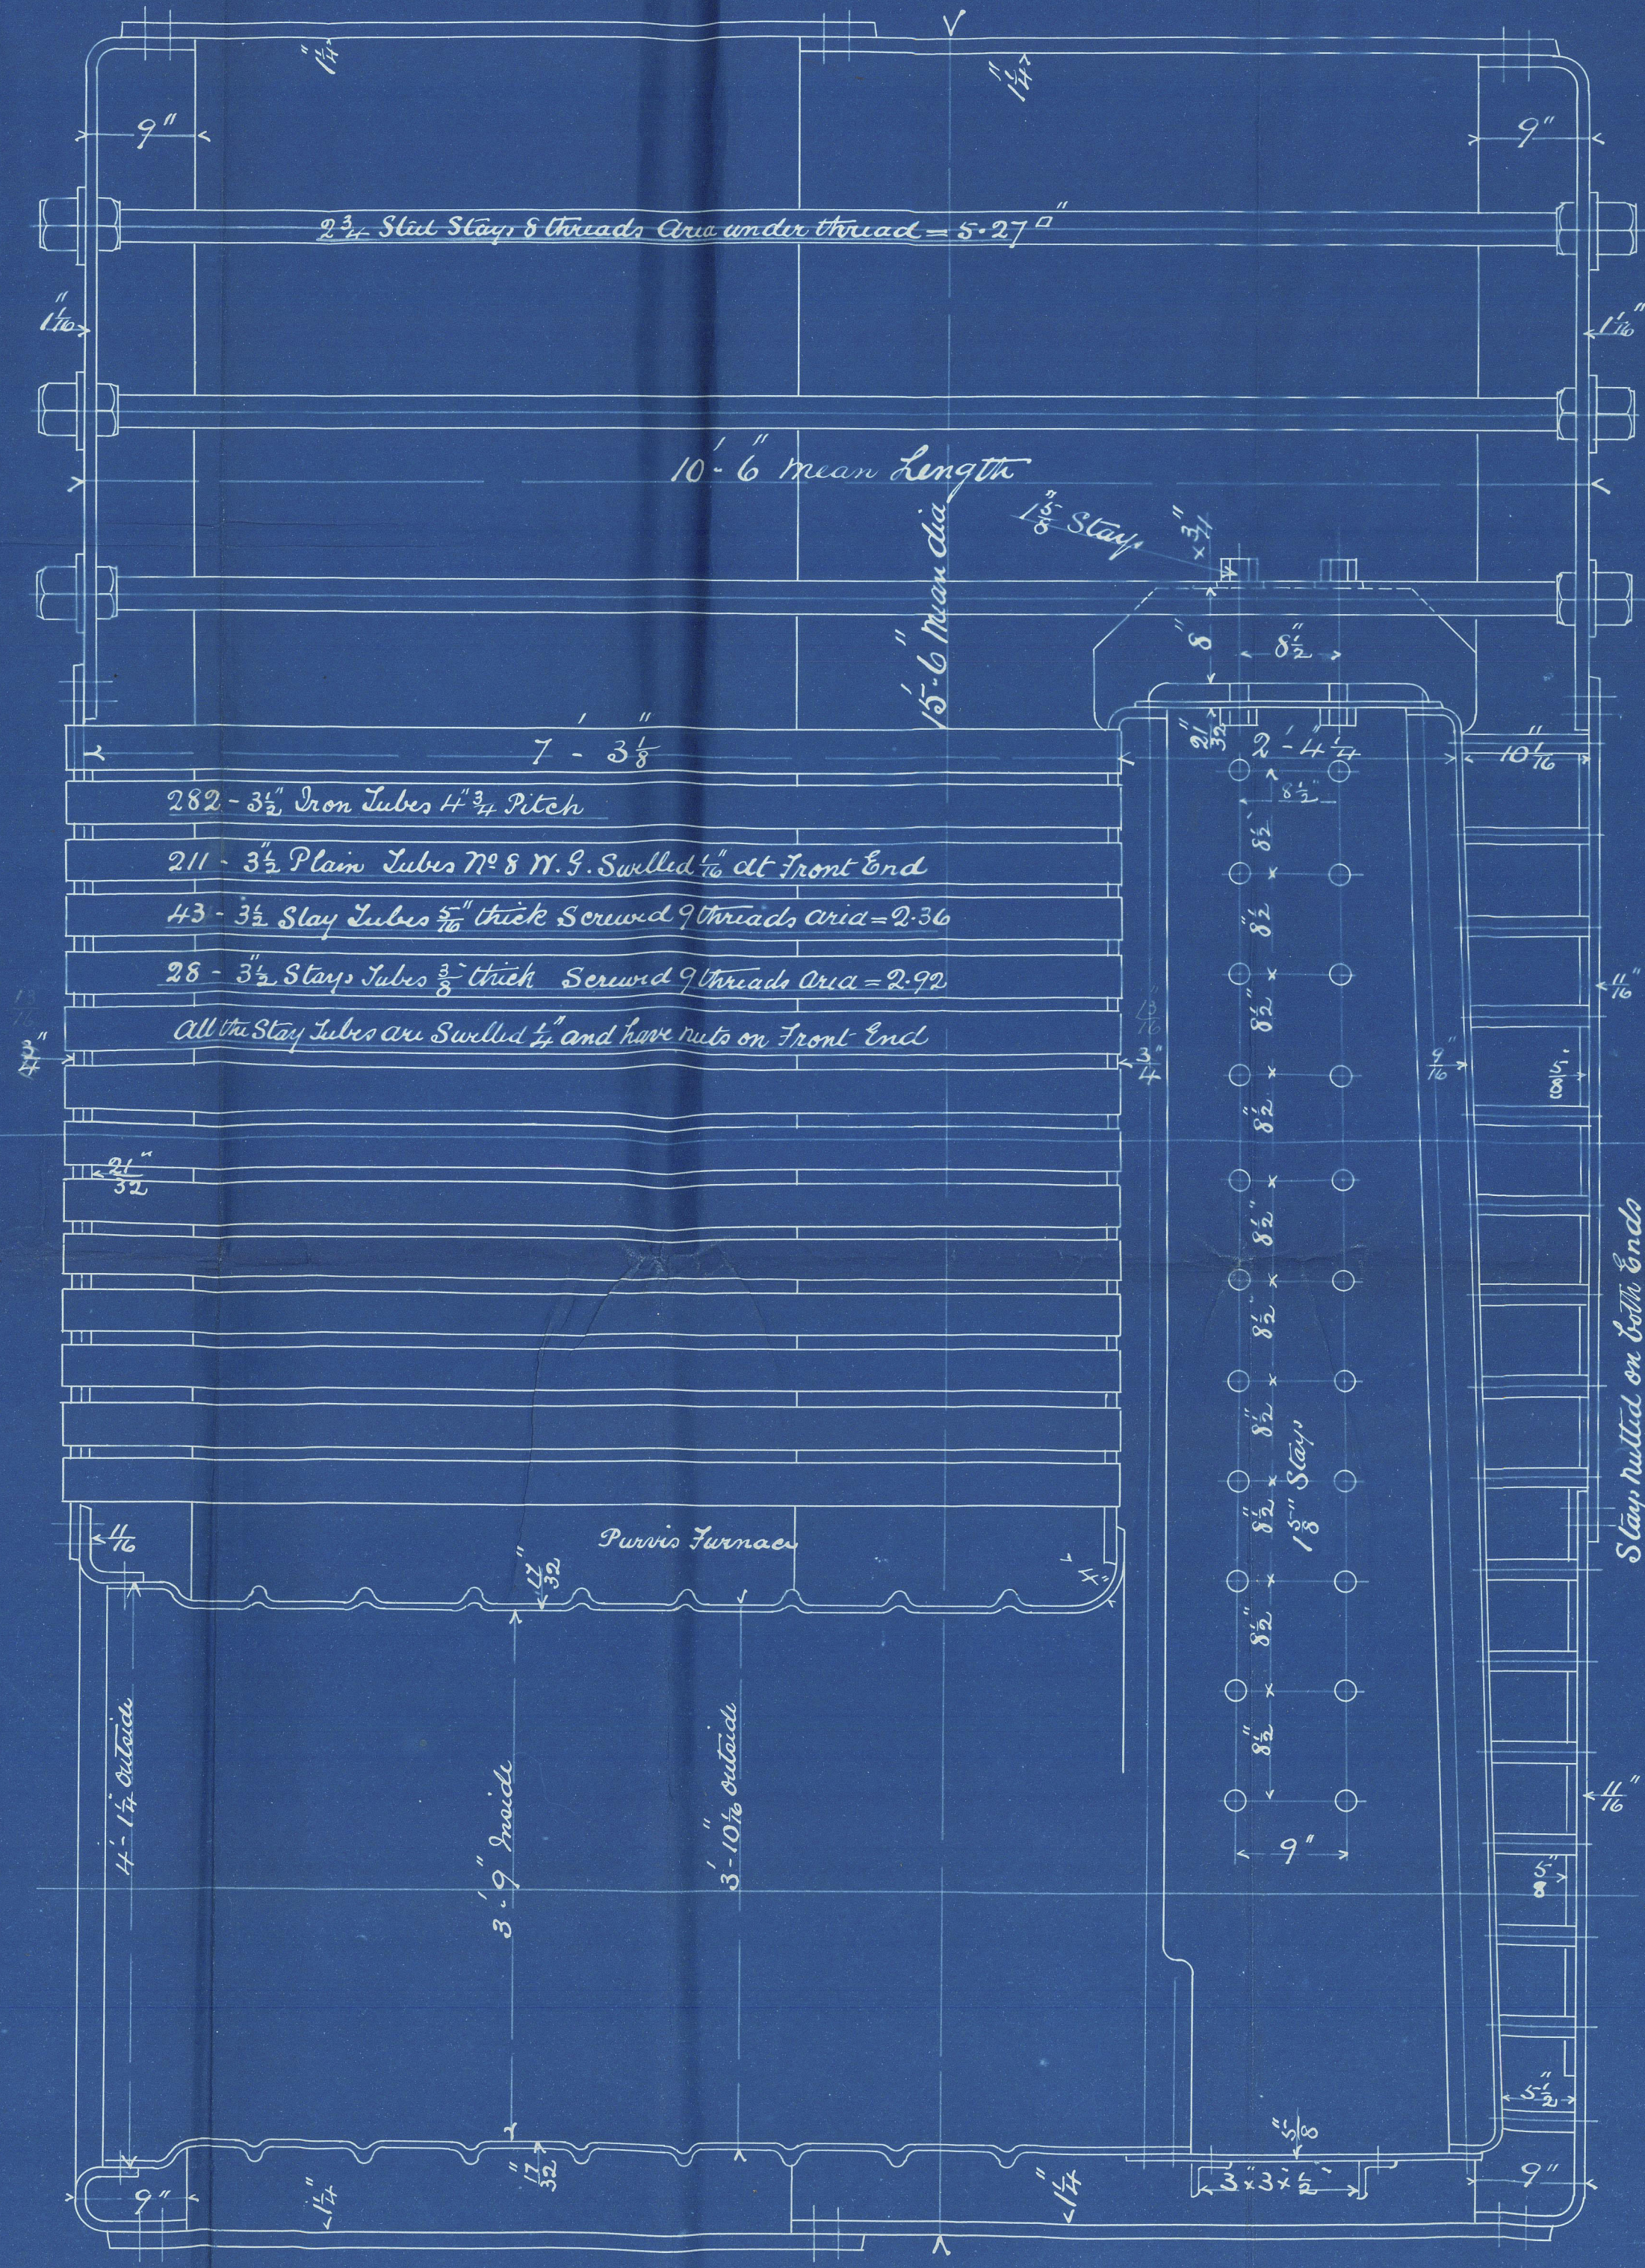

PLATES RIVETS. & STAYS OF STEEL
TUBES OF IRON

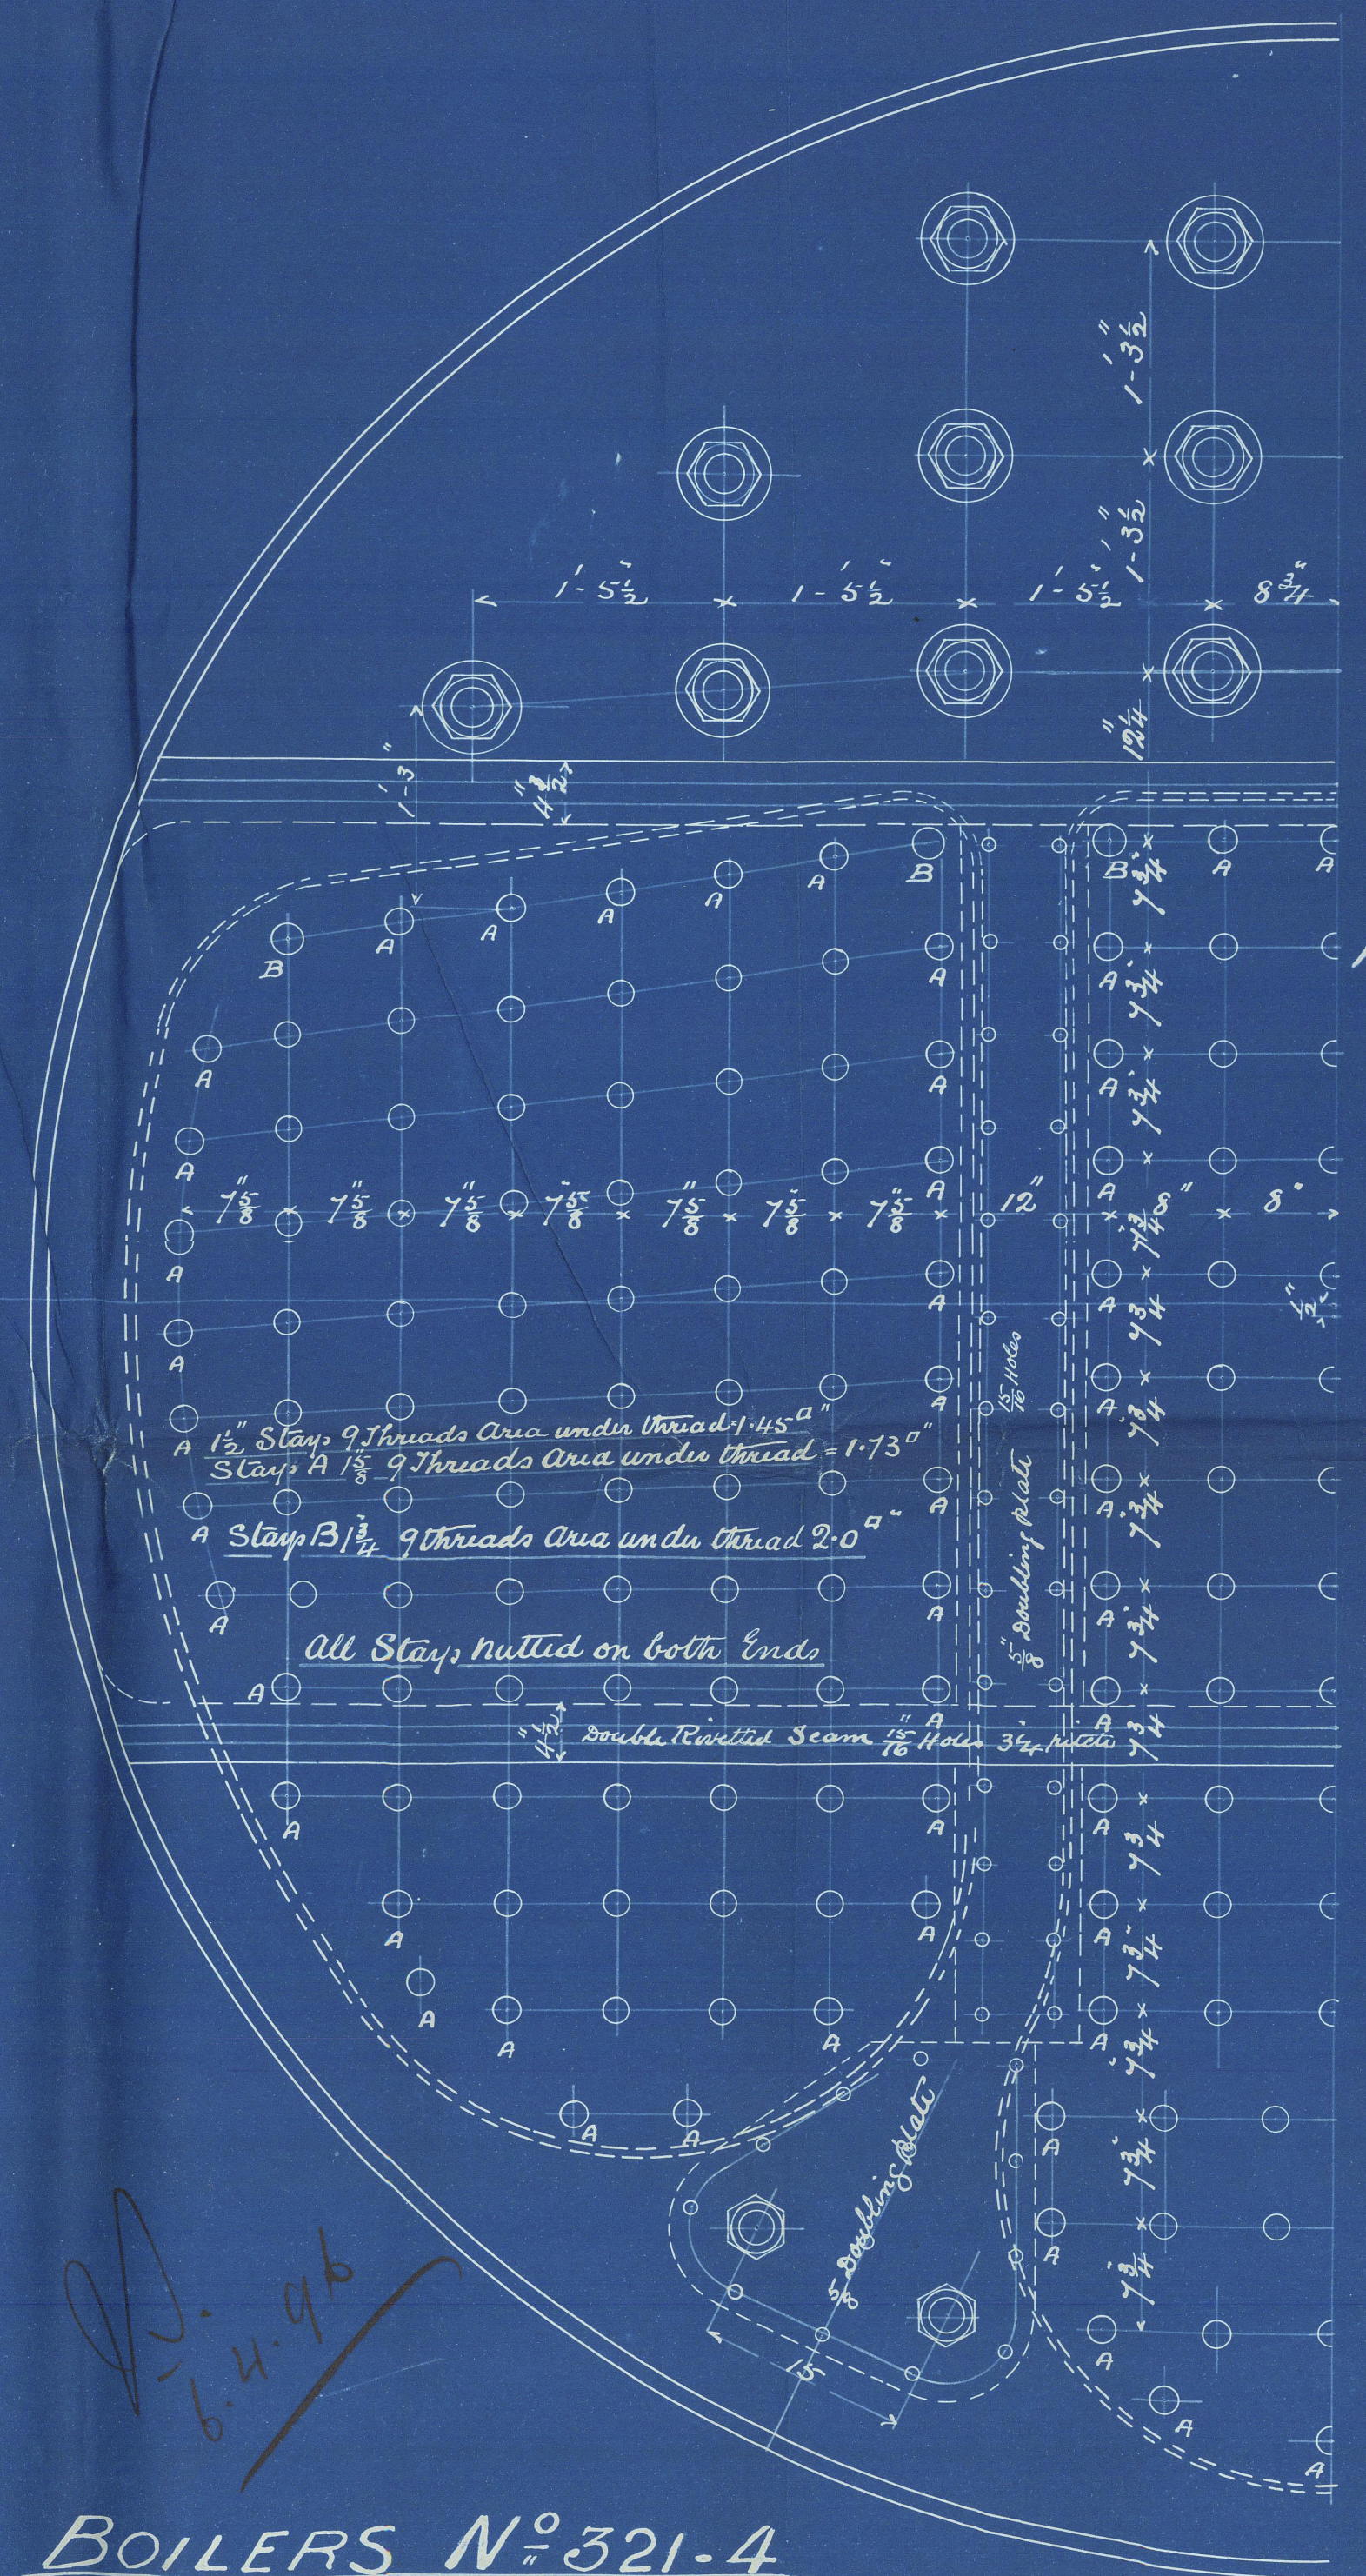

BOILERS N° 321-4

MARINE BOILERS 15'-6" MEAN DIAM. X 10'-6" MEAN LENGTH
TO PASS LLOYDS FOR 160 LBS. WORKING PRESSURE
SCALE 1 INCH = 1 FOOT

The
7/4/96

GRK336-6052



Anderson & Yale
Encaid 251-2

S S. "Ceres"
S S. "Minerva"
Guano Reports nos.
11601 & 11630



© 2021

Lloyd's Register

GRN3360052