

Lloyd's Register of British and Foreign Shipping.

(Report on Vessel No. 11601 Port Kilmarnock)
"Rubens"

No. 5261 SHIP FORGINGS ~~OR CASTINGS~~.

I have to report that the undermentioned Iron ~~or Steel~~ Forgings ~~or Castings~~,
manufactured by The Portland Forge Coy
of Kilmarnock for the Vessel No. 396, being built
by Messrs Russell & Co of Port Glasgow
have been inspected by me as set forth below, and found to be, so far as can be seen,
Sound & efficient


Mark on Forgings.

Lloyd's
No. 5261
WH

William Hamilton
Glasgow


| | STERN FRAME. | RUDDER FRAME. | STEM. |
|------------------------|-------------------------------|---------------|-------|
| Material* ... | <u>Scrap iron</u> | | |
| How made ... | <u>Forged</u> | | |
| Dimensions ... | <u>11 1/2</u> | | |
| Progress on Inspection | <u>Forging & smithing</u> | | |
| Date when Inspected | <u>9/3/96 to 12/6/96</u> | | |

SKETCHES OF FRAMES SHOWING POSITION AND DESCRIPTION OF WELDS OF FORGINGS, OR PARTICULARS OF TESTS APPLIED TO CASTINGS.

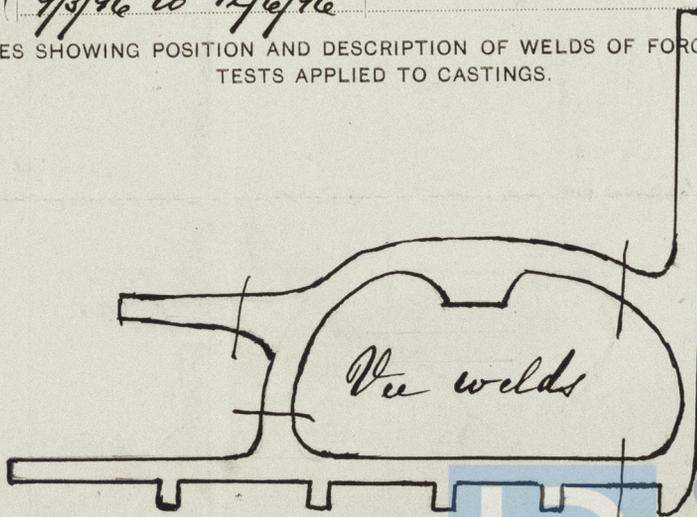

Fee (if any chargeable) £ : : ✓

To be paid at

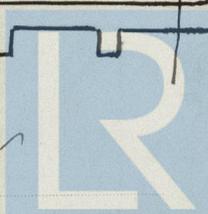

© 2019

Lloyd's Register
Foundation

GRK336-0062