

Lloyd's Register of British and Foreign Shipping.

(Report on Vessel No. 11627 Port Glasgow
as 18th March)

No. 5484 SHIP FORGINGS OR ~~CASTINGS~~.

The words FORGINGS or CASTINGS, IRON or STEEL, should be struck out as may be required.

I have to report that the undermentioned Iron or Steel Forgings or Castings, manufactured by The Harbour Forge Coy of Tron for the Vessel No. 403, being built by Mess Russell & Coy of Port Glasgow have been inspected by me as set forth below, and found to be, so far as can be seen, Sound & efficient


Mark on Forgings.

Lloyd's
No. 5484
W.H

William Hamilton
Glasgow 4/11/96

	STERN FRAME.	RUDDER FRAME.	STEM.
Material*		<u>Scrap iron</u>	
How made		<u>Forged</u>	
Dimensions		<u>5 to 4 1/2 + 5 1/2 pints 2 3/4</u>	
Progress on Inspection		<u>Forging & smithing</u>	
Date when Inspected		<u>13/10/96 to 4/11/96</u>	

SKETCHES OF FRAMES SHOWING POSITION AND DESCRIPTION OF WELDS OF FORGINGS, OR PARTICULARS OF TESTS APPLIED TO CASTINGS.

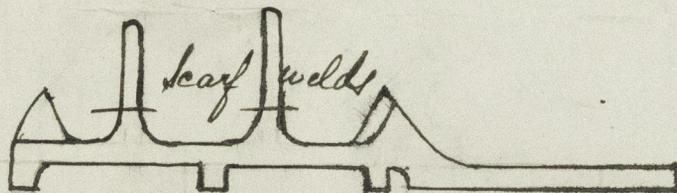

Fee (if any chargeable) £ : :

To be paid at



© 2019

Lloyd's Register
Foundation

* If of Iron, state whether scrap or puddled Iron.