


- Steel Barque N^o 129 - & No. 131 appo. 4/1/96

DIMENSIONS 258-0 x 39-11 x 25-1 $\frac{1}{2}$ ML⁰-T₀M.D.

— CLASS 100 A1. AT LLOYDS. —

- William Hamilton & Coy. -
- Shipbuilders -
- Port Glasgow -

FORECASTLE BEAMS $7 \times \frac{7}{16}$ BULB $3 \times 3 \times \frac{5}{16}$ DOUBLE ANGLES,
POOP BEAMS $6 \frac{1}{2} \times 3 \times \frac{5}{16}$ SINGLE ANGLE
POOP STRINGER $24 \times \frac{5}{16}$
FORECASTLE STRINGER $24 \times \frac{5}{16}$
POOP AND FORECASTLE TIES $11 \times \frac{5}{16}$

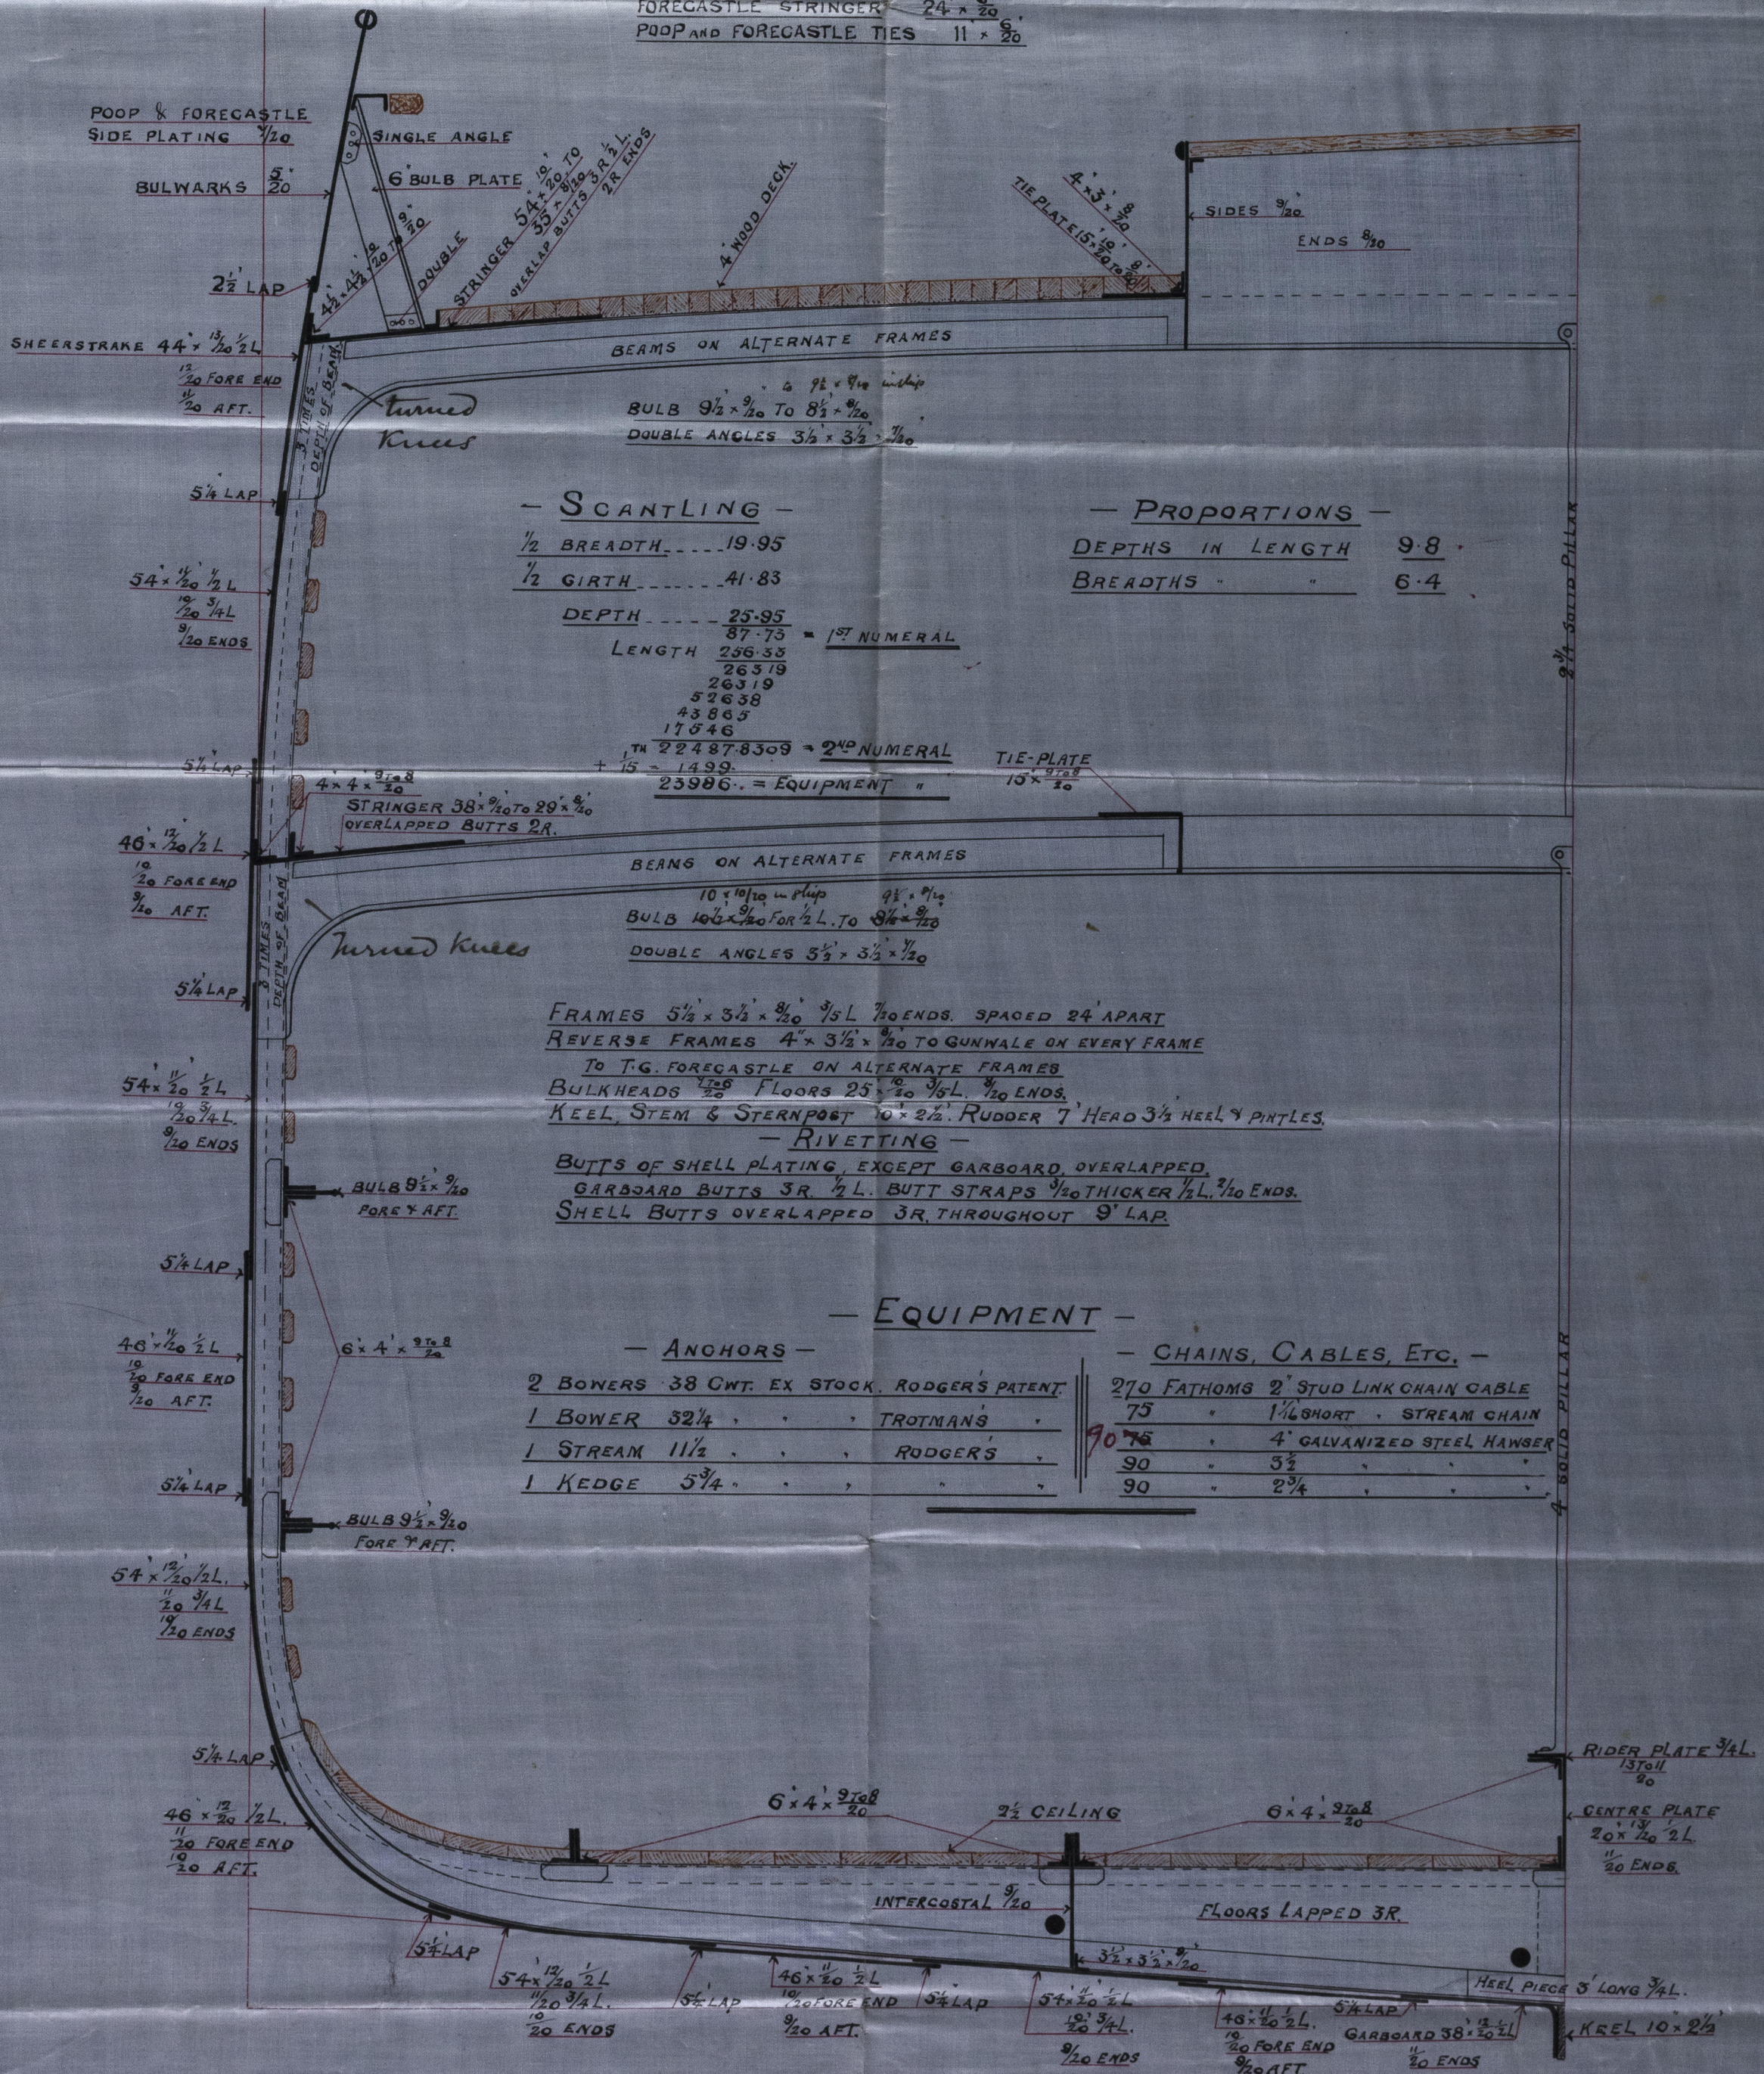

— SCALE $\frac{1}{2}$ INCH = ONE FOOT —

Midship Section

W. Hamilton No. 129



"Wynford."

Insurance Report

no. 11678.



Storegrund
1897.

AR 337-0058

Lloyd's Register
Foundation

POOP STRINGER
POOP BEAMS
FORECASTLE BEAMS

DIMENSIONS

CIVILS