

Steel Barque N<sup>o</sup> ~~127~~ - 131

— CLASS 100 A1 AT LLOYDS. —

— William Hamilton & Coy. —  
— Shipbuilders —  
— Port - Glasgow. —

FORECASTLE BEAMS  $7 \times 20$  BULB  $3 \times 3 \times \frac{5}{16}$  DOUBLE ANGLES  
POOP BEAMS  $6 \times 3 \times \frac{5}{16}$  SINGLE ANGLE  
POOP STRINGER  $24 \times \frac{5}{8}$   
FORECASTLE STRINGER  $24 \times \frac{5}{8}$   
POOP AND FORECASTLE KES  $11 \times \frac{5}{8}$

— SCALE  $\frac{1}{2}$  INCH = ONE FOOT —



W H amilton & Co

Midship Section


no 131.

Listed no 129.

---

"Hagley"  
Success Report  
no.

---

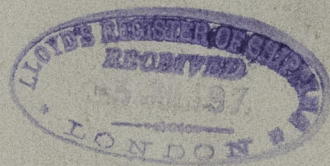

624537-0061



© 2019

Lloyd's Register  
Foundation