

Lloyd's Register of British and Foreign Shipping.

(Report on Vessel No. *11678* Port *Greenock*)

Wynford

No. *5516* SHIP FORGINGS OR CASTINGS.

The words FORGINGS OR CASTINGS, IRON OR STEEL, should be struck out as may be required.

I have to report that the undermentioned Iron or Steel Forgings or Castings, manufactured by *The Portland Forge Coy*

of *Kilmarnock* for the Vessel No. *129* being built

by *Messrs William Hamilton & Coy of Port Glasgow*

have been inspected by me as set forth below, and found to be, so far as can be seen,

Sound & efficient

Keel bars rolled by Messrs David Colville & Coy

Mark on Forgings.


Lloyd's
No. *5516*
W. H.

William Hamilton

Glasgow 31/10/96

	STERN FRAME.	RUDDER FRAME	STEM.
Material*	<i>Scrap iron</i>	<i>Keel bars Seynens marten Ingot steel</i>	<i>Scrap iron</i>
How made	<i>Forged</i>	<i>Rolled</i>	<i>Forged</i>
Dimensions	<i>10 x 2 1/2</i>	<i>10 x 2 1/2</i>	<i>10 x 2 1/2</i>
Progress on Inspection	<i>Forging & smithing</i>	<i>Straightening & Machining</i>	<i>Forging</i>
Date when Inspected	<i>7 to 28/10/96</i>	<i>12 to 26/10/96</i>	<i>19 to 28/10/96</i>


SKETCHES OF FRAMES SHOWING POSITION AND DESCRIPTION OF WELDS OF FORGINGS, OR PARTICULARS OF TESTS APPLIED TO CASTINGS.

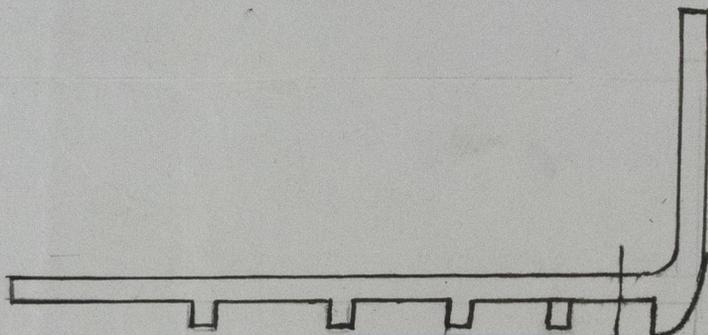

Glue weld

Fee (if any chargeable) £ : :

To be paid at

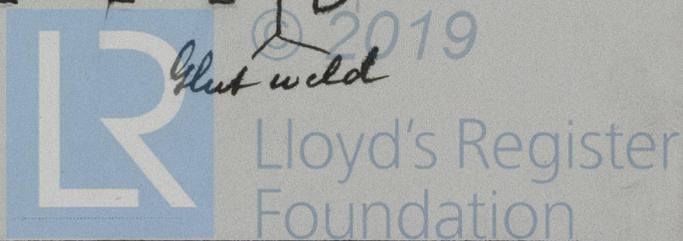

* If of Iron, state whether scrap or puddled Iron.