

Pl. 10. 97.

PIPING PLAN OF S.S. No. 328.



Under Deck and Sub-Tank

BILGE PIPES IN BLUE



TANK PIPES IN RED.

SCALE -  $\frac{1}{4}'' = 1 \text{ FOOT}$

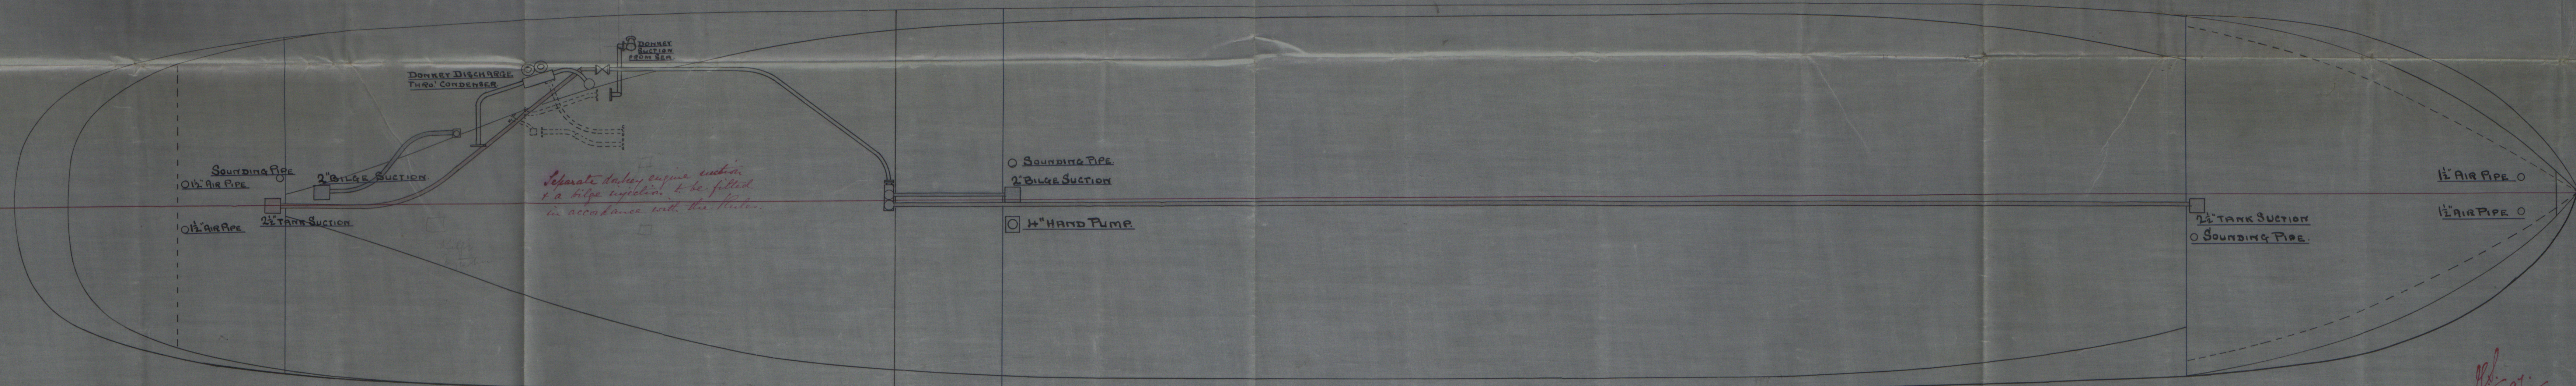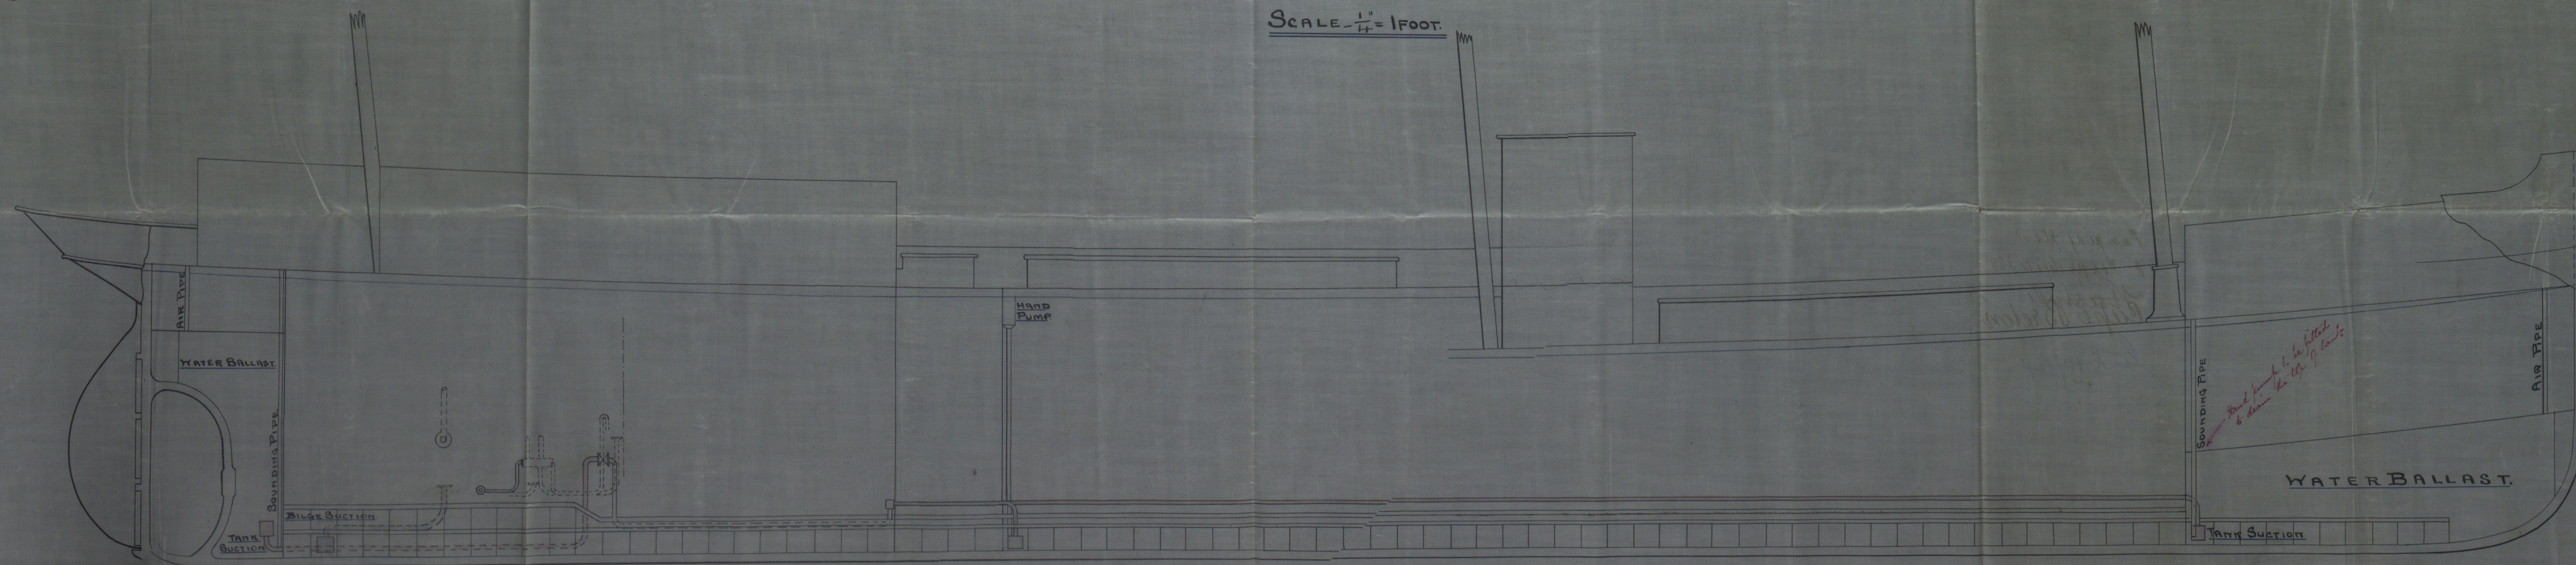

W. H. 8/4/97

Pl. 10. 97.



Lloyd's Register Foundation



