
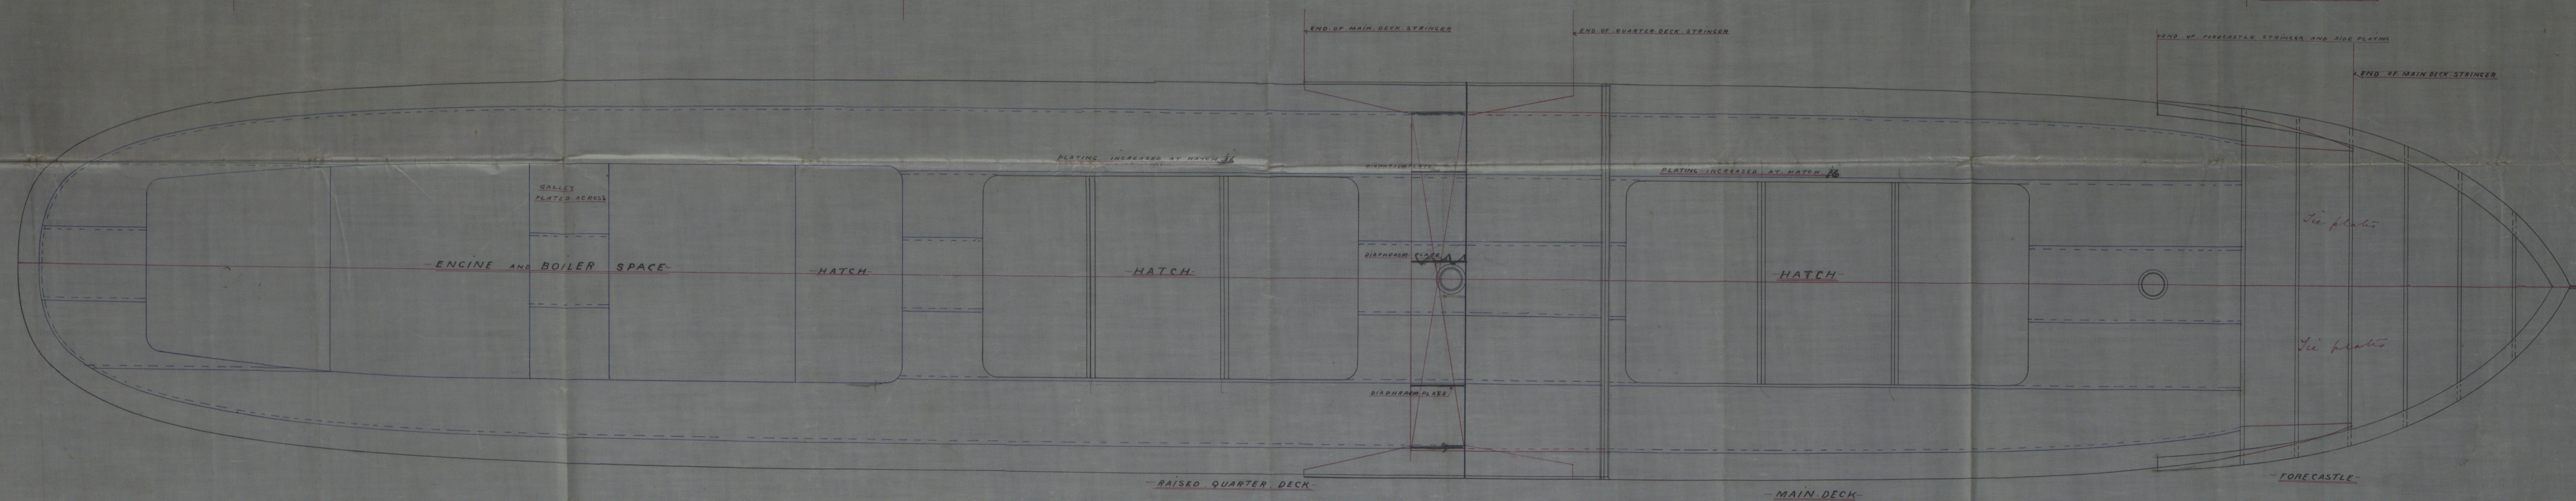


76. 11. 96

—PROFILE AND DECK PLANS—

—S. S. N° 328—

SCALE 1/2 INCH = 1 FOOT

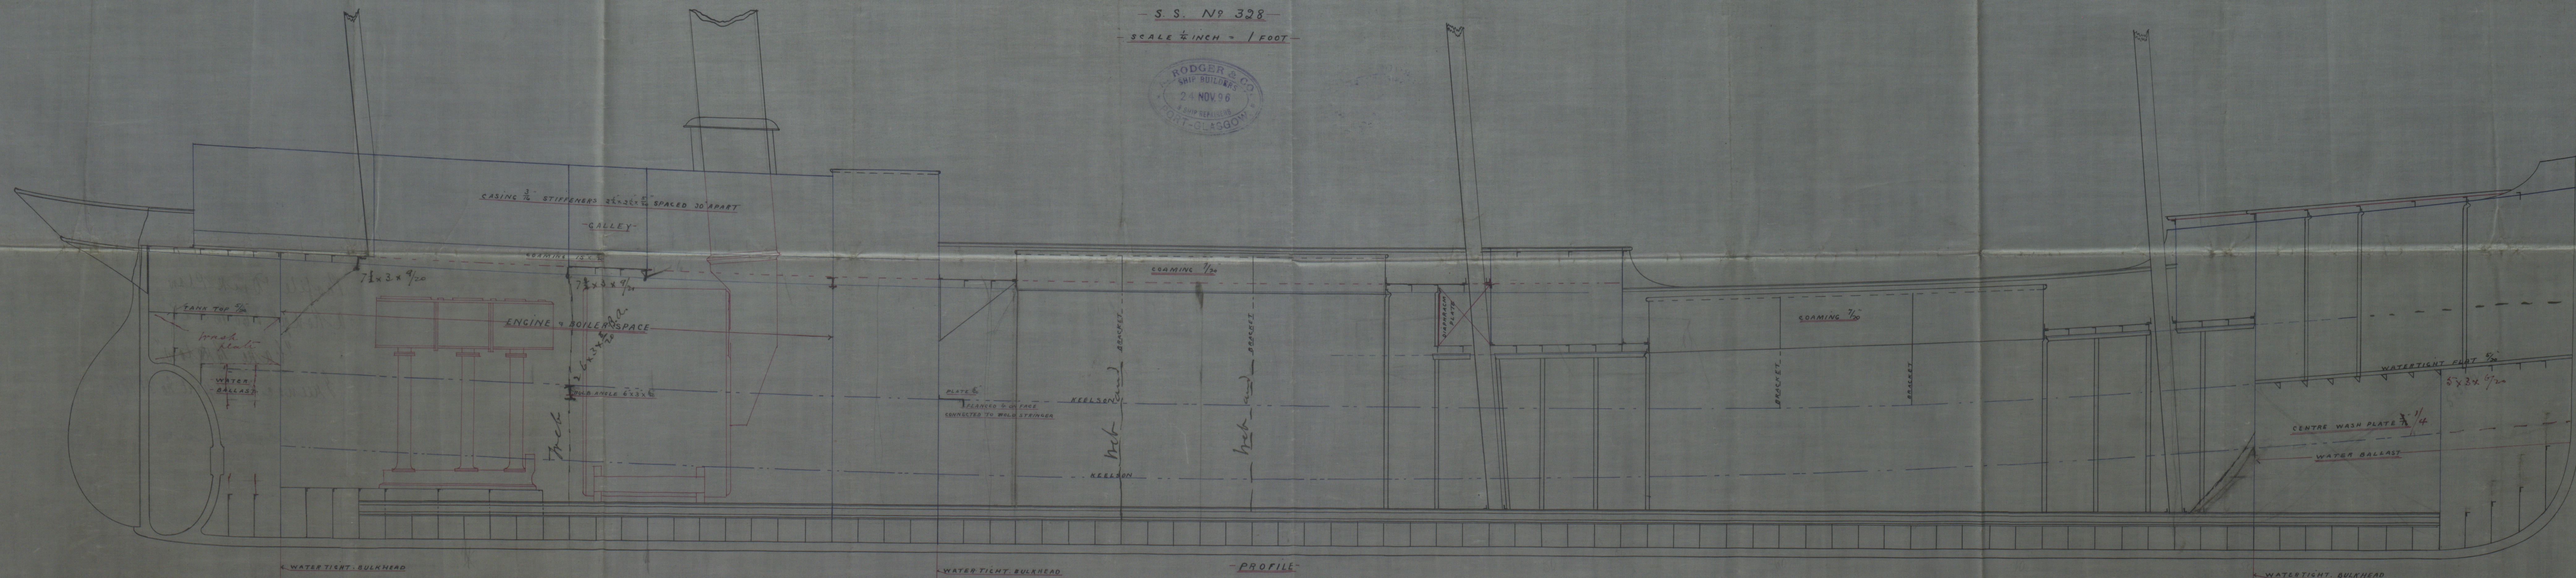

24/11/96

as p x E x 17

Profile Deck Plan

A. Rodge 66. No. 328

"Cape Breton"

Greenock Report No. 11984

GRK 338-0075

WATER BALLAST

WATER TIGHT BULKHEAD

WATER TIGHT BULKHEAD

END OF FORECASTLE STRINGER AND SIDE PLATING

END OF MAIN DECK STRINGER



© 2019

Lloyd's Register
Foundation