

Received at Glenock Office, 26-1- 1897

Lloyd's Register of British and Foreign Shipping.

(Report on Vessel No. 11484 Port Lunenburg
Liban Station)

No. 5614 SHIP FORGINGS OR CASTINGS.

I have to report that the undermentioned Iron or ~~Steel~~ Forgings or Castings, manufactured by Messrs Robt Kerr & Sons of Irvine for the Vessel No. 328, being built by Messrs A Rodger & Coy of Port Glasgow have been inspected by me as set forth below, and found to be, so far as can be seen, Sound & efficient

The words FORGINGS or CASTINGS, IRON or STEEL, should be struck out as may be required.

Mark on Forgings.


Lloyd's
No. 5614
W.H.

William Hamilton

Glasgow
22/1/97
STEM & bul bars

	STERN FRAME.	RUDDER FRAME.	STEM & bul bars
Material*	<u>Scrap iron</u>		<u>Scrap iron</u>
How made	<u>Forged</u>		<u>Forged</u>
Dimensions	<u>6 1/2 x 3 1/2</u>		<u>7 + 1 3/4 to 6 1/2 x 1 3/4</u>
Progress on Inspection	<u>Forging & smithing</u>		<u>Forging</u>
Date when Inspected	<u>4/12/96 to 21/1/97</u>		<u>26/11/96 to 23/12/96</u>

SKETCHES OF FRAMES SHOWING POSITION AND DESCRIPTION OF WELDS OF FORGINGS, OR PARTICULARS OF TESTS APPLIED TO CASTINGS.

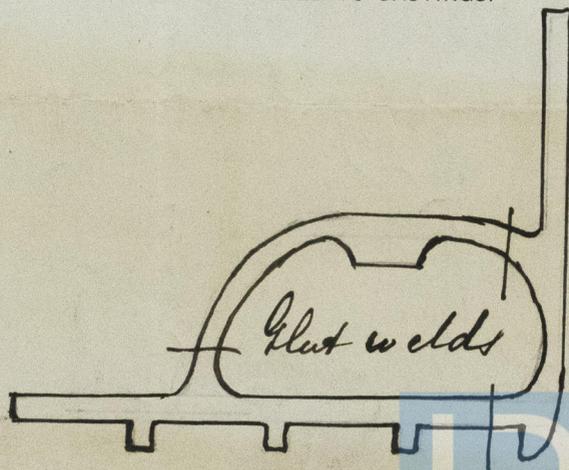

Fee (if any chargeable) £ : :

To be paid at

© 2019

Lloyd's Register
Foundation