

Received at *Greenock* Office. *2nd Apl. 1897.*

Lloyd's Register of British and Foreign Shipping.

(Report on Vessel No. *11484* Port *Greenock*)

is "ape Bueton."

No. *5614* SHIP FORGINGS OR CASTINGS.

The words FORGINGS or CASTINGS, IRON or STEEL, should be struck out as may be required.

I have to report that the undermentioned ~~Iron or Steel Forgings or Castings~~,
 manufactured by *Messrs Robt Kerr & Sons*
 of *Irvine* for the Vessel No. *328*, being built
 by *Messrs A Rodger & Co* of *Port Glasgow*
 have been inspected by me as set forth below, and found to be, so far as can be seen,
Sound & efficient


Mark on Forgings.

Lloyd's
 No. *5614*
 W. H.

William Hamilton
Glasgow
1/4/97

	STERN FRAME.	RUDDER FRAME.	STEM.
Material*		<i>Scrap iron</i>	
How made		<i>Forged</i>	
Dimensions		<i>4 7/8 to 3 3/8 pentle 2 3/4 dia</i>	
Progress on Inspection		<i>Forging & smithing</i>	
Date when Inspected		<i>1/2/97 to 29/3/97</i>	

SKETCHES OF FRAMES SHOWING POSITION AND DESCRIPTION OF WELDS OF FORGINGS, OR PARTICULARS OF TESTS APPLIED TO CASTINGS.

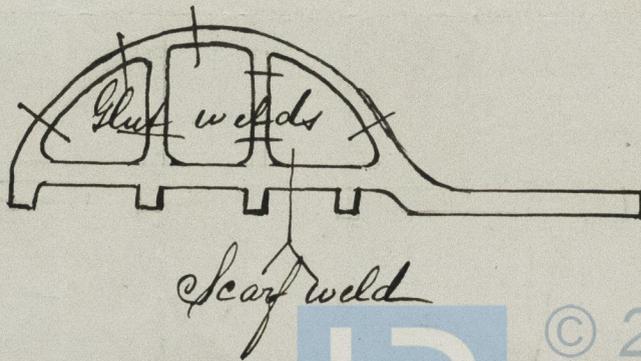

Fee (if any chargeable) £ : :

To be paid at

