

Received at Greenock Office, 28. 11. 1896.

Lloyd's Register of British and Foreign Shipping.

(Report on Vessel No. 11485 Port Greenock)

"Hayter"

No. 5534 SHIP FORGINGS OR CASTINGS.

The words FORGINGS or CASTINGS, IRON or STEEL, should be struck out as may be required.

I have to report that the undermentioned Iron ^{or} Steel Forgings ~~or~~ Castings, manufactured by The Portland Forge Coy of Kilmarnock for the Vessel No. 131, being built by Messrs Wm Hamilton & Coy Port Glasgow have been inspected by me as set forth below, and found to be, so far as can be seen,

Sound & efficient

Kel Bars manufactured by Messrs D Colville & Coy and machined by the Portland Forge Coy

Mark on Forgings.

Lloyd's
No. 5534
WH


William Hamilton

Glasgow

26/11/96

	STERN FRAME.	RUDDER FRAME.	STEM.
Material*	<u>Scrap iron</u>	<u>Superior marten</u>	<u>Scrap iron</u>
How made	<u>Forged</u>	<u>Rollled</u>	<u>Forged</u>
Dimensions	<u>10 x 2 1/2</u>	<u>10 x 2 1/2</u>	<u>10 x 2 1/2</u>
Progress on Inspection	<u>Forging & smithing</u>	<u>Machining</u>	<u>Forging</u>
Date when Inspected	<u>6 to 24/11/96</u>	<u>4 to 24/11/96</u>	<u>18 24/11/96</u>


SKETCHES OF FRAMES SHOWING POSITION AND DESCRIPTION OF WELDS OF FORGINGS, OR PARTICULARS OF TESTS APPLIED TO CASTINGS.

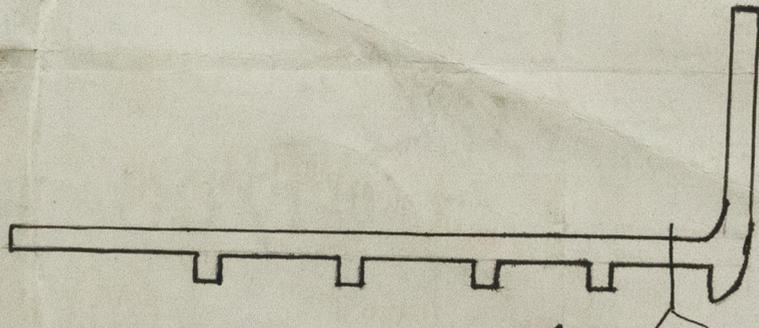

But welds

Fee (if any chargeable) £ : :

To be paid at

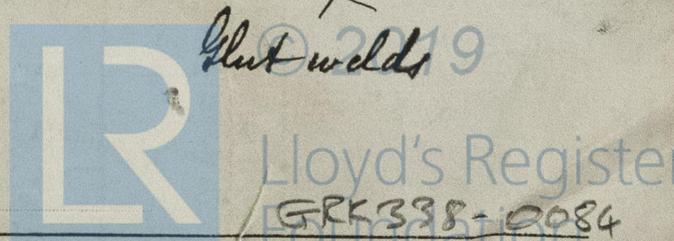

GRK338-0084