

S.S. No. 285 & 286 -  
Upper Deck Strong Beams  
Proposed Under Section in Line of Plate & Angles

Steel Deck 16-20 thick outside Boiler Covering  
+ 1720 thick inside Boiler Covering.

Under Section in Line of Plate & Angles

Plate 12x14/20


Angles 5/2x4x1/20

12x6x6x 1/2" Web

Angles 14/16 thick

Not further

See Photo print  
dated 17/6/96

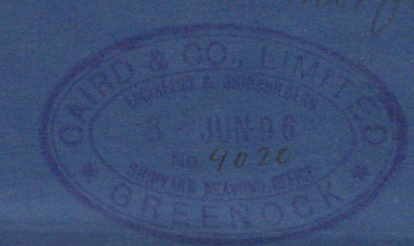

Greenock  
J.P.  
6/6/96

to and this nos. 185 186  
1 per each strong beams



285 Egypt  
Greenock Report  
No. 11829

286  
S.S. "Arabia"  
Greenock Report  
No. 11966

GRK 338-0269



© 2019

Lloyd's Register  
Foundation