



3.9.97

MIDSHIP SECTION

S.S. N^o 332 + 3435

Scale 1 inch = 1 foot














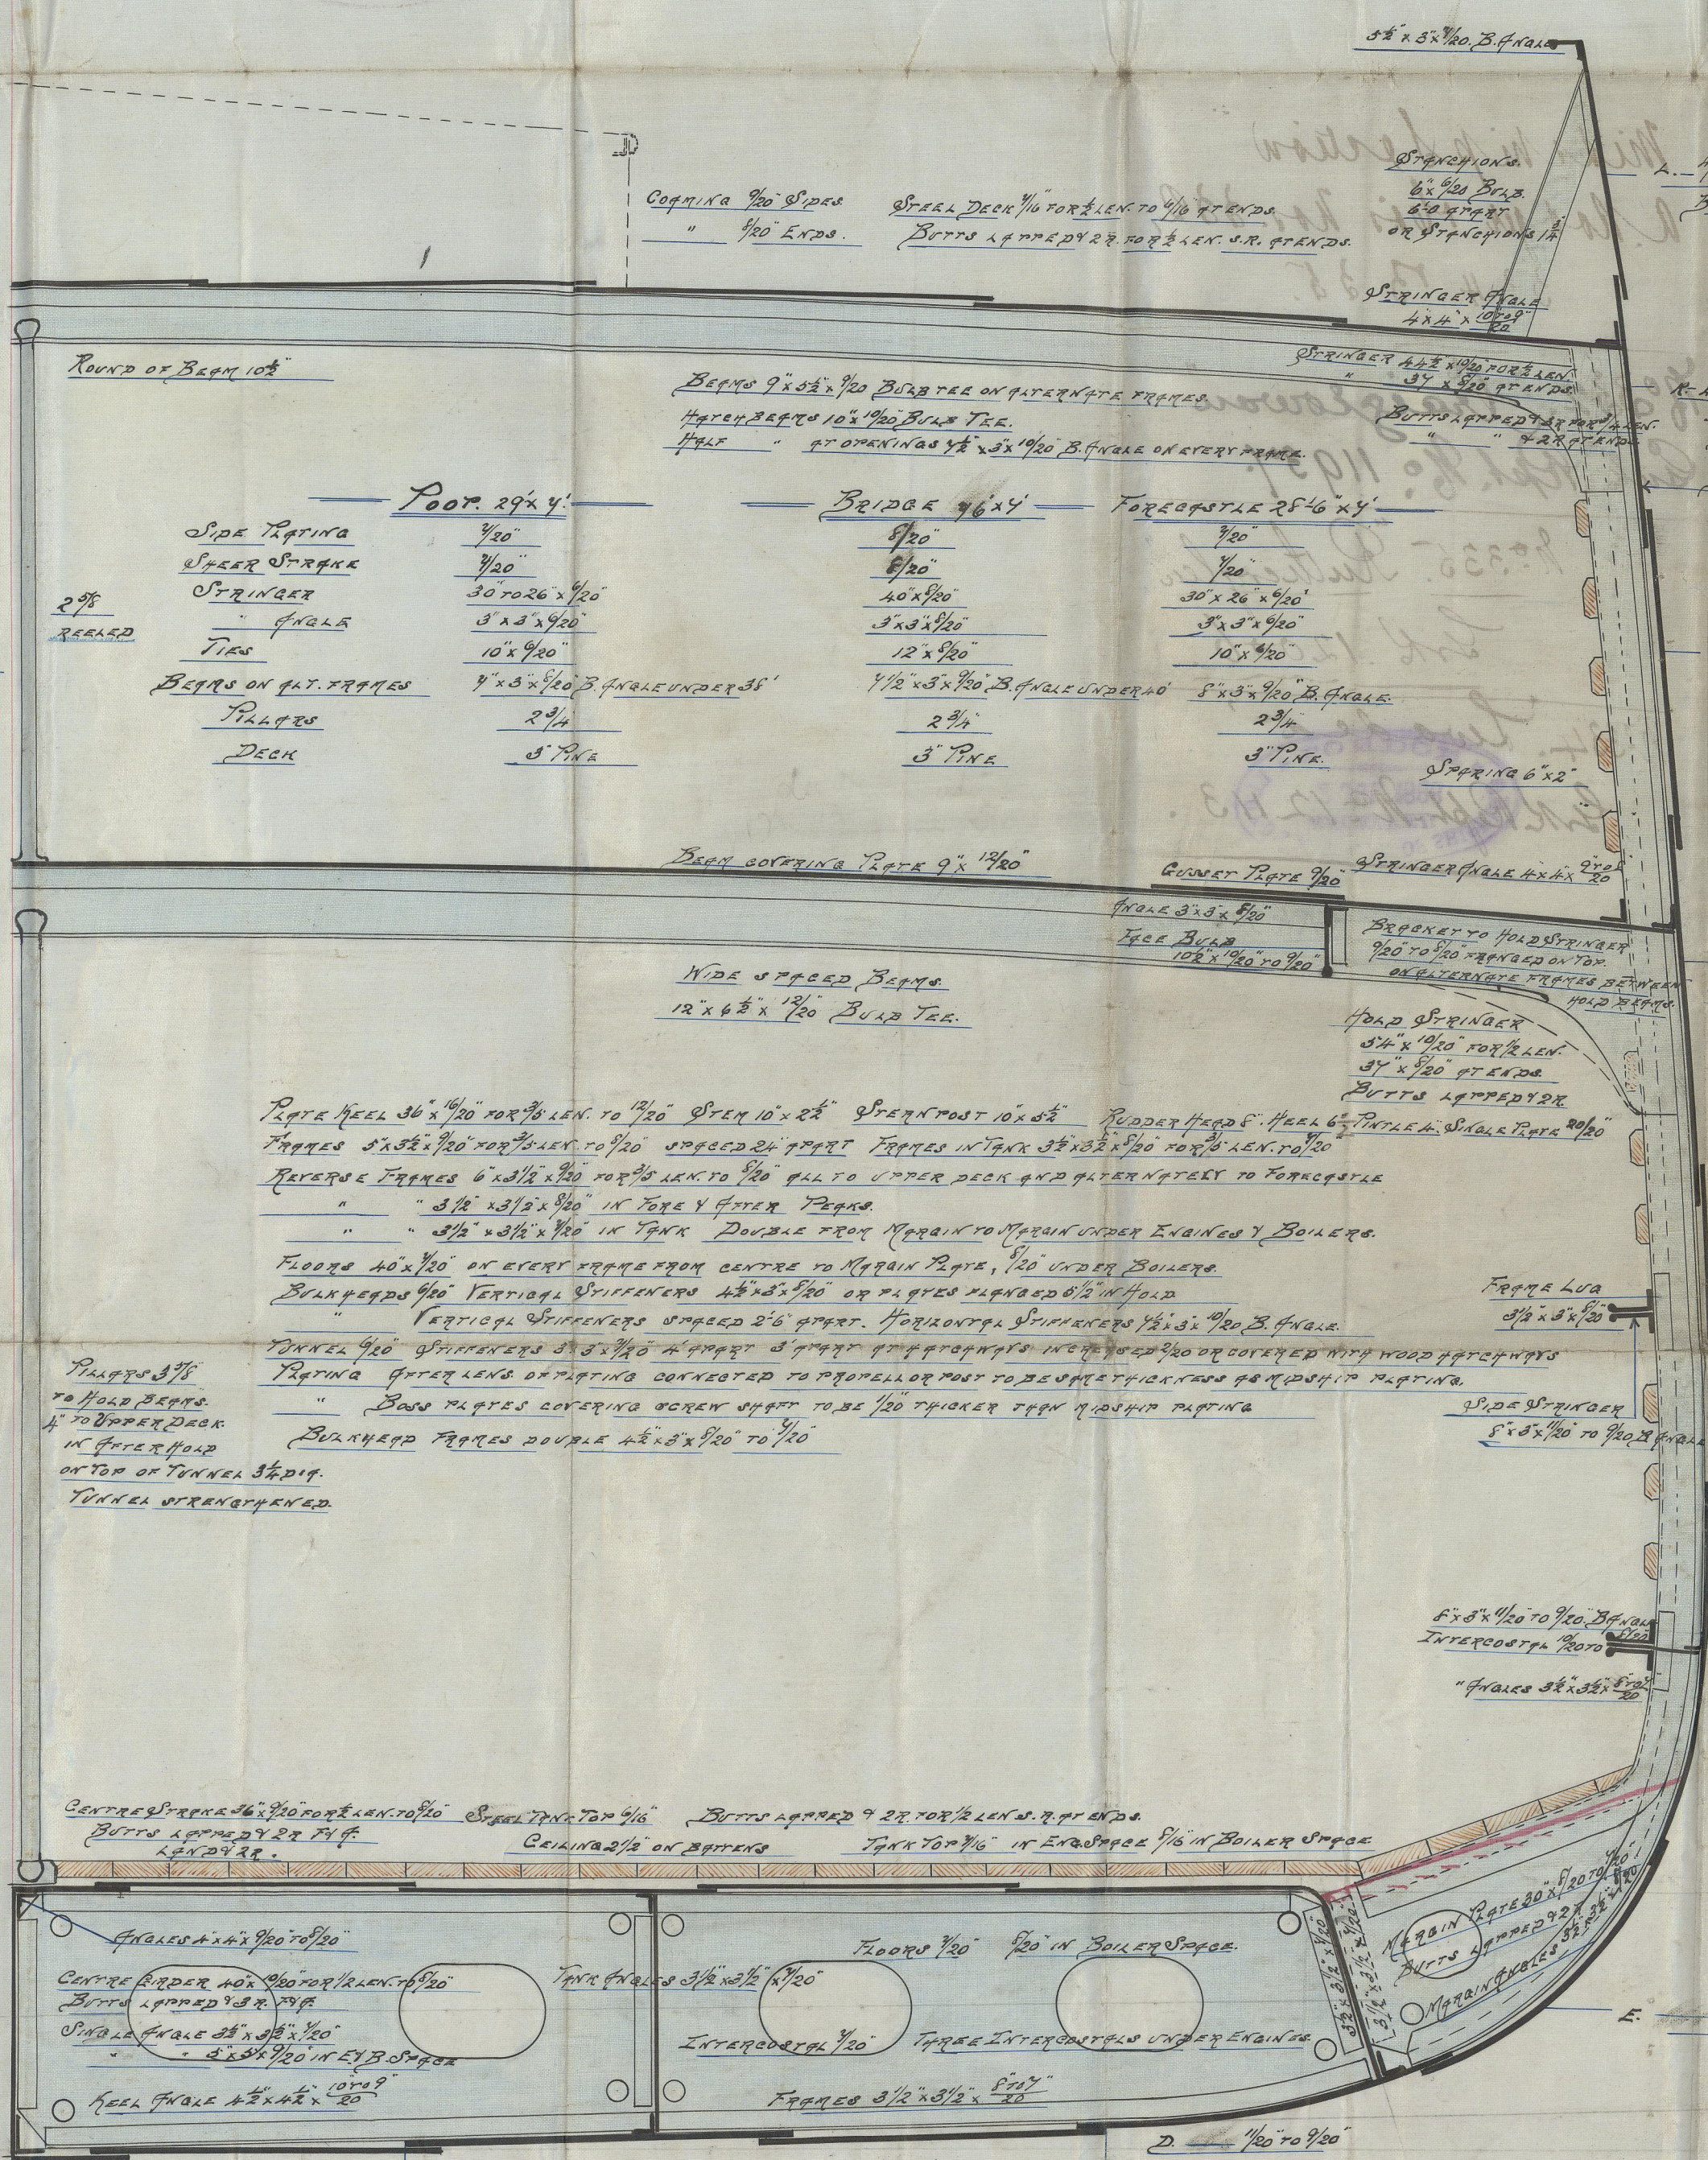









Midship Section
A. Rodger 1811 Nos. 332,
334 1335.

No 332. "Craiglowan"
Guth. Rept. No. 11937.

No 335. "Rutherglen"
Grk. 12006.

No 334. "Lwadea"
Grk. Rept. No. 12113.

GRK 340-0096



© 2021

Lloyd's Register
Foundation