




Plating No. 22745

3.9.97.

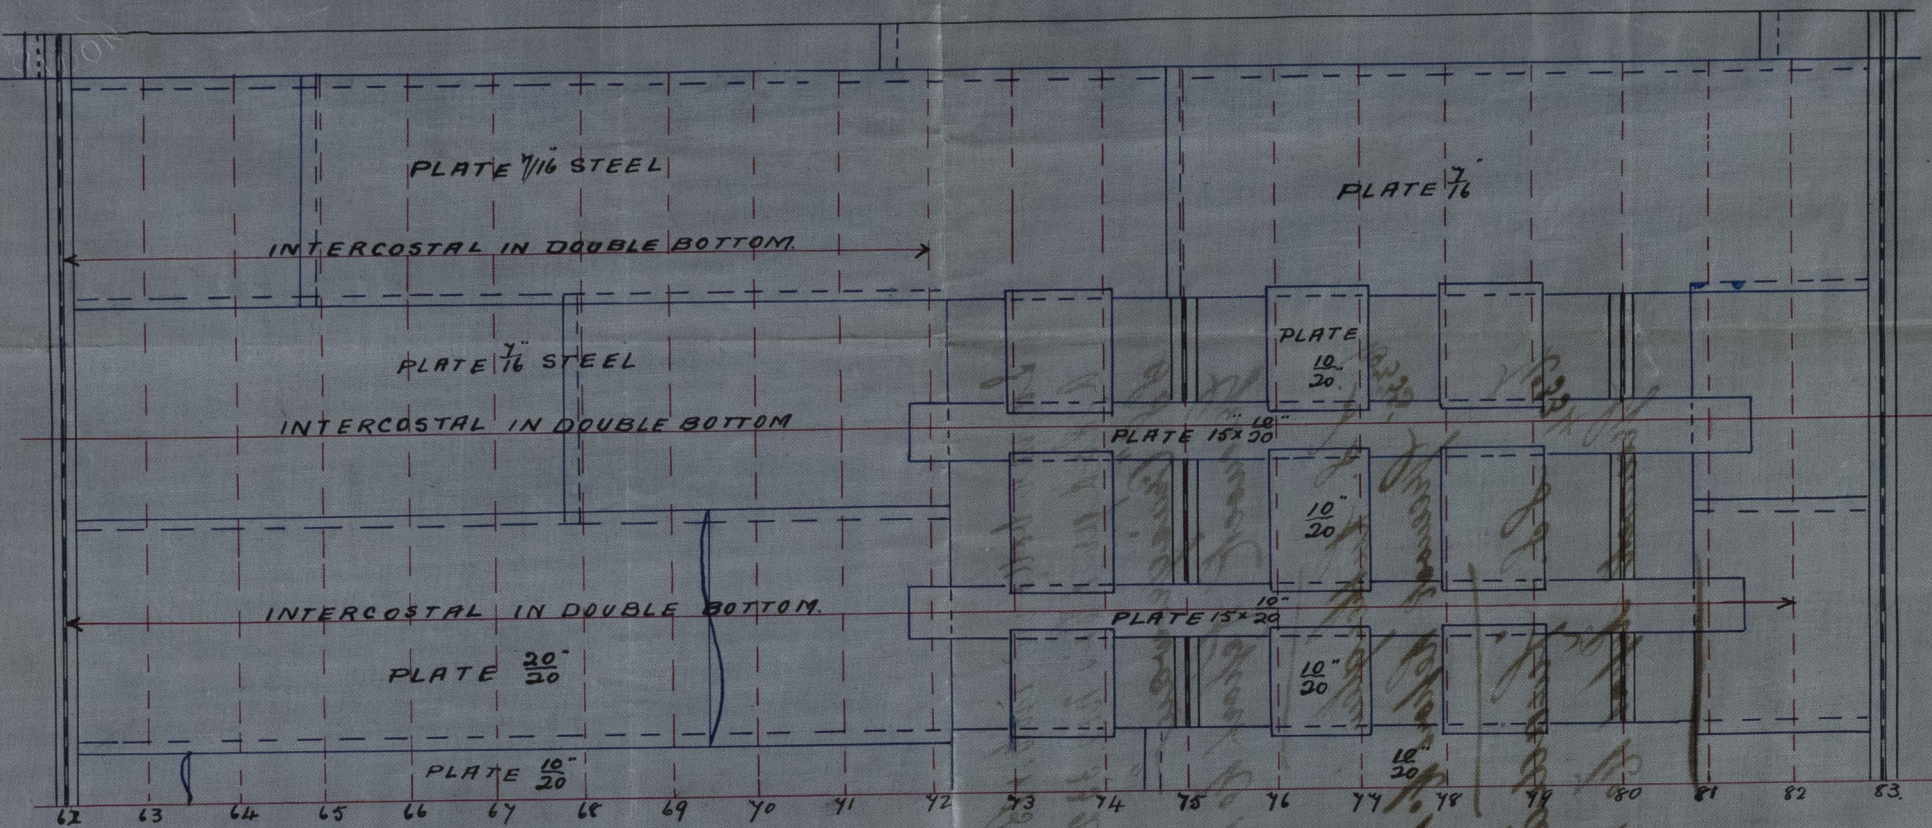


PLAN SHEWING INNER BOTTOM.

IN ENGINE AND BOILER SPACE


S.S. Nos 332 AND 334 & 35

SCALE 1/4 INCH = ONE FOOT.

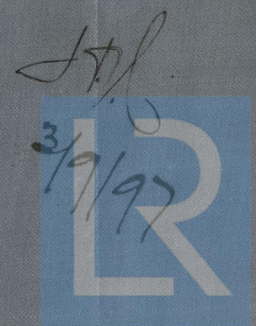

© 2019  
Lloyd's Register  
Foundation  
GRR340-0099  
Handwritten: J.H. 3/9/97, Freeman, 1/9/97



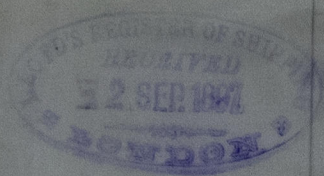

In the bottom in C. & B. Space  
A. Rodger 161's Nos. 332, 334, 335  
S.S. "Craigrowan"  
Greenock Report No 11937.

S.S. "Kuthenglen"  
No 335 Greenock Report No 12006.

No 334 S.S. "Luadiala"  
Greenock Report No 12113.

GRK340-0099



© 2010

Lloyd's Register  
Foundation