

Copy of M.S. to Bull


Dims. 34.5'-0" x 49'-9" l x 49'-7" mld x 28'-5" mld. to Spar Deck.

To Class 100 A.1. at Lloyd's Spar Deck Rule.

Scale $\frac{1}{2}" = \text{one foot}$.

Sl. Le 'SVARTEN'

19/10/97
Received 2/3/98

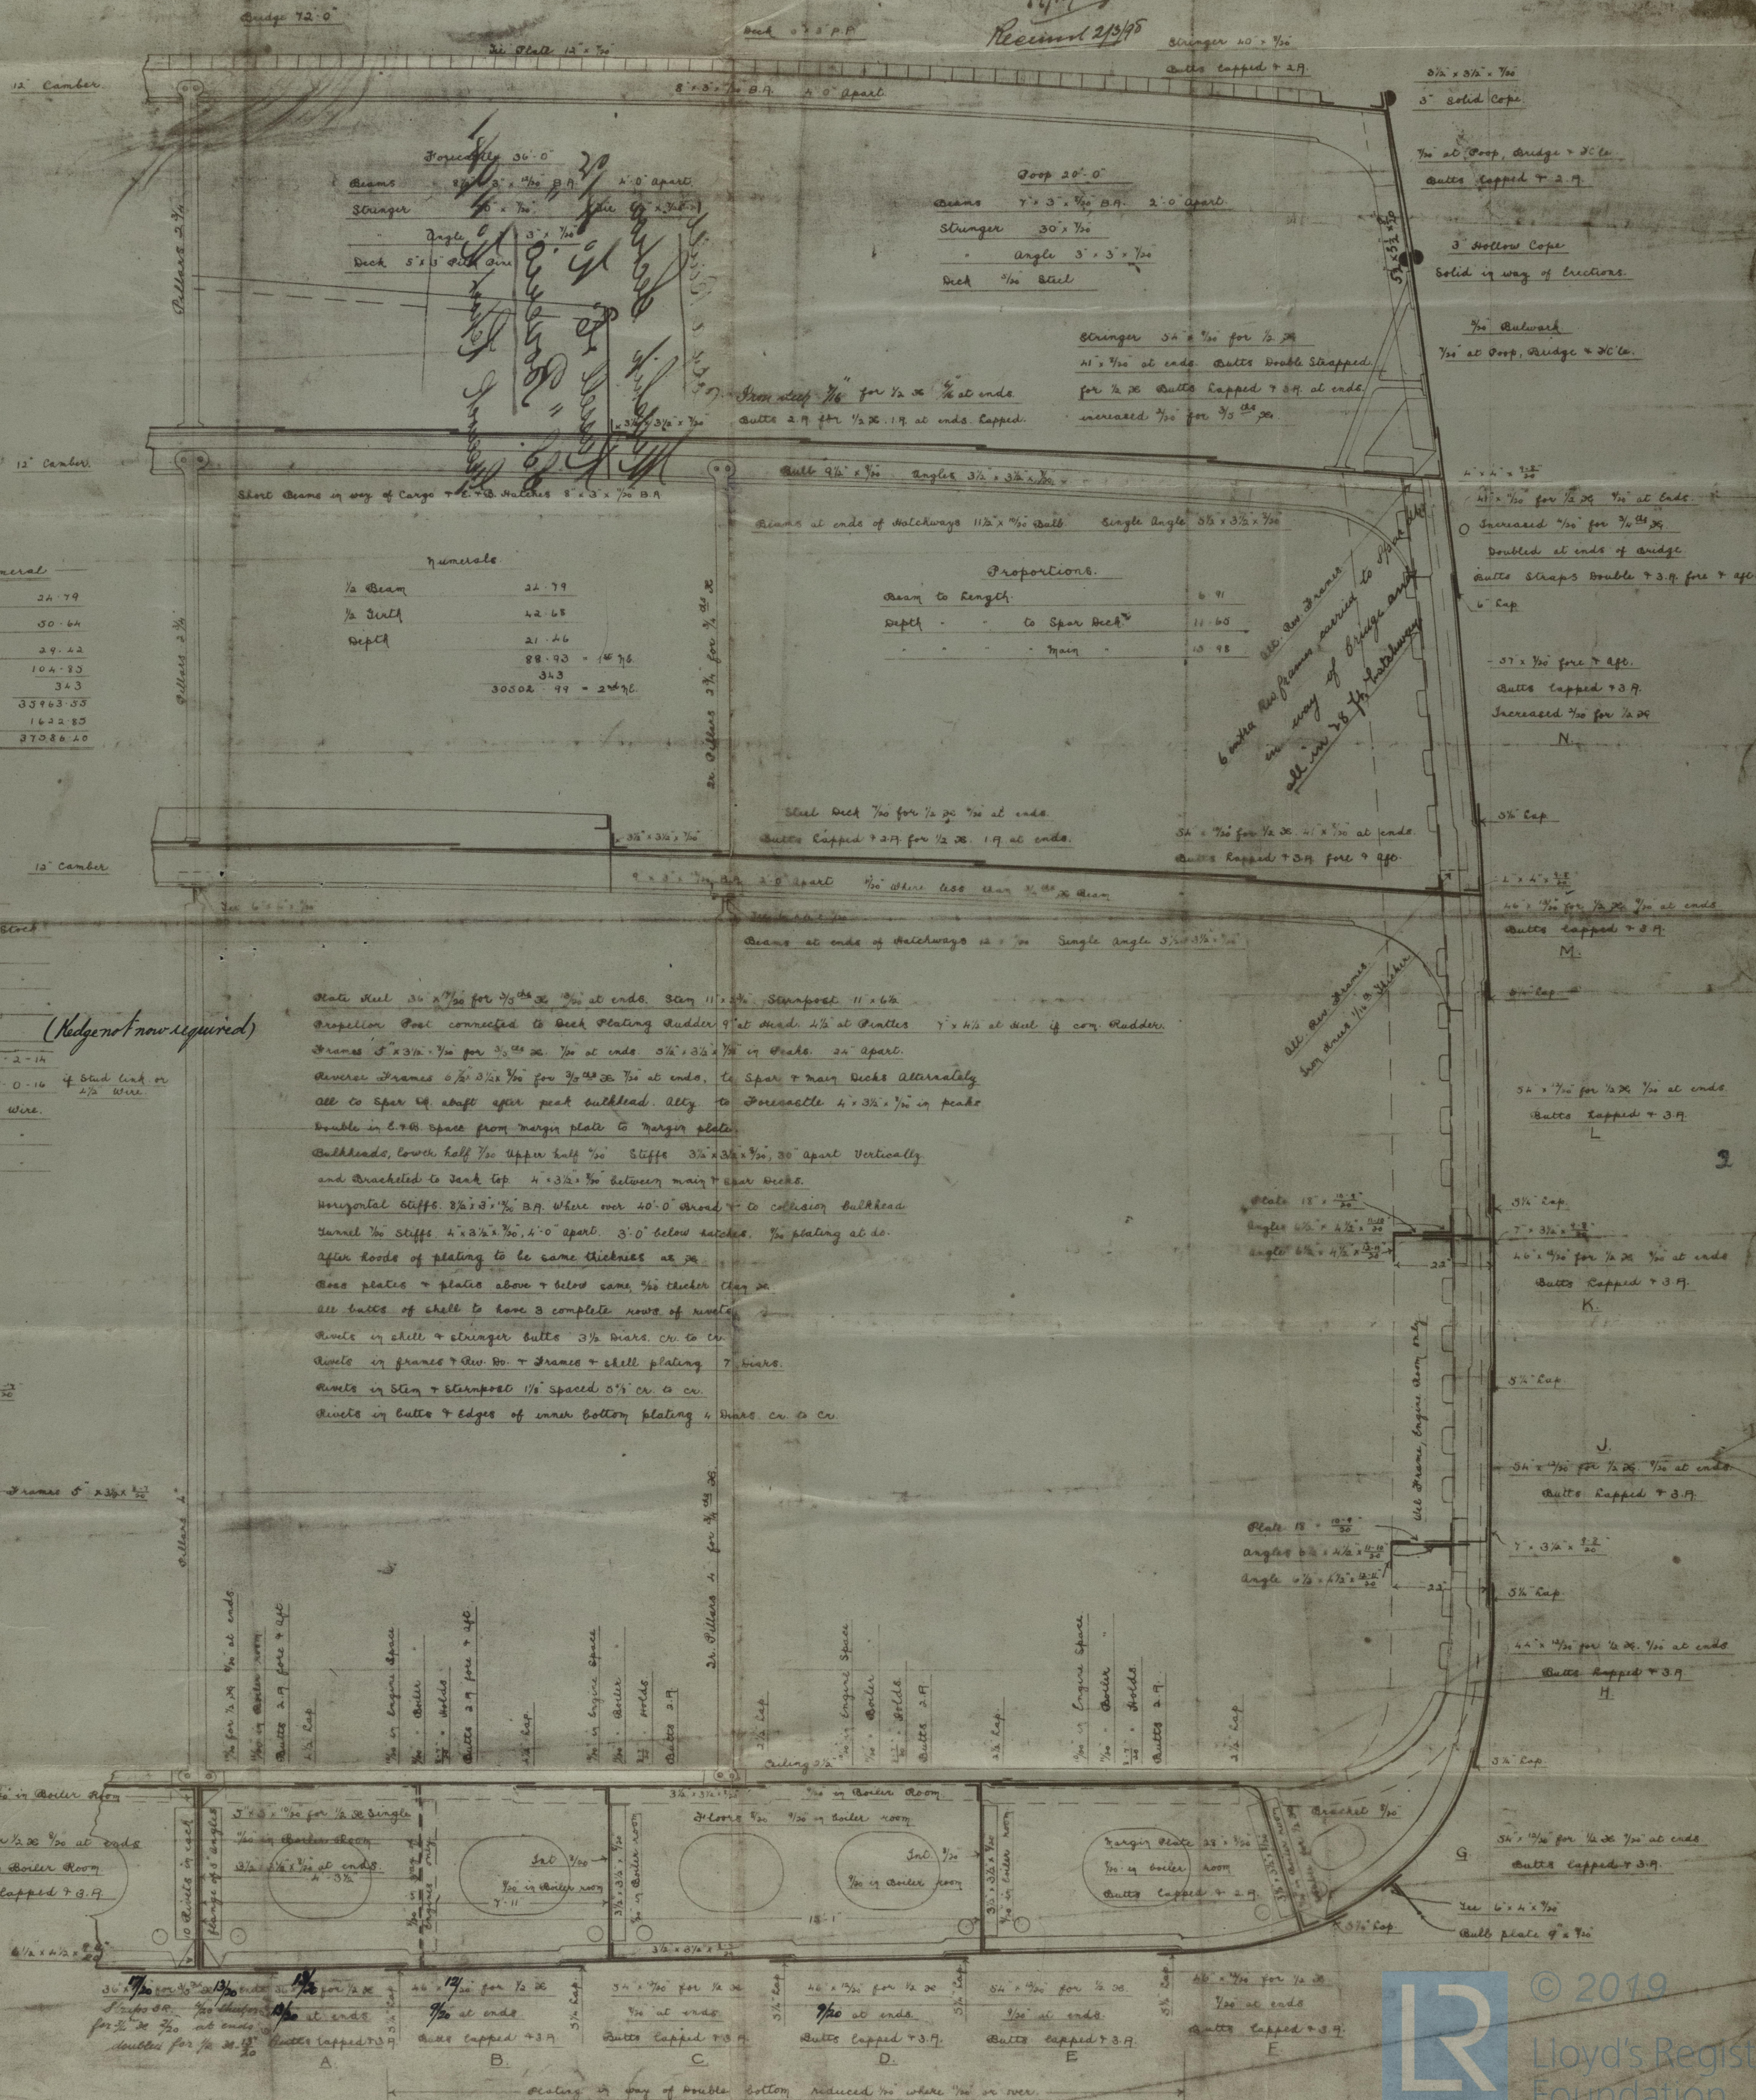

Adv. Vol.

SM Lc 'SVARTEN' But. P. 1898. 2mo.

Midship Section (Oware)

(File with FE. 2d. 11941)

GRK 340-0117



© 2019

Lloyd's Register
Foundation