

Received at Greenock Office, 10th June 1897.

Lloyd's Register of British and Foreign Shipping.

(Report on Vessel No. 11941 Port Greenock)

S.S. "Boderic"

No. 3678

SHIP FORGINGS OR CASTINGS.

The words FORGINGS or CASTINGS, IRON or STEEL, should be struck out as may be required.

I have to report that the undermentioned Iron or Steel Forgings or Castings, manufactured by the Jarrow Forge Co of Jarrow for the Vessel No. 412, being built by Messrs Russell & Co of Greenock have been inspected by me as set forth below, and found to be, so far as can be seen, sound



Mark on Forgings.

Lloyd's
No. 61145
J

John C Craig
Newcastle

	STERN FRAME.	RUDDER FRAME.	STEM.
Material* ...	<u>Scrap</u>	/	<u>Scrap</u>
How made ...	<u>Forged</u>		<u>Forged</u>
Dimensions ...	<u>11 - 6 1/2</u>		<u>11 - 2 3/4</u>
Progress on Inspection	<u>Forged & Smithed</u>		<u>Smithed</u>
Date when Inspected	<u>April 1 to June 5/97</u>		<u>April 26/97</u>

SKETCHES OF FRAMES SHOWING POSITION AND DESCRIPTION OF WELDS OF FORGINGS, OR PARTICULARS OF TESTS APPLIED TO CASTINGS.

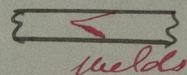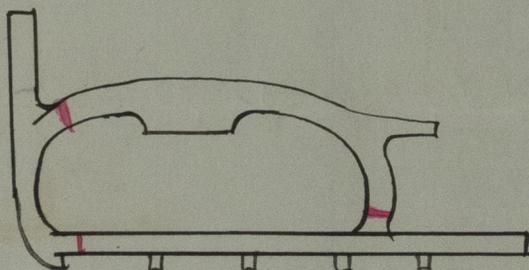

Fee (if any chargeable) £ : :

To be paid at



© 2019

Lloyd's Register
Foundation

* If of Iron, state whether scrap or puddled Iron. GRK 340-0919