


MacLachlan Patent
Rudder

2/7/87

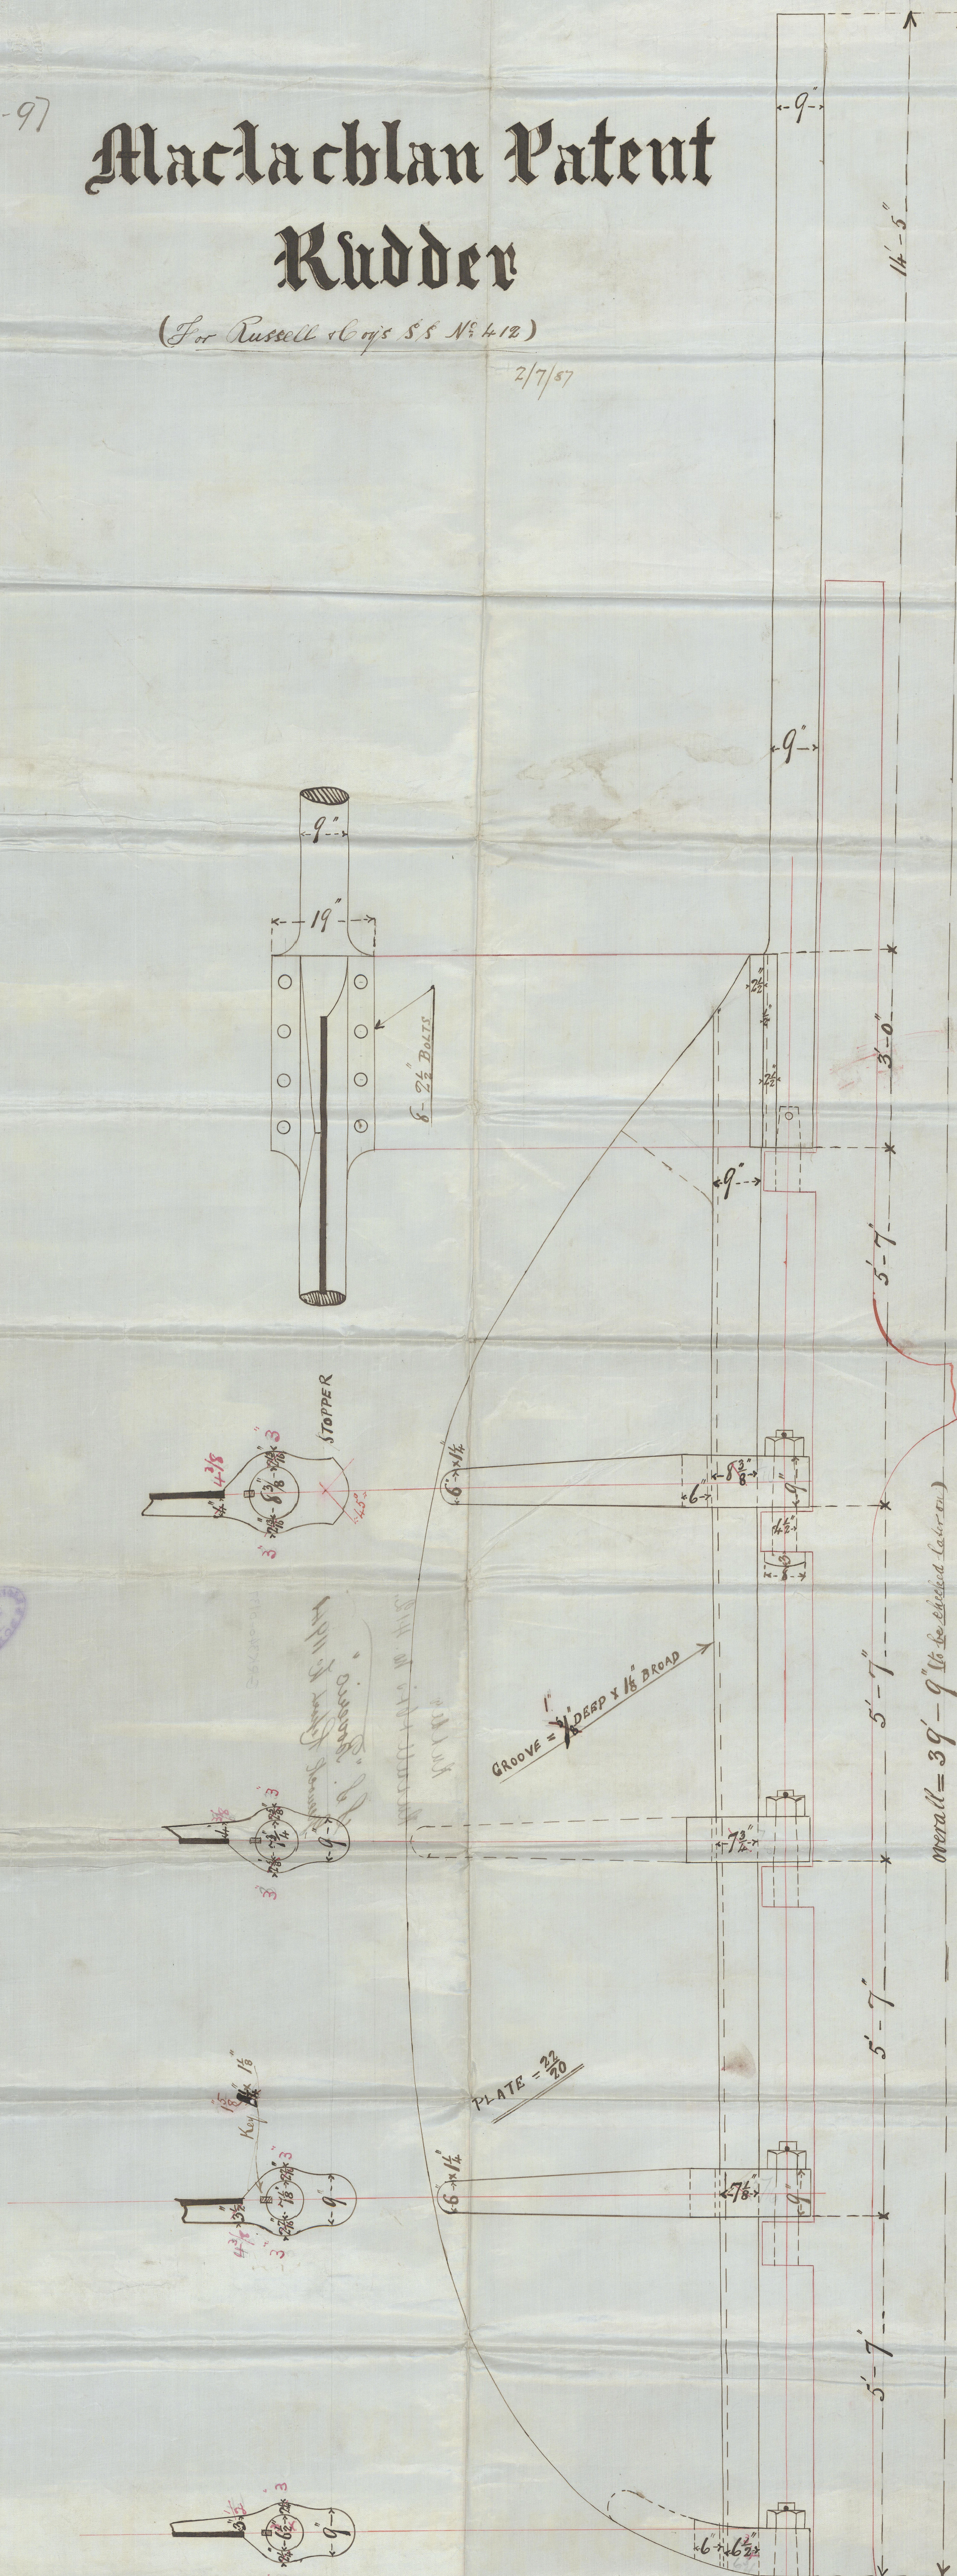

J.V.L.
7/7/97

Rudder

Russell & Co's No. 412.

S.S. "Boveris"
Greenock Report No 11941

GRK340-0137



© 2021

Lloyd's Register
Foundation

