

Lloyd's Register of British and Foreign Shipping.

Greenock (Report on Vessel No. 12014 Port Greenock)
S.S. "Febrero" ex "Almirante Colon"

No. 3314 a. SHIP FORGINGS OR CASTINGS.

I have to report that the undermentioned Iron ~~or Steel~~ Forgings ~~or Castings~~,
 manufactured by Messrs B W Reid & Co.
 of Sunduland for the Vessel No. 48, being built
 by The Campbeltown S & Co. of Campbeltown
 have been inspected by me as set forth below, and found to be, so far as can be seen,
sound.

Mark on Forgings.

Lloyd's



No. 3314 a.

No. 6

Wm CameronSunduland
24-10-96

	STERN FRAME.	RUDDER FRAME.	STEM.
Material* ...	<u>Scrap iron</u>	<u>Scrap iron</u>	<u>Scrap iron</u>
How made ...	<u>Forged</u>	<u>Forged</u>	<u>Forged</u>
Dimensions ...	<u>9' x 5'</u>	<u>7' - 3 1/2'</u>	<u>9' x 2 1/2'</u>
Progress on Inspection	<u>Forged & Smithed</u>	<u>Forged & Smithed</u>	<u>Forged</u>
Date when Inspected	<u>May 11th to June 19/96</u>	<u>July 1st to Sept 14/96</u>	<u>May 22/96</u>

SKETCHES OF FRAMES SHOWING POSITION AND DESCRIPTION OF WELDS OF FORGINGS, OR PARTICULARS OF
 TESTS APPLIED TO CASTINGS.

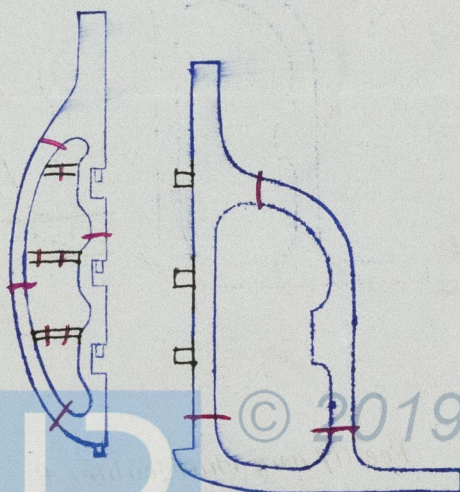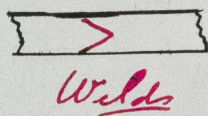

Fee (if any chargeable) £ : . .

To be paid at

* If of Iron, state whether scrap or puddled Iron.