


Same as No. 382 - "Rosedale"

Mosher Section

No^s 382 & 383 & Nos 392 & No 419

Reg. Dims. 246.0 x 34.0 226 hole

Scale $\frac{1}{2}$ " = 1 foot

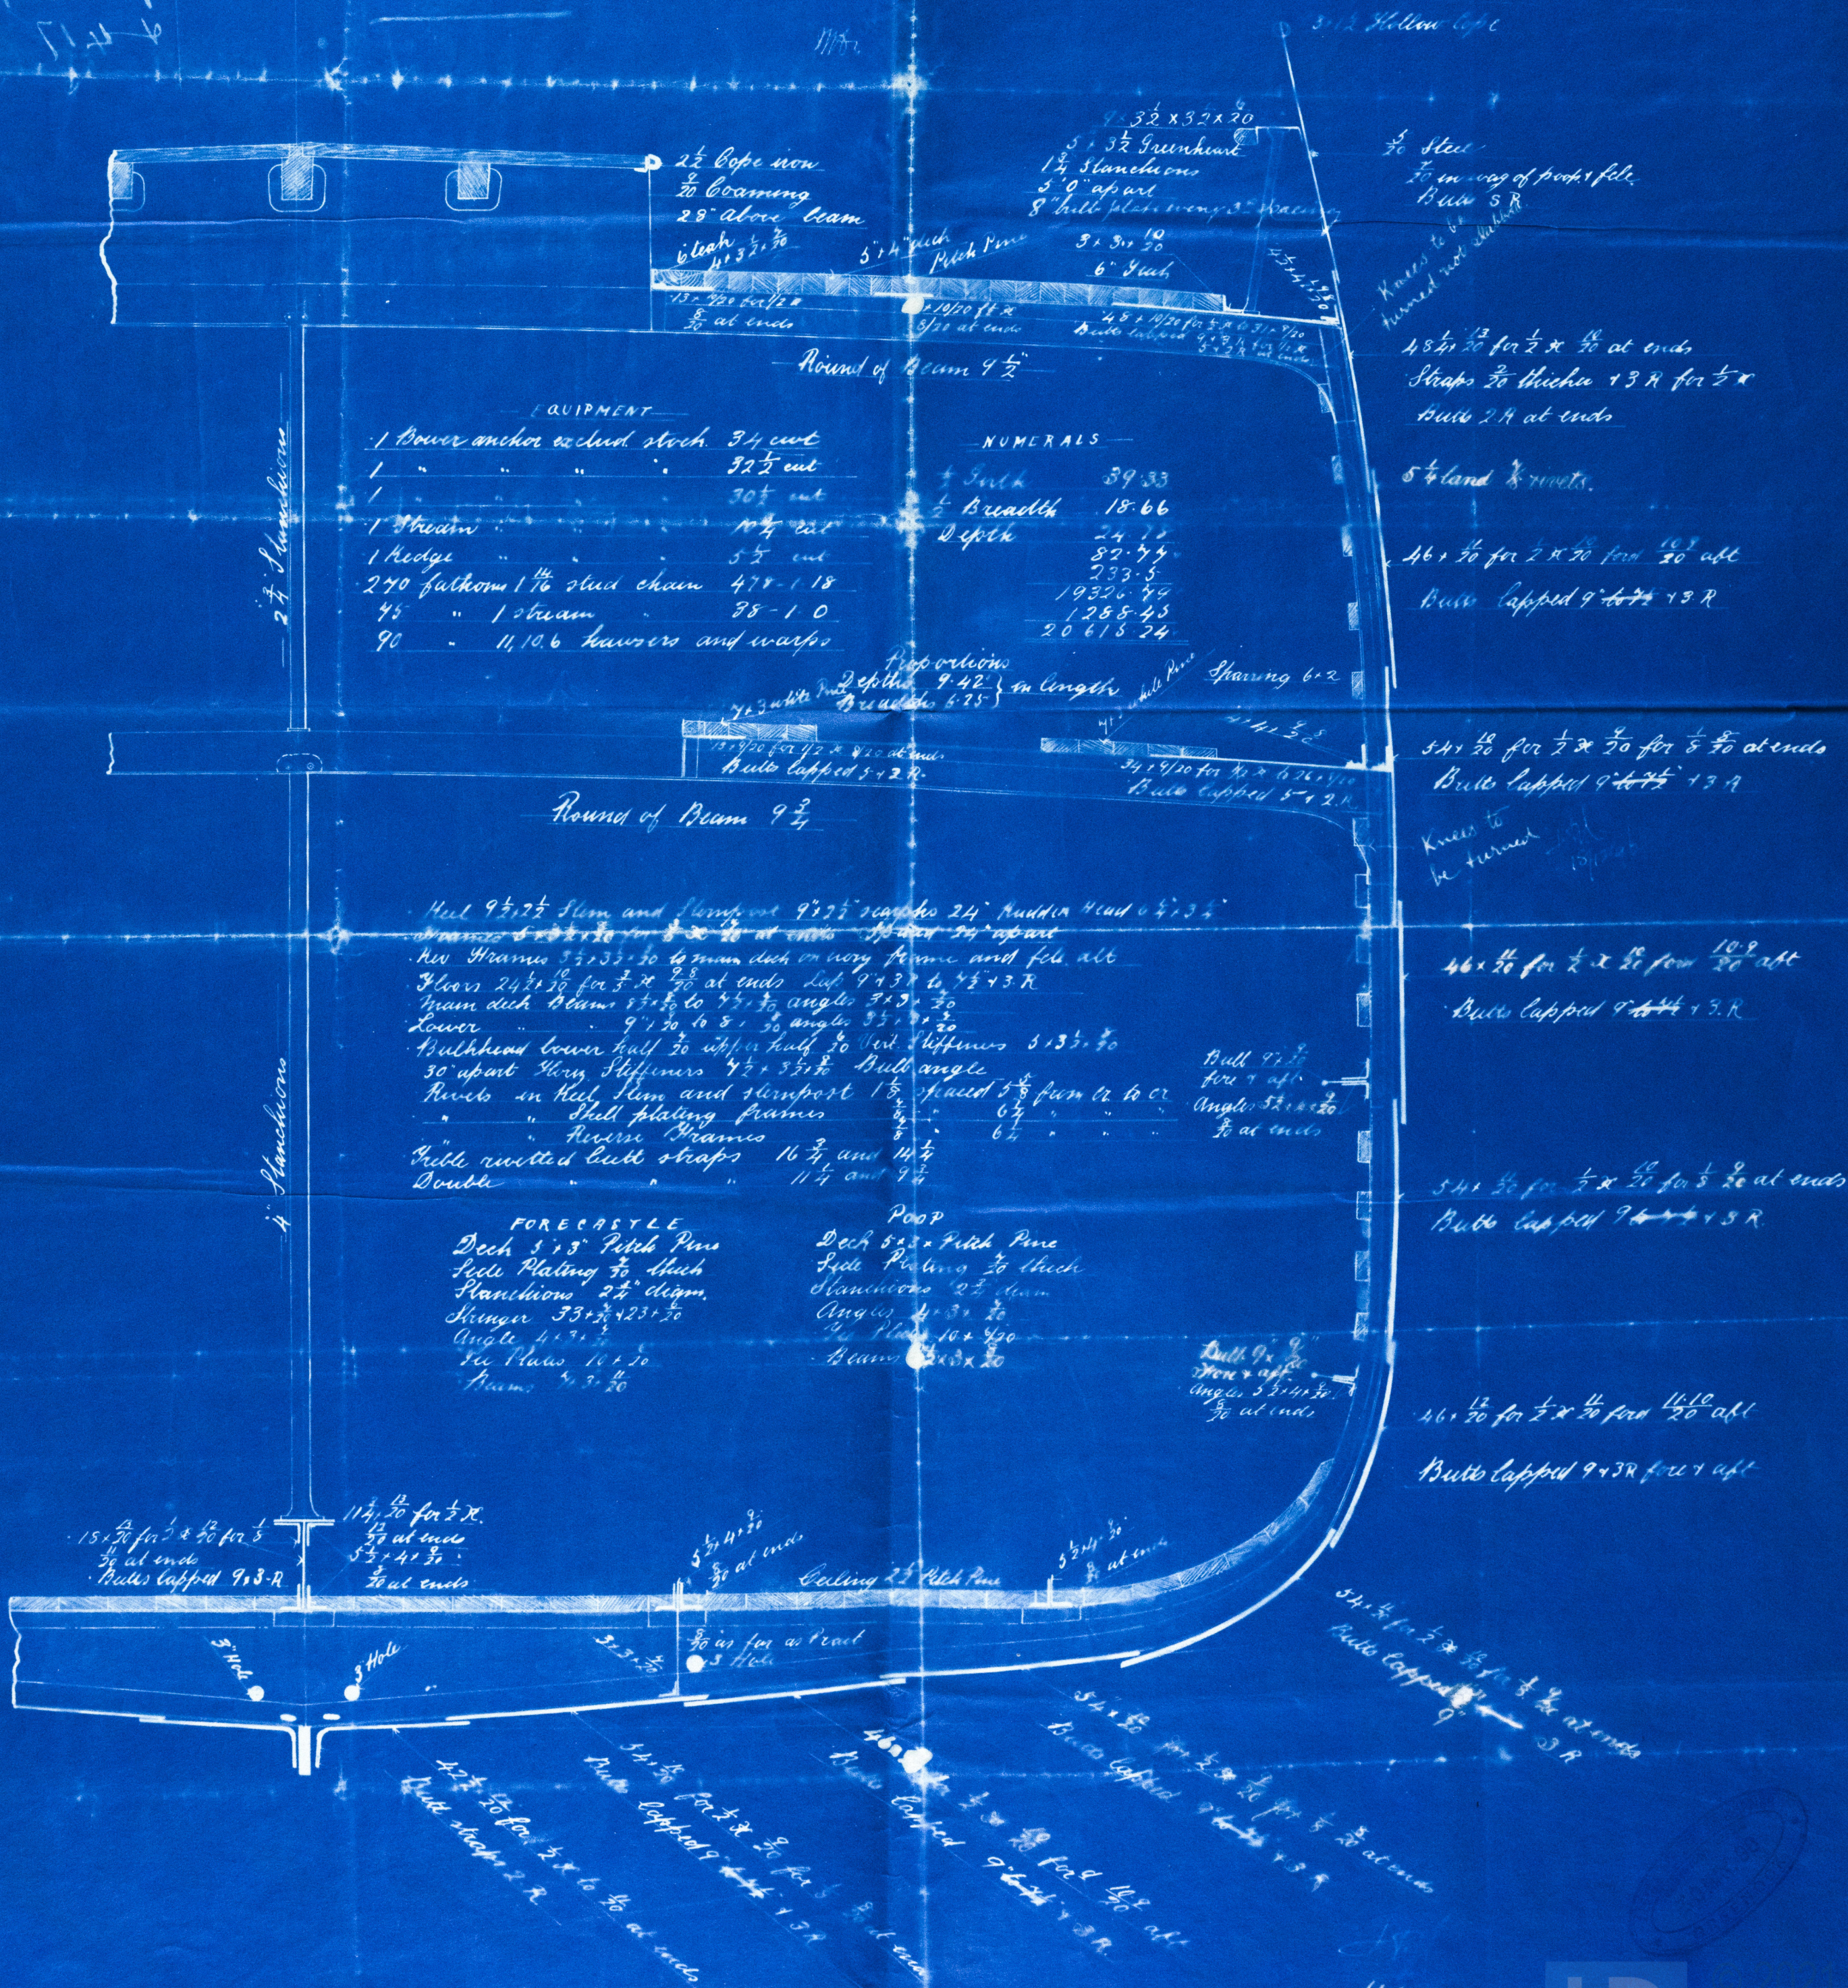

3/15/95
28/11/95
18/12/95

GRK 341 0115

Cohy of Midship Section

Russell & Co. 382, 383, 392 & 417.

382 "Kittredale" got Report 6. 11378

383 "Dune low" do 11594

392 "Oakburn" do 11655

417 "Inverclyde" do 12048

Same as Kittredale.

GRK34-0115



© 2021

Lloyd's Register
Foundation