


R/R 3:98
 24/10/98
 REGISTER OF SHIPS
 LONDON

— Pumping Arrangement of No 241 T.S.S. —

— Scale $\frac{1}{8}'' = 1 \text{ foot}$ —

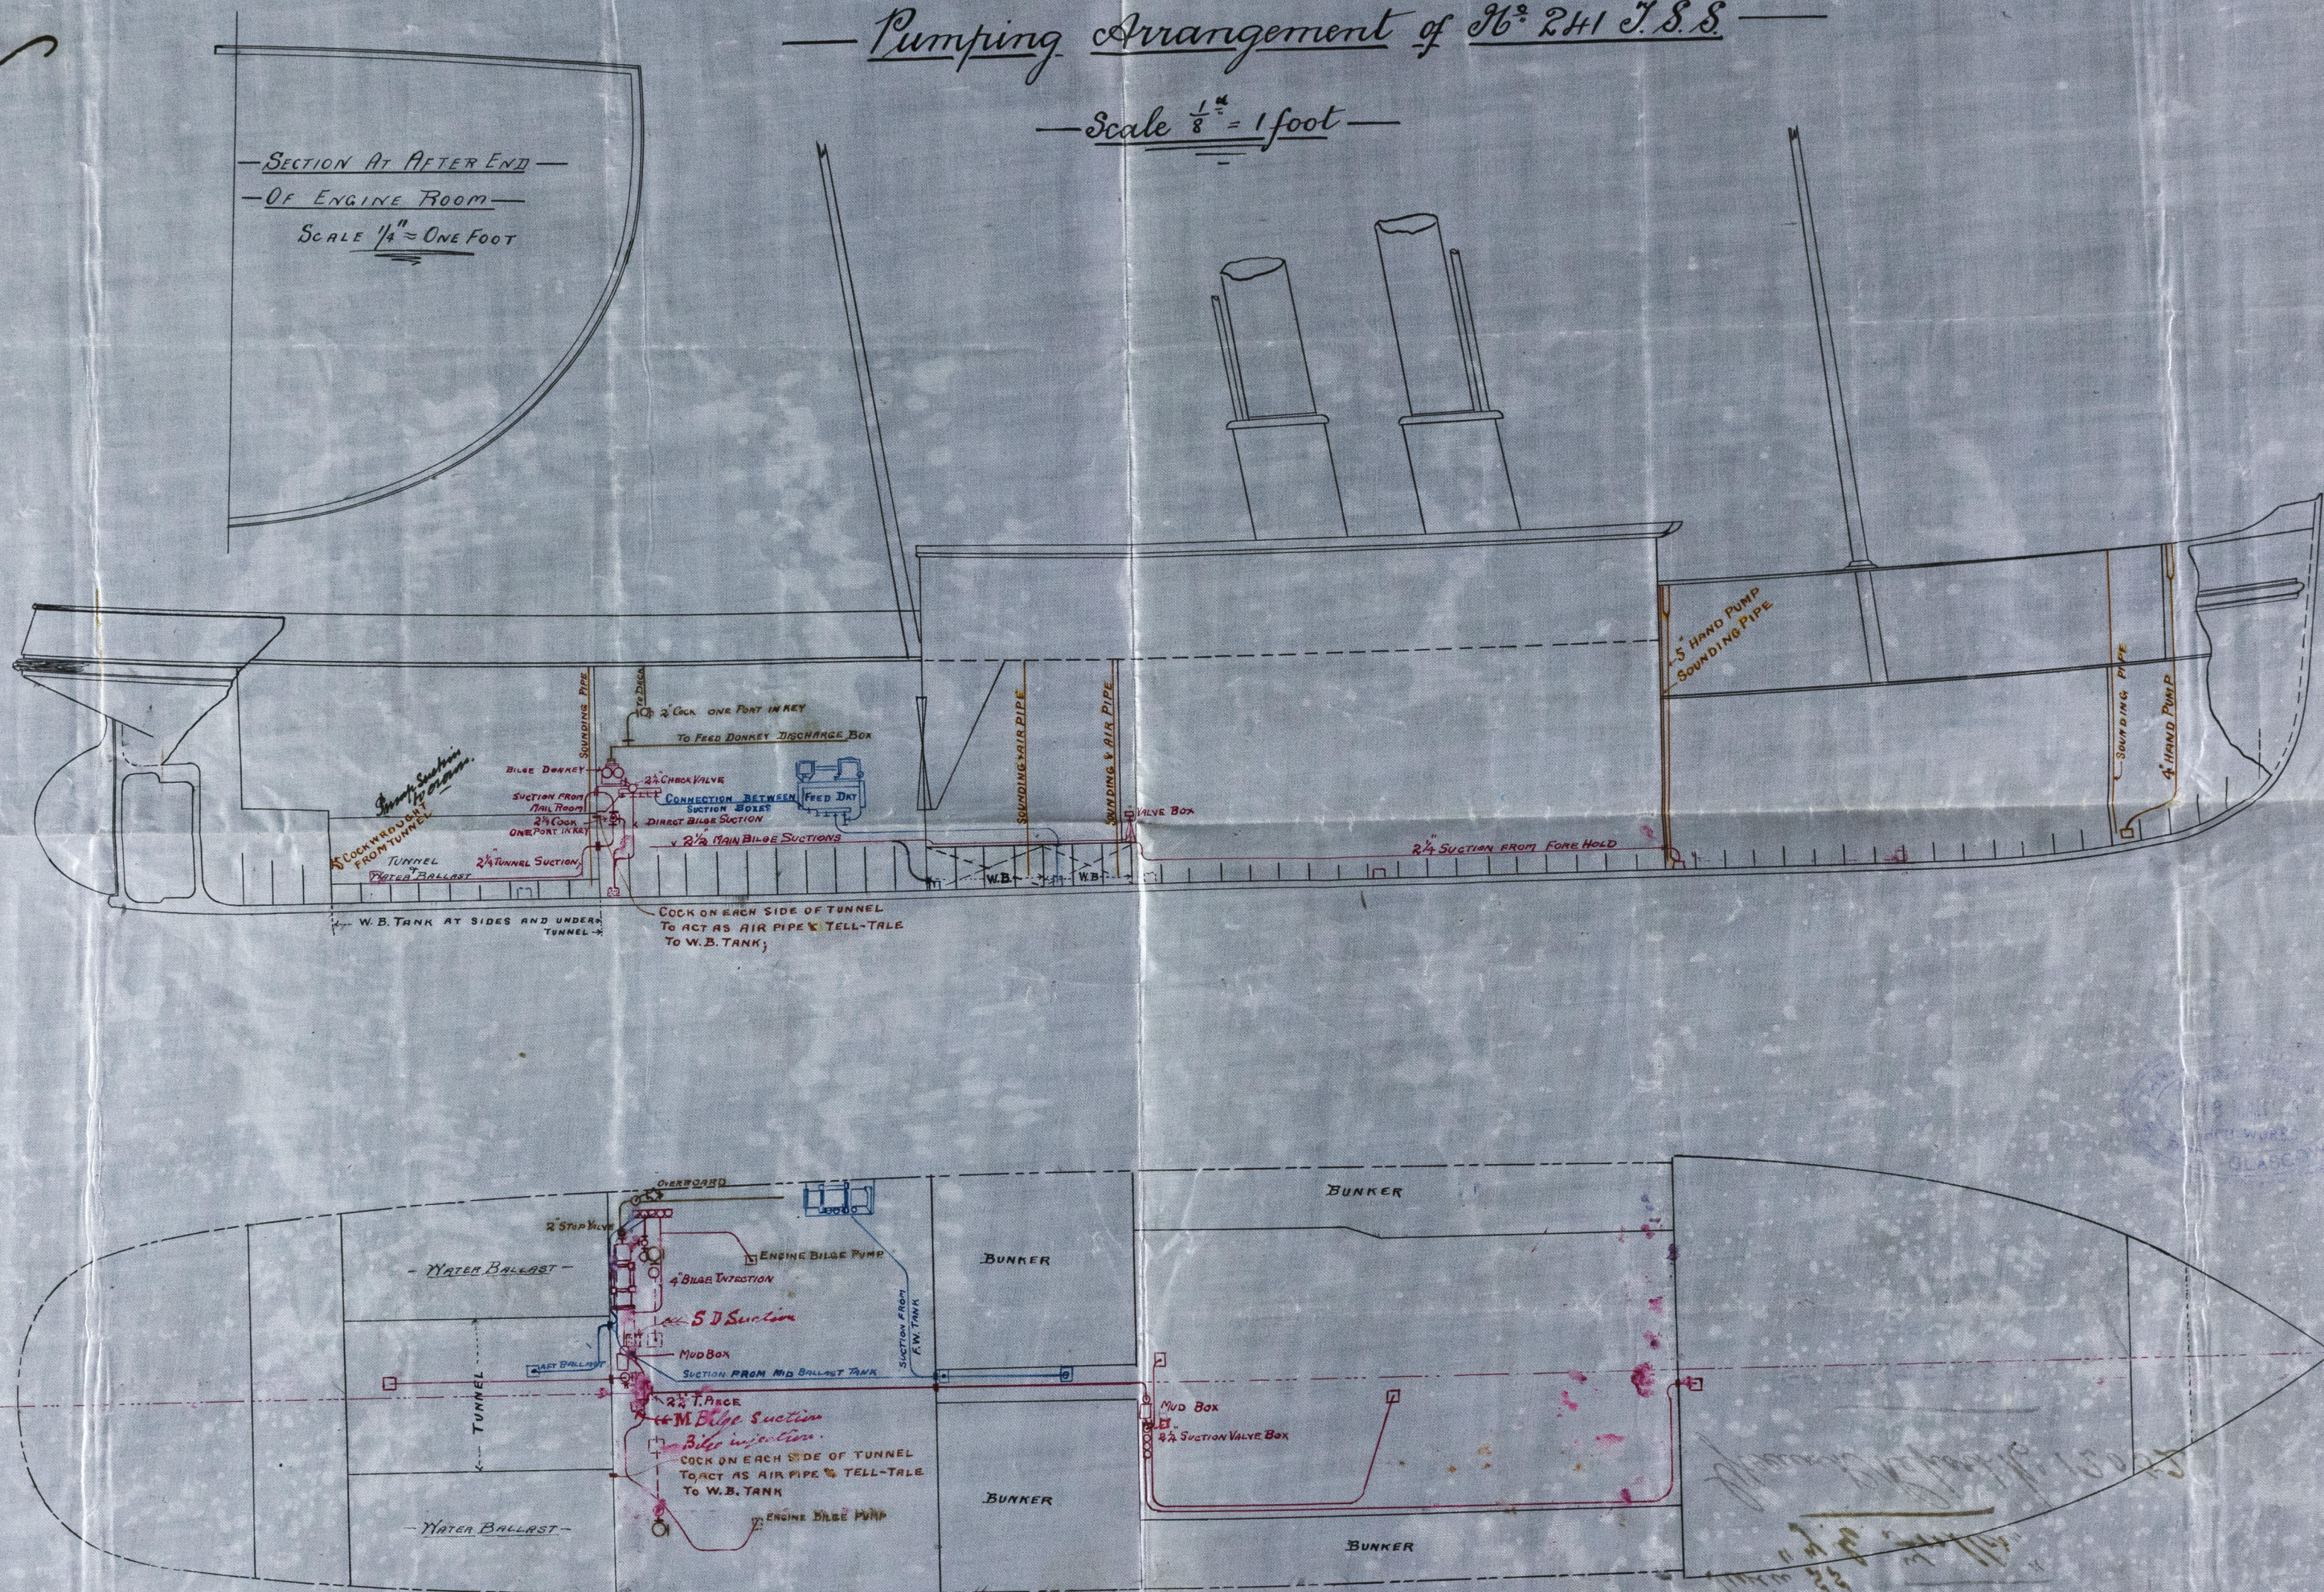

- Bilge Suctions
- Ballast Tank Suctions
- Donkey Discharges
- Deck Pumps & Suctions

23/3/98
 Lloyd's Register
 GRK 341-0123

Lloyd's Register
Foundation