

N^o 241


MIDSHIP SECTION OF STEEL TWIN TUG STEAMER

TO CLASS 100A1 AT LLOYDS

LENGTH B.P 135 FEET BREADTH 26 FEET DEPTH MOULDED 14 FEET

SCALE 1/2 INCH = 1 FOOT

6.11.97
2.12.97

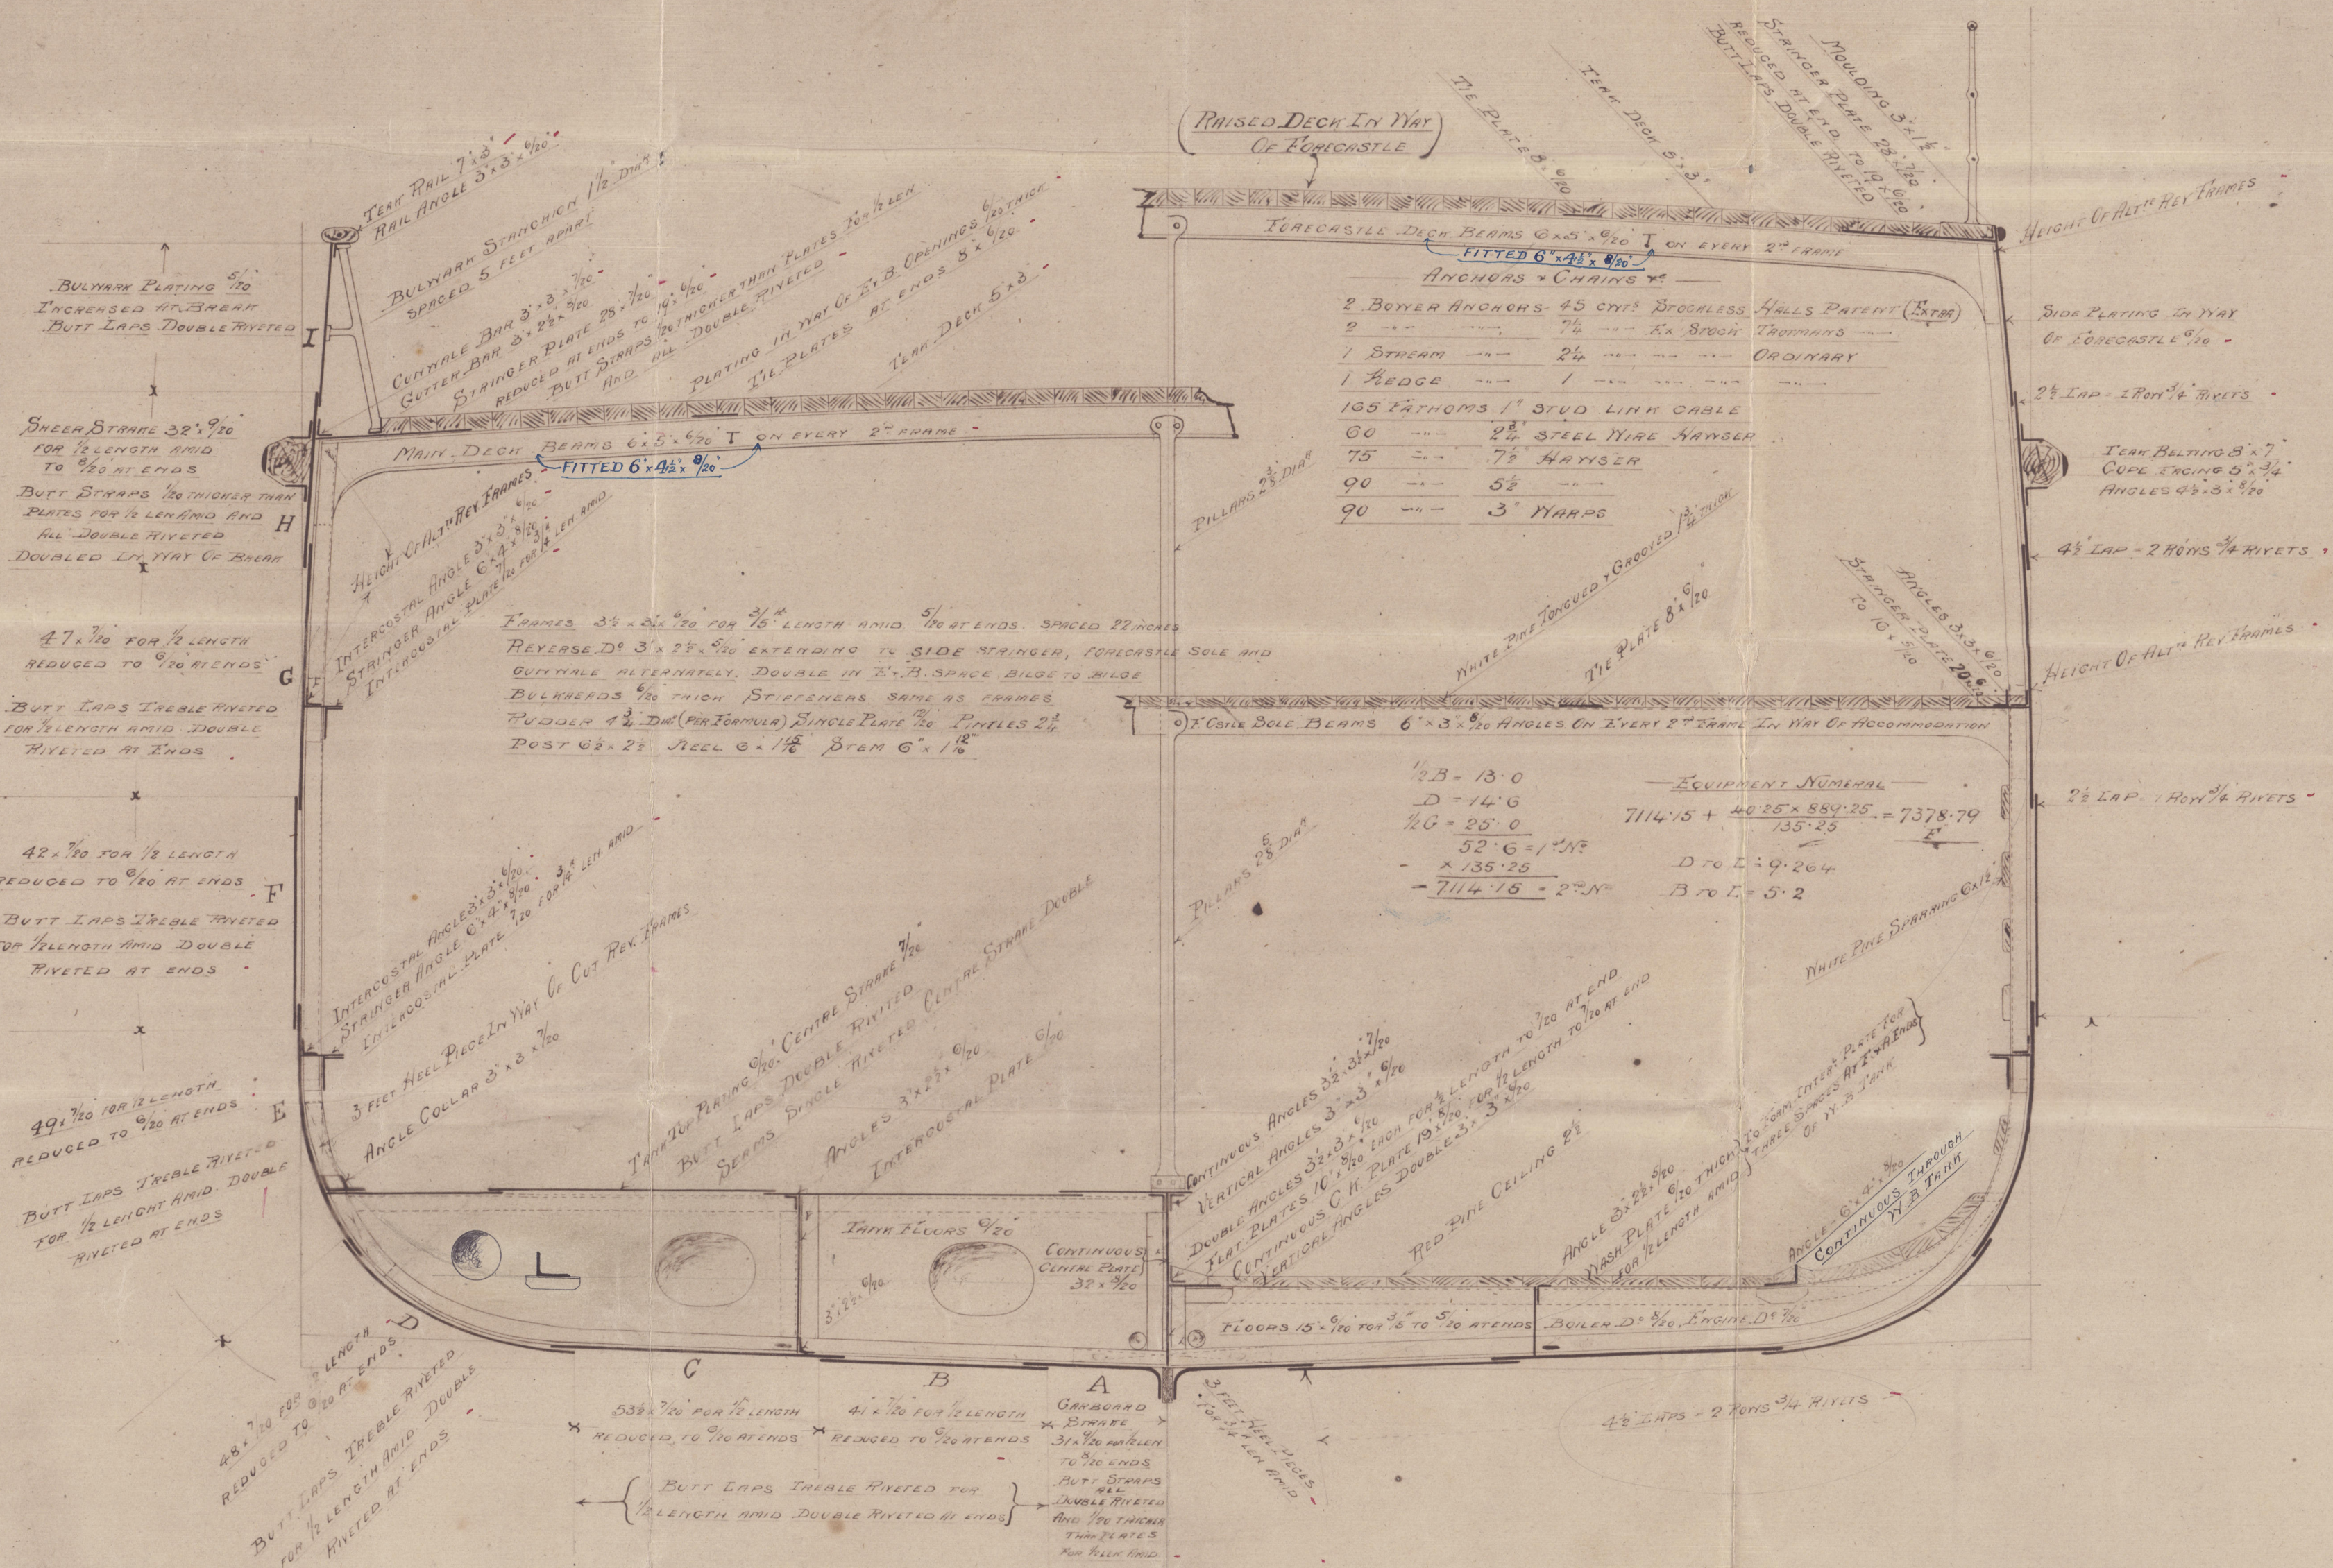

NOTE - SHELL PLATING AT BOW TO BE DOUBLED IN 10 FEET AHEAD STEAM.

DAVID J. DUNLOP & CO.
ENGINEERS & SHIPBUILDERS
PORT GLASGOW
31 Nov. 1897

© 2021

Lloyd's Register
Foundation

G-RK 341-0125



Midship section
2 J.D. manuscripts no. 241.

S.S. "J.E. Fuller"
Greenock Report to 12052

GRK34-0125



© 2021

Lloyd's Register
Foundation