


3rd Nov. 1897

SCALE $\frac{1}{8}$ " = 1 FOOT.

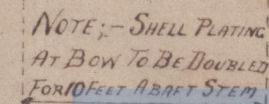

© 2021



Lloyd's Register
Foundation

GRK 341-0126

longitudinal section
D. J. Dunlop No. 241.
241

S. S. J. E. Fuller
Greenock Report 6/12052

GRK 341-0126

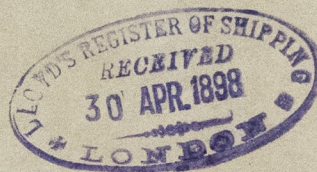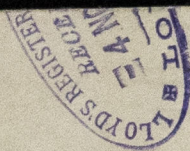

© 2021

Lloyd's Register
Foundation