

Lloyd's Register of British and Foreign Shipping.

(Report on Vessel No. 12052 Port

Greenock)

S.S. "J. E. Huller"

No. 6078 SHIP FORGINGS OR CASTINGS.

I have to report that the undermentioned Iron or Steel Forgings or Castings,
 manufactured by The Irvine Forge Coy
 of Irvine for the Vessel No. 241, being built
 by Messrs J Dunlop & Coy of Port Glasgow
 have been inspected by me as set forth below, and found to be, so far as can be seen,
Sound & efficient

Mark on Forgings.

Lloyd's

No. 6078

W.H.

William Hamilton


Glasgow

19/1/98

STEM & Hull bar

	STERN FRAME.	RUDDER FRAME.	
Material*	Scrap iron	Scrap iron	
How made	Forged	Forged	
Dimensions	62 1/2 x 2 1/2	6 x 1 1/2	
Progress on Inspection	Forging & smithing	Forging	
Date when Inspected	16/12/97 to 18/1/98	12 to 26/11/97	

SKETCHES OF FRAMES SHOWING POSITION AND DESCRIPTION OF WELDS OF FORGINGS, OR PARTICULARS OF TESTS APPLIED TO CASTINGS.

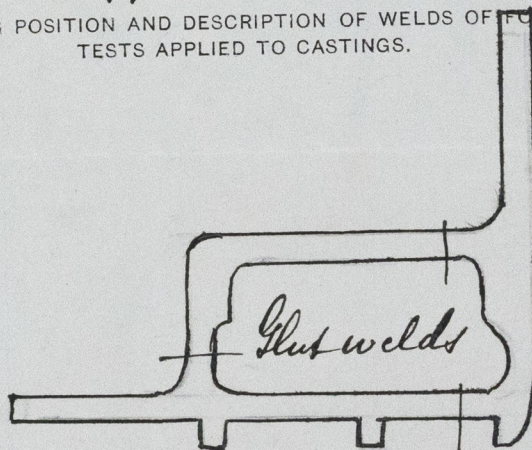

Fee (if any chargeable) £

To be paid at

* If of Iron, state whether scrap or puddled Iron.