

Received at Glasgow Office, 22nd June 1898

Lloyd's Register of British and Foreign Shipping.

(Report on Vessel No. _____ Port _____)

No. 6461 SHIP FORGINGS OR CASTINGS.

I have to report that the undermentioned Iron or Steel Forgings or Castings,
manufactured by Messrs Matthew Reid & Co
of Glasgow for the Vessel No. 111, being built
by Bilbao of Bilbao
have been inspected by me as set forth below, and found to be, so far as can be seen,

Vessel repaired Messrs A Rodger & Co
of Port Glasgow

William Hamilton
Glasgow 20/6/98

STERN FRAME.

Revised RUDDER FRAME.

STEM.


Scrap iron
Forged
9 x 5

Scrap iron
Forged
7 to 5 1/2 inches 3 1/2

Forging & smithing Forging & finishing

25/5/98 to 3/6/98 25/5/98 to 16/6/98

ETCHES OF FRAMES SHOWING POSITION AND DESCRIPTION OF WELDS OF FORGINGS, OR PARTICULARS OF TESTS APPLIED TO CASTINGS.

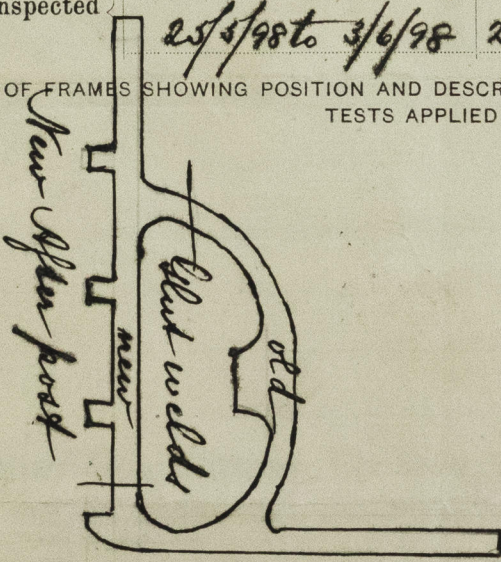

(if any chargeable) £ 2 : 2 : 0

To be paid at GLASGOW

* If of Iron, state whether scrap or puddled Iron.

© 2019

Lloyd's Register
Foundation

GRN342-0017