

Received at Greenock Office, 12<sup>th</sup> 9<sup>th</sup> 1898

## Lloyd's Register of British and Foreign Shipping.

(Report on Vessel No. 12419 Port Greenock)S.S. AuchendarinNo. 6505 SHIP FORGINGS OR CASTINGS.

I have to report that the undermentioned Iron ~~or Steel~~ Forgings ~~or Castings~~,  
 manufactured by Messrs Matthew Reid & Co  
 of Kilmarnock for the Vessel No. 444, being built  
 by Messrs Russell & Co of Port Glasgow  
 have been inspected by me as set forth below, and found to be, so far as can be seen,  
Sound & efficient


Mark on Forgings.

Lloyd's

No. 6505W.H.William HamiltonGlasgow 10/9/98

	STERN FRAME.	RUDDER FRAME.	STEM.
Material* ...	<u>Scrap iron</u>		
How made ...	<u>Forged</u>		
Dimensions ...	<u>11 ft 6 in</u>		
Progress on Inspection	<u>Forging &amp; smithing</u>		
Date when Inspected	<u>9/8/98 to 9/9/98</u>		

SKETCHES OF FRAMES SHOWING POSITION AND DESCRIPTION OF WELDS OF FORGINGS, OR PARTICULARS OF  
 TESTS APPLIED TO CASTINGS

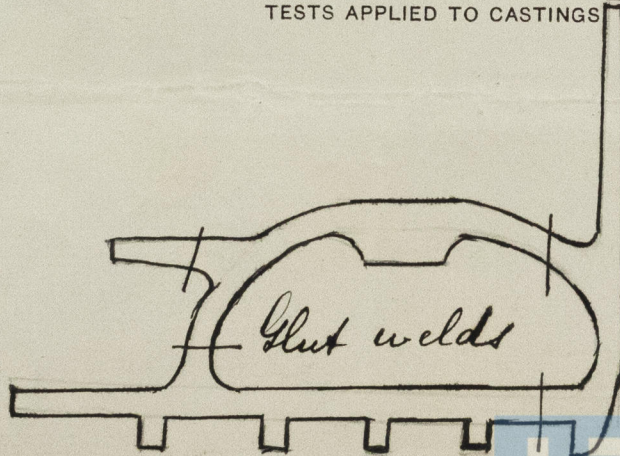

Fee (if any chargeable) £ : :

To be paid at