


31.5.98

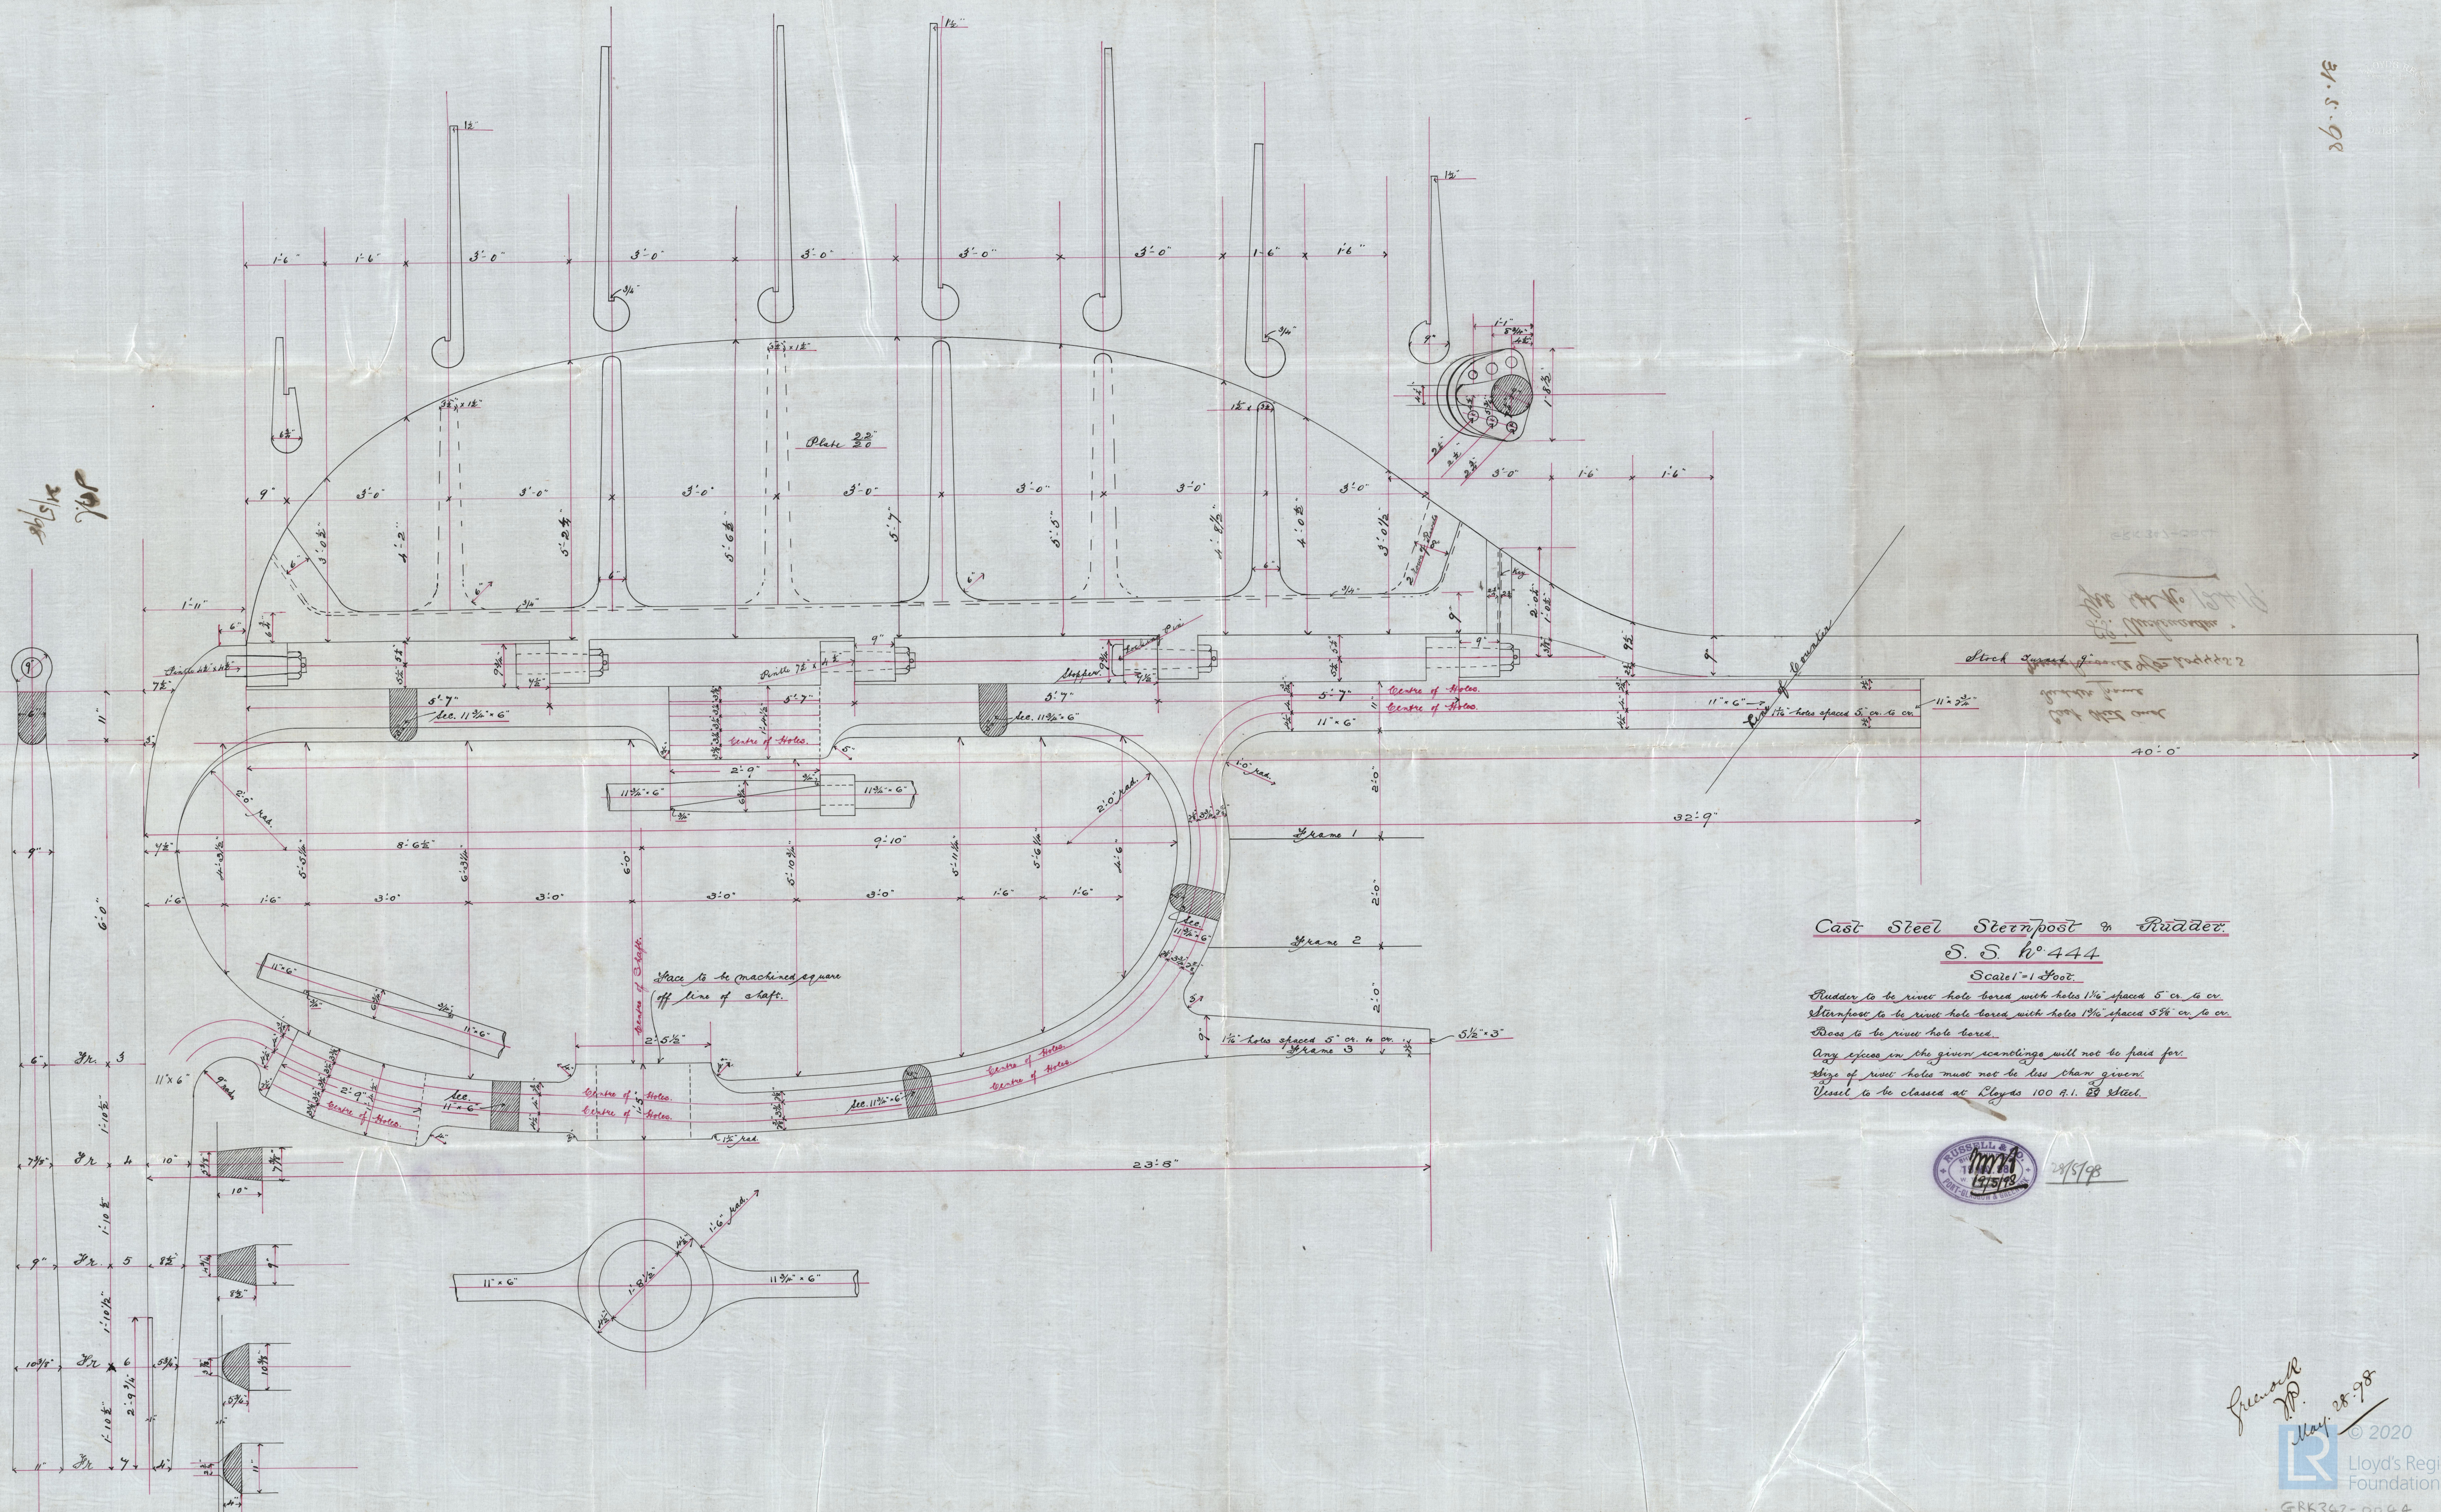

Cast Steel Sternpost & Rudder.
S. S. No 444
 Scale 1" = 1 Foot.

Rudder to be rivet hole bored with holes 1 1/4" spaced 5" or 6" or.
 Sternpost to be rivet hole bored with holes 1 1/4" spaced 5 1/2" or 6" or.
 Boss to be rivet hole bored.
 Any spaces in the given scantlings will not be paid for.
 Size of rivet holes must not be less than given.
 Vessel to be classed at Lloyd's 100 A.I. 25 Steel.



28/5/98

Freemantle
 May 28. 98

Cast Steel and
Rudder frame

Messrs Russell & Co 20444 S. S

S. S. Auchendarren
Gen ltr No 12419.

GRK 347-0044



© 2020

Lloyd's Register
Foundation