

For the information of Surveyors and the Committee only.

Received at Greenock Office. 11-8-1899

Lloyd's Register of British and Foreign Shipping.

Greenock (Report on Vessel No. 12504 Port Greenock)
Iron

No. 4065a SHIP FORGINGS OR CASTINGS.

The words FORGINGS or CASTINGS, IRON or STEEL, should be struck out as may be required.

I have to report that the undermentioned Iron or ~~Steel~~ Forgings or ~~Castings~~,
manufactured by Wm & Co Reed Co.
of Sunderland for the Vessel No. 59, being built
by The Campbeltown S.S. Co. of Campbeltown
have been inspected by me as set forth below, and found to be, so far as can be seen,
Sound

Mark on Forgings.


Lloyd's
No. 4065a
106

Wm & Co Reed

Sunderland
10/8/99

	STERN FRAME.	RUDDER FRAME.	STEM.
Material*	<u>Scrap</u>	<u>Scrap</u>	<u>Scrap</u>
How made	<u>Forged</u>	<u>Forged</u>	<u>Forged</u>
Dimensions	<u>7 1/2 x 2 3/4</u>	<u>5 1/2 - 3"</u>	<u>7 1/4 x 2 3/8</u>
Progress on Inspection	<u>Forged & Smithed</u>	<u>Forged & Smithed</u>	<u>Forged</u>
Date when Inspected	<u>Jan'y 28th & Feb'y 23/99</u>	<u>April 13th to June 16/99</u>	<u>July 23/99</u>

SKETCHES OF FRAMES SHOWING POSITION AND DESCRIPTION OF WELDS OF FORGINGS, OR PARTICULARS OF TESTS APPLIED TO CASTINGS.

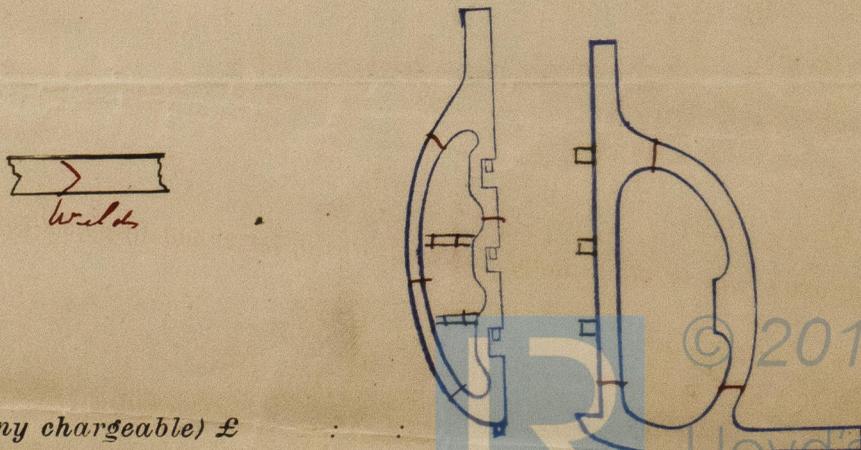

Fee (if any chargeable) £

To be paid at