

Longitudinal Section & Deck Plans

J. F. No. 144



DIMENSIONS. 330' x 45' 6" x 266' 7" SPAR DR.

CLASS 100 H. SPAR DR WITH FREEBOARD.

Scale 8 In. = 1 Foot.



7.7.98
25.7.98
3.8.98

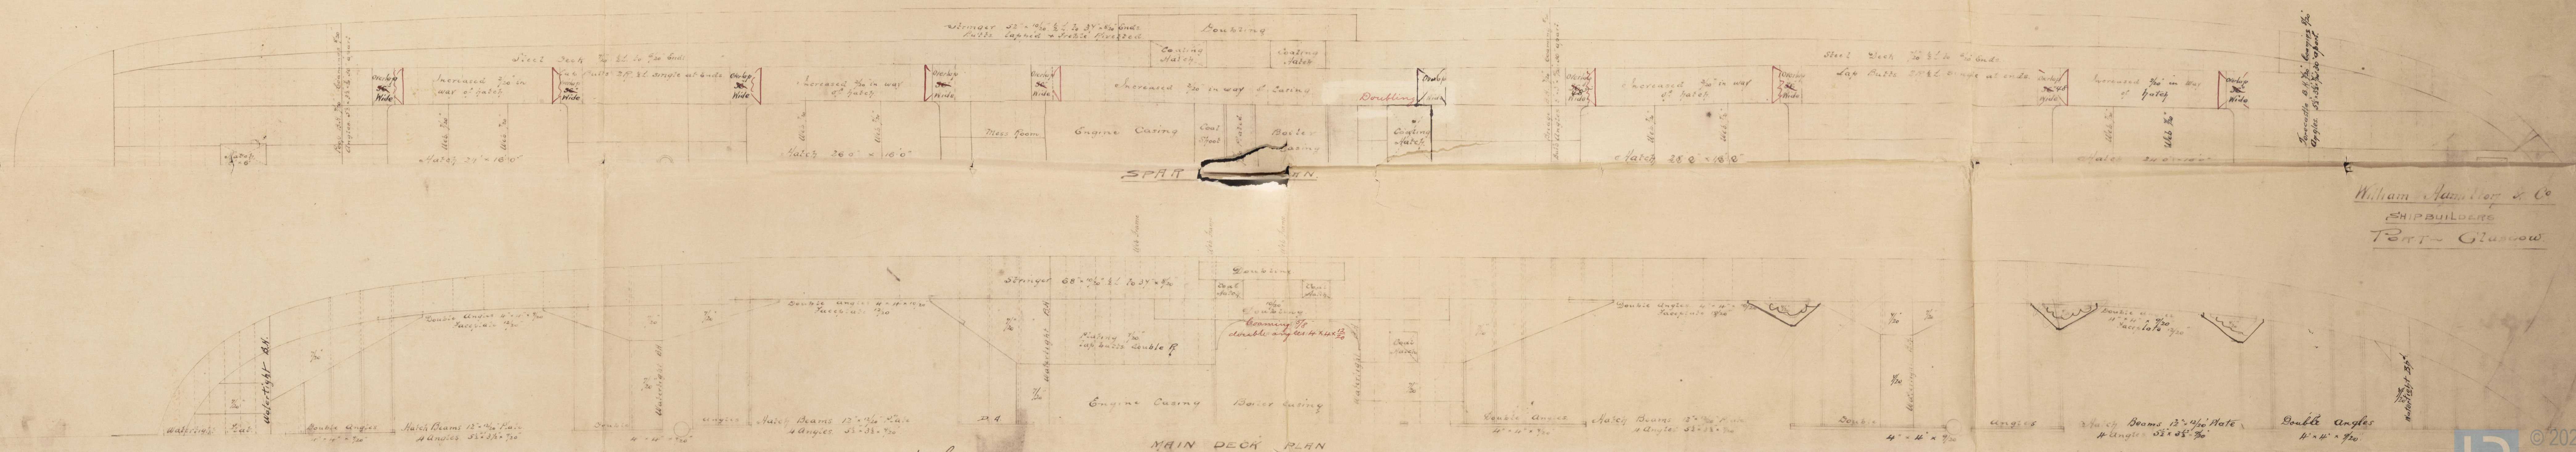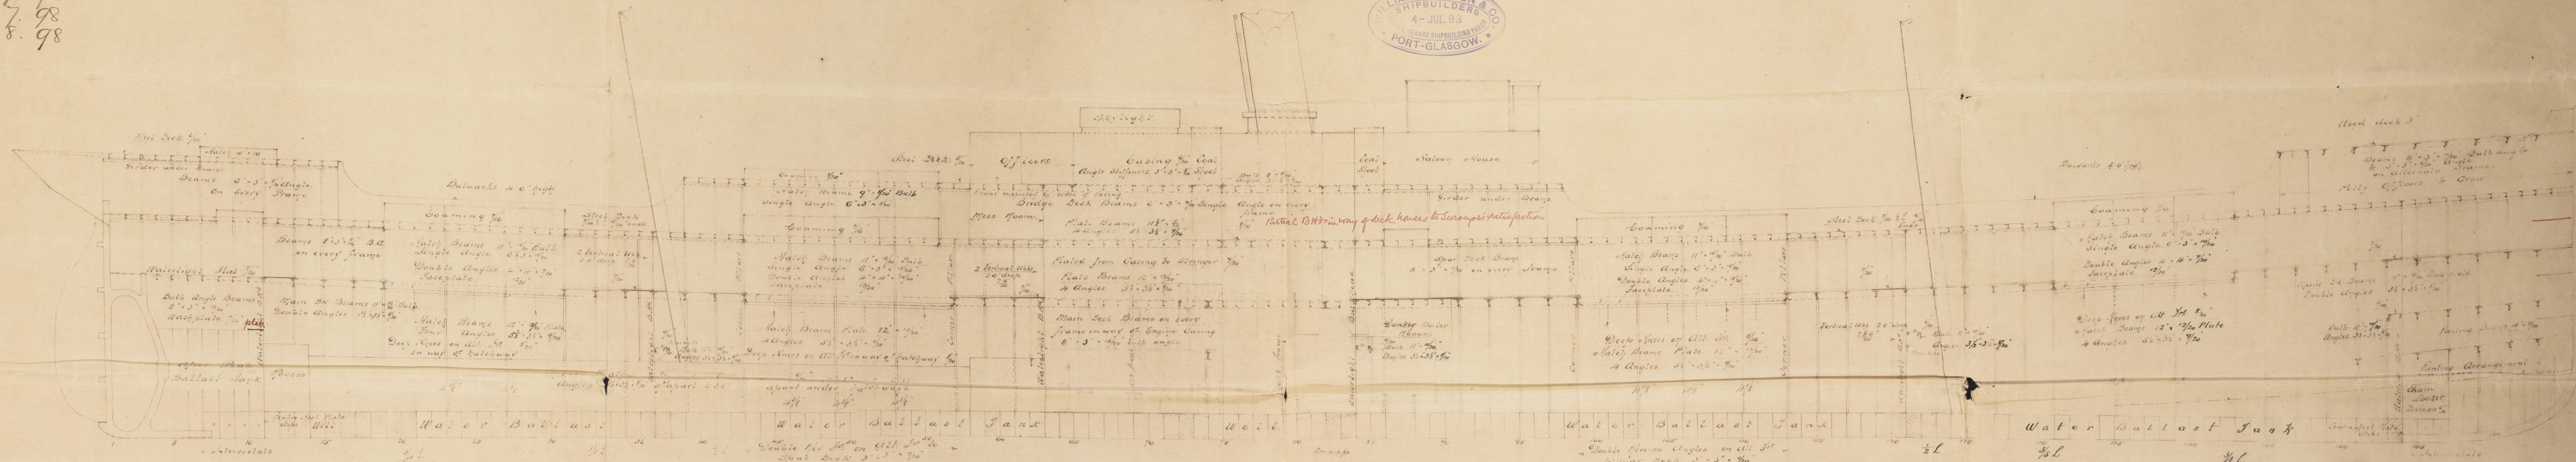

William Hamilton & Co
SHIPBUILDERS
PORT-GLASGOW

Longitudinal Section
Wm Hamilton + C^o 144

S. S. Claverton

Greenock Report N^o 12505-

similar vessel to "S. S. Warfield"
Gr B 12327.

GRK348-0075



© 2021

Lloyd's Register
Foundation