

## Lloyd's Register of British and Foreign Shipping.

(Report on Vessel No. 12505 Port

Greenock)

No. 6561

SHIP FORGINGS OR CASTINGS.

S.S. Claverdon

I have to report that the undermentioned Iron or Steel Forgings or Castings,  
manufactured by The Portland Forge Coy

of

Kilmarnock

for the Vessel No. 144,

being built

by

Messrs Wm Hamilton of

Port Glasgow

have been inspected by me as set forth below, and found to be, so far as can be seen,

Sound &amp; efficient

Mark on Forgings.

Lloyd's

No. 6561


W. H.

William Hamilton

Glasgow 2/12/98

	STERN FRAME.	RUDDER FRAME.	STEM.
Material* ...	Scrap iron		
How made ...	Forged		
Dimensions ...	10 4 6		
Progress on Inspection	Forging & smithing		
Date when Inspected	30/9/98 to 1/12/98		

SKETCHES OF FRAMES SHOWING POSITION AND DESCRIPTION OF WELDS OF FORGINGS, OR PARTICULARS OF TESTS APPLIED TO CASTINGS.

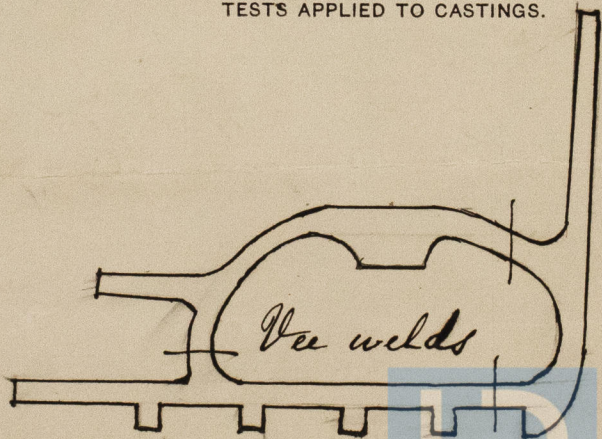

Fee (if any chargeable) £

To be paid at