

14.11.98  
13.1.99



# Longitudinal Section & Deck Plans

F. J. 76 151 & 2.


DIMENSIONS. 330' x 45' 6" x 26' 6" to SPAR DECK.

CLASS 100 H. SPAR DECK WITH FREEBOARD.

Scale 8 Inch = 1 Foot.

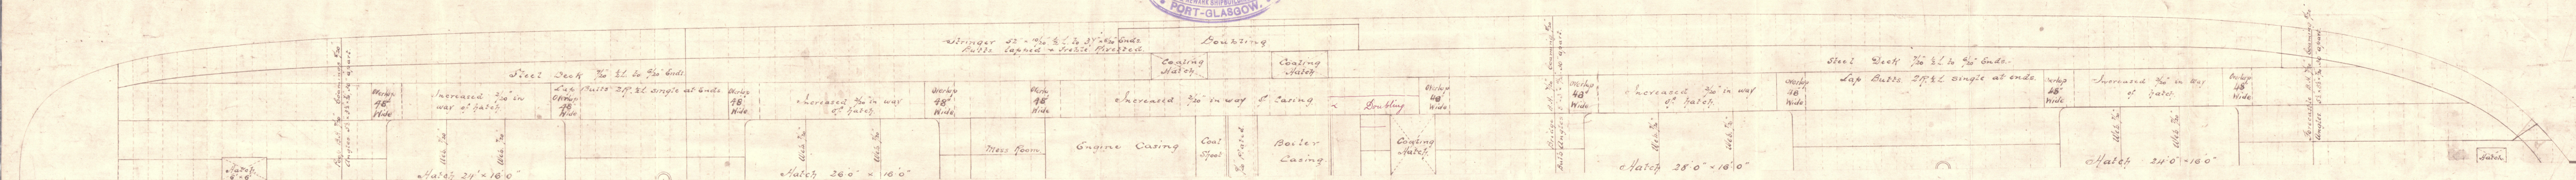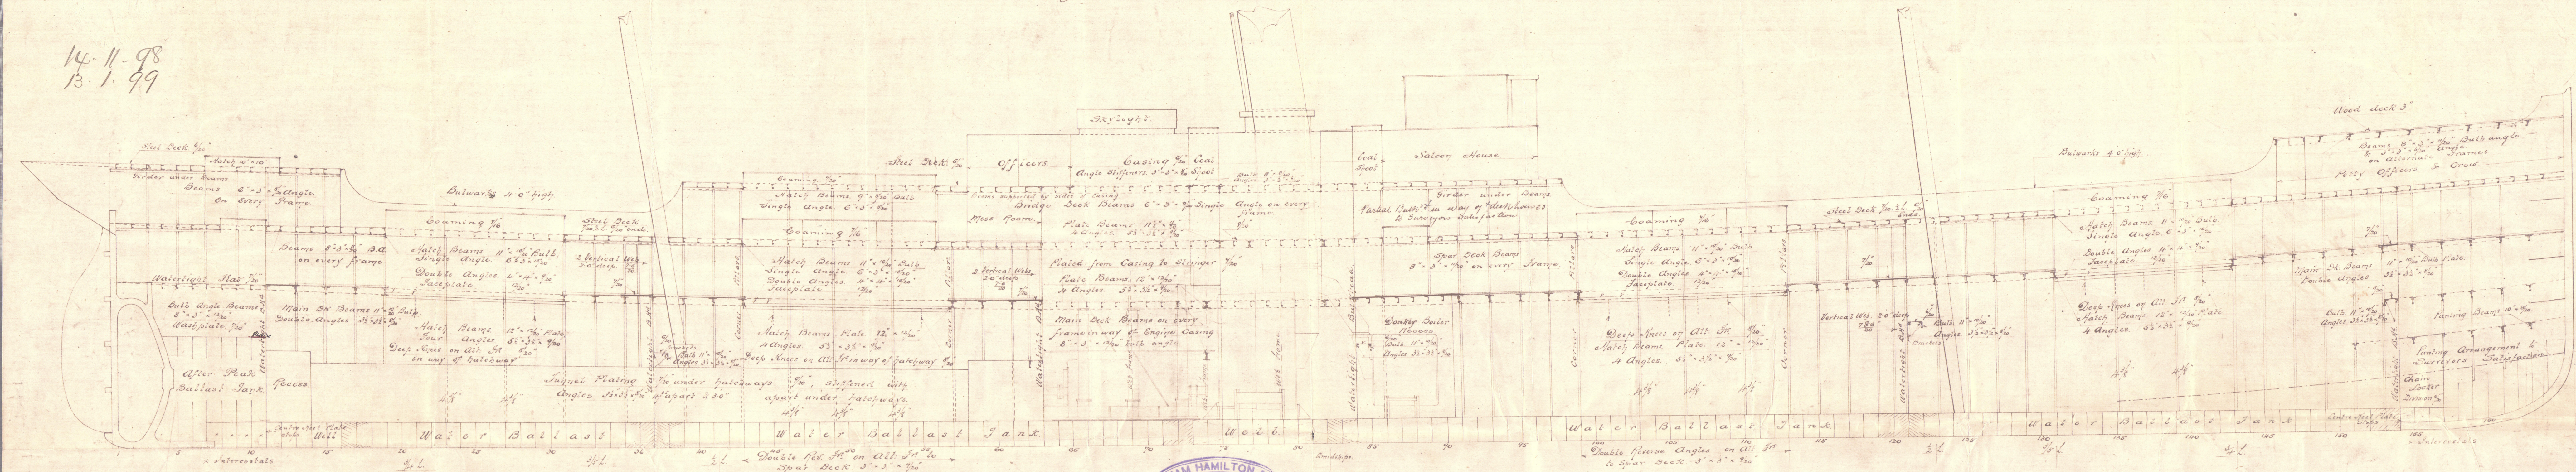

SPAR DECK PLAN.

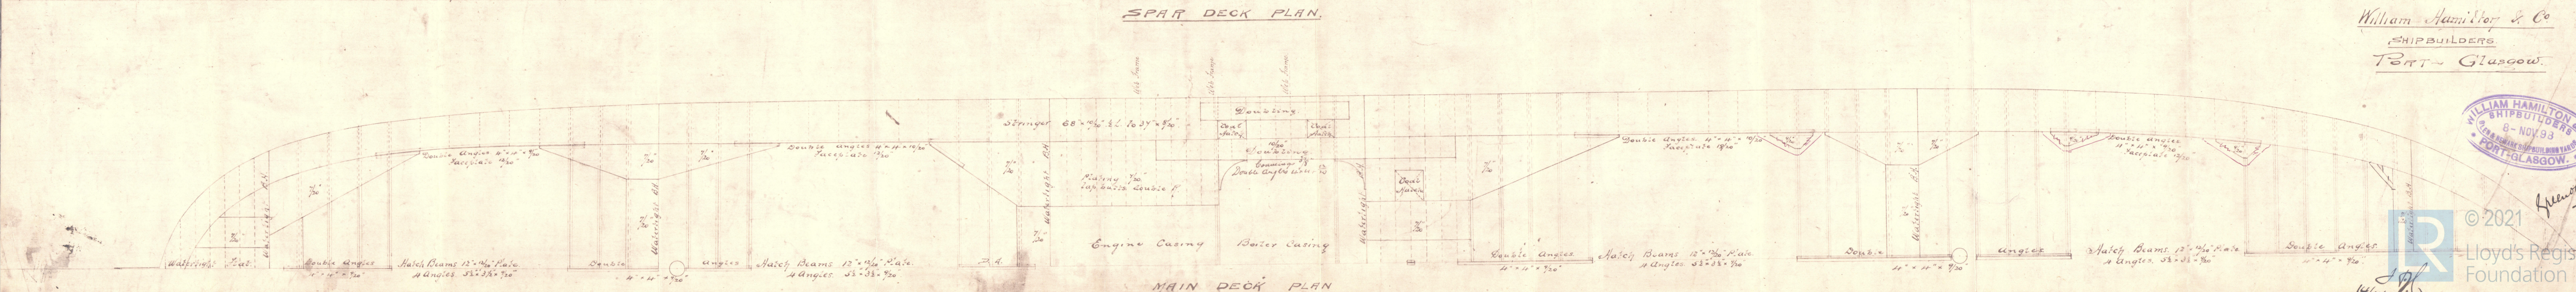

MAIN DECK PLAN

William Hamilton & Co.  
SHIPBUILDERS.  
PORT-GLASGOW.



© 2021  
Lloyd's Register  
Foundation  
GRK348-0114



Longitudinal Section

W<sup>th</sup> Hamilton & Co Nos 15-142.



S.S. "Adato"

GRK Report No 12515

S.S. "Quito"

GRK Report No 12651

taken out of Adato  
bag

GRK 348-0114

© 2021

Lloyd's Register  
Foundation

