

Lloyd's Register of British and Foreign Shipping.

(Report on Vessel No. 12513 Port

Greenock.)

S.S. 'Adato'

No. 6792

SHIP FORGINGS OR CASTINGS.

I have to report that the undermentioned Iron or Steel Forgings or Castings, manufactured by Messrs Matthew Reid & Co of Kilmarnock for the Vessel No. 157, being built by Messrs William Hamilton & Co of Port Glasgow have been inspected by me as set forth below, and found to be, so far as can be seen, Sound & efficient

Forgings.


No. 6792

FC

William Hamilton
Frank Cook. Glasgow 1/3/99

	STERN FRAME.	RUDDER FRAME.	STEM.
Material* ...	Scrap iron		
How made ...	Forged		
Dimensions ...	10 1/2 ft		
Progress on Inspection	Forging & smithing		
Date when Inspected	9/1/99 to 23/2/99		

SKETCHES OF FRAMES SHOWING POSITION AND DESCRIPTION OF WELDS OF FORGINGS, OR PARTICULARS OF TESTS APPLIED TO CASTINGS.

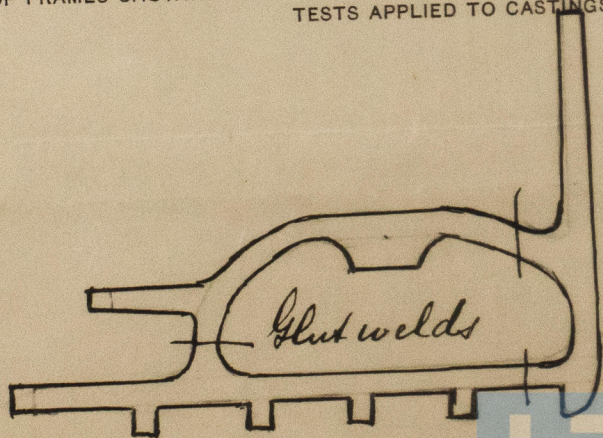

Fee (if any chargeable) £

To be paid at

* If of Iron, state whether scrap or puddled Iron.