





Lloyds' Approved.


Proposed 450' x 54' x 34' 6"

(Midship Section)

Caird & Co No 292 & 3.




SS Assurance

Grk 12560


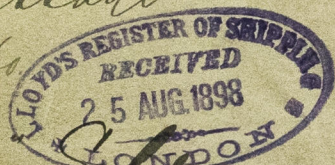


SS Soltau

Grk Report No 12642

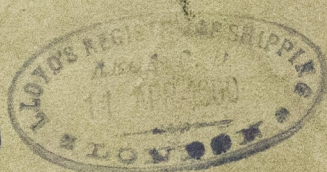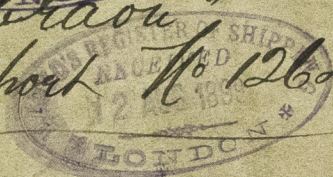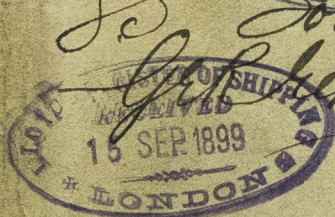

GRK349-0156

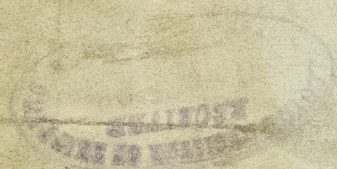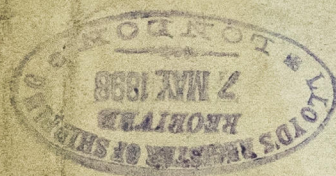

© 2020

Lloyds Register Foundation