

 


17-2-98 No 292-3, II
 15-8-99
 Steel Screw Steamer
 Mid. dims = 450' x 54' x 34'-6"
 Scale - 1/8 inch = one foot.
 See new plans
 app. 19/9/99

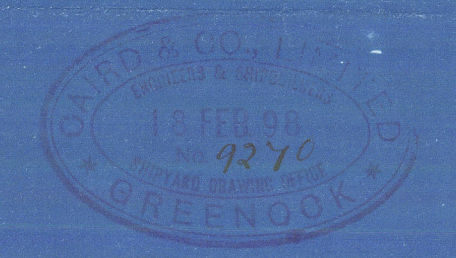

Longitudinal Section

 

Upper Deck plan

Main Deck plan

Lloyds Approved.
Proposed 450' x 54' x 34'-6"

Longitudinal Section
Caired & Co. No. 292 & 3



No. 292. J.S.S. ~~Design~~
Greenock Report No. 12860



No. 293. J.S.S. "Solraou"
GRK Report No. 12642

GRK 349-0160



© 2020

Lloyd's Register
Foundation