
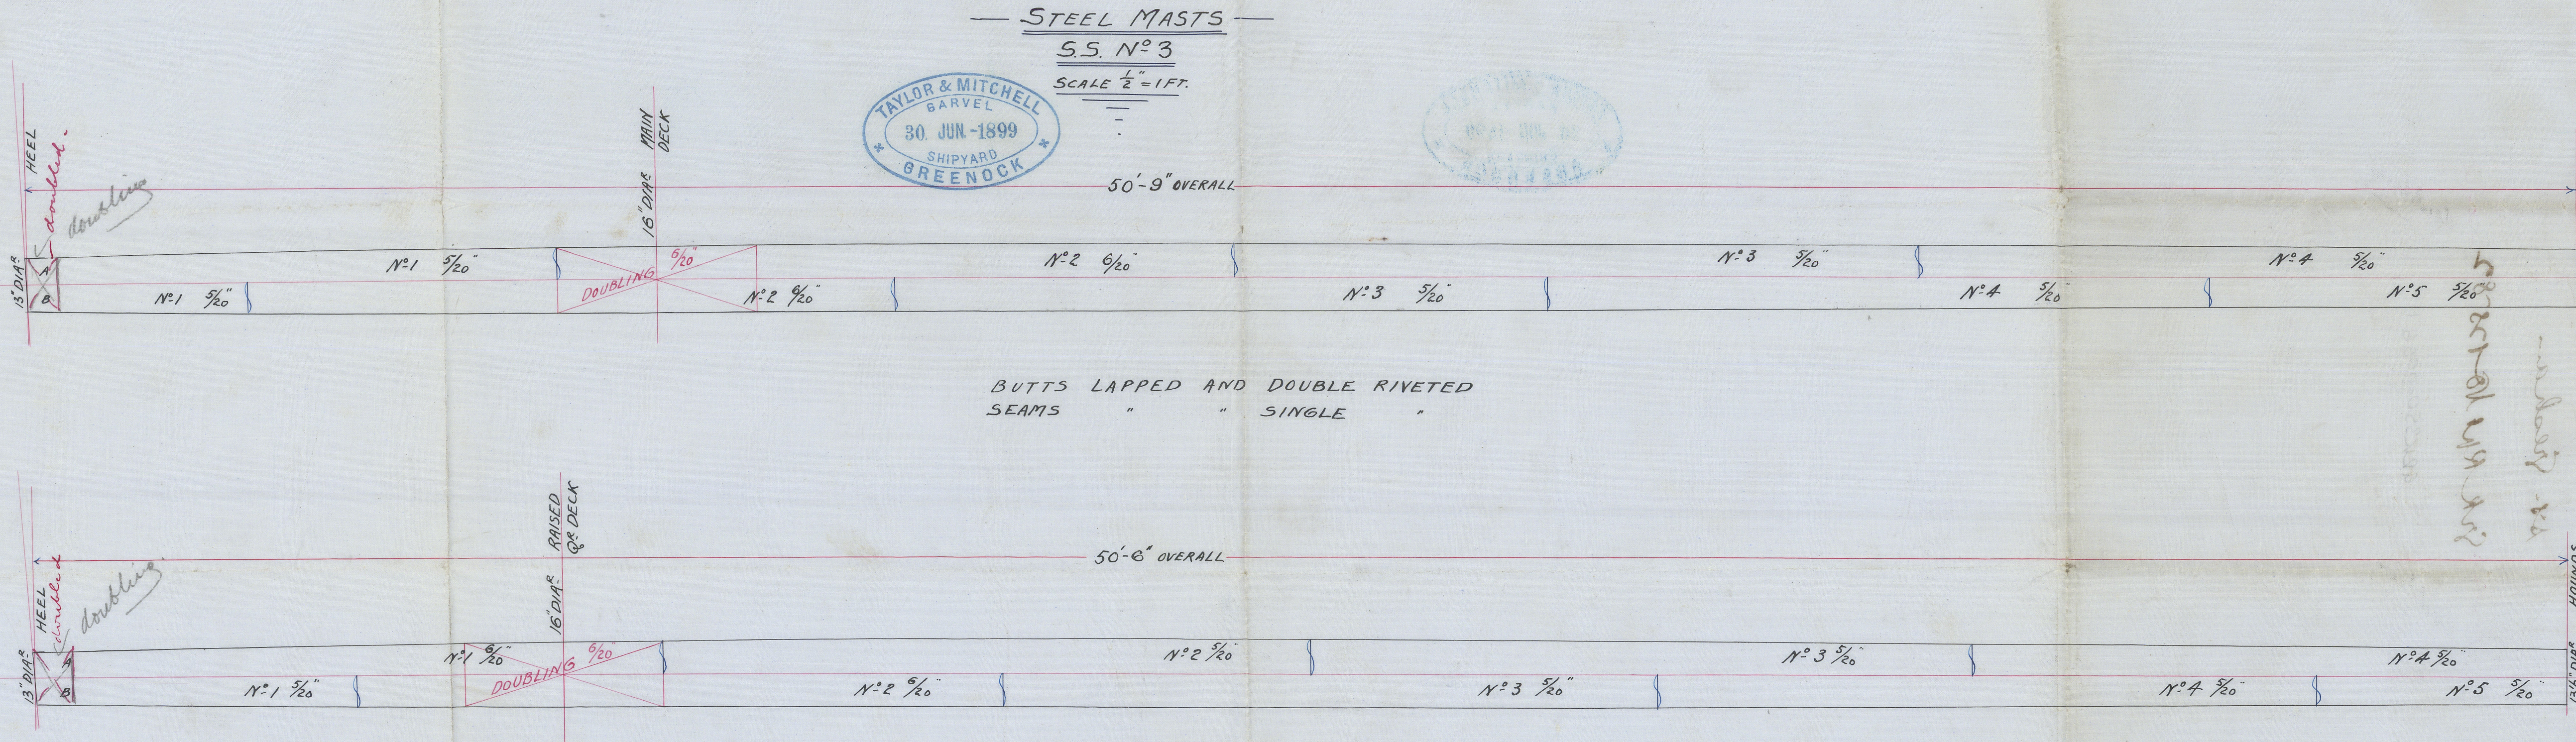
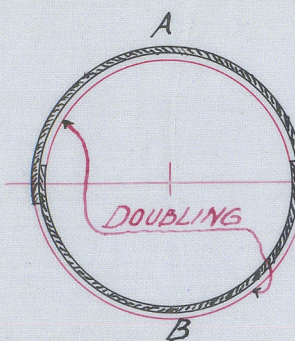


10-7-99

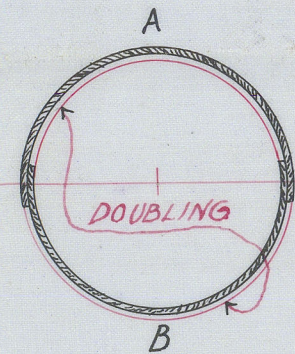

FORE MAST

MAIN MAST

J.T.L.
9/7/99

plan of masts

Taylor & Mitchell No 3

See amended plan

SS. Fresham

SRK Rm No 125-82

GRK350-0056.1



© 2020

Lloyd's Register
Foundation